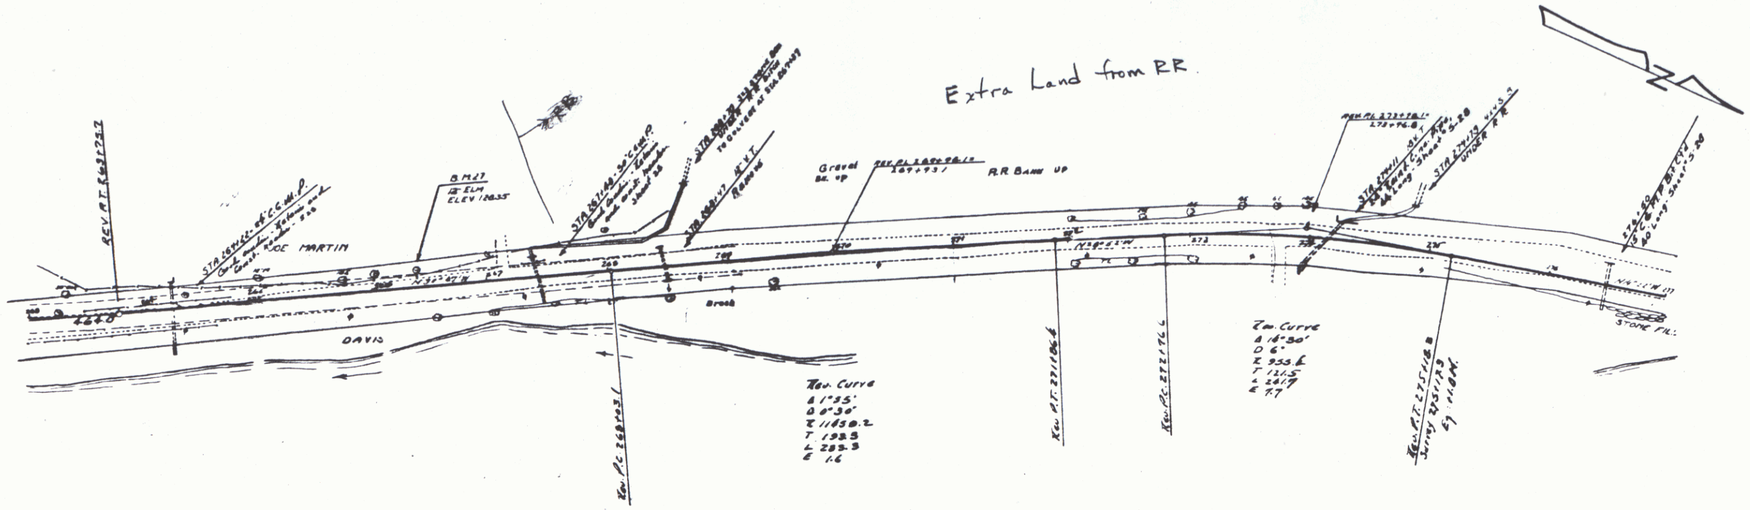
Extra Land from RR
RR Bank up
Gravel
Brook
DAVIS
MARTIN
Rev. Curve
Δ 1°35'
D 8°30'
R 1150.2
T 192.5
L 283.3
E 1.6
Rev. Curve
Δ 6°30'
D 6°
R 955.6
T 121.5
L 241.7
E 7.7
Stone Fil.

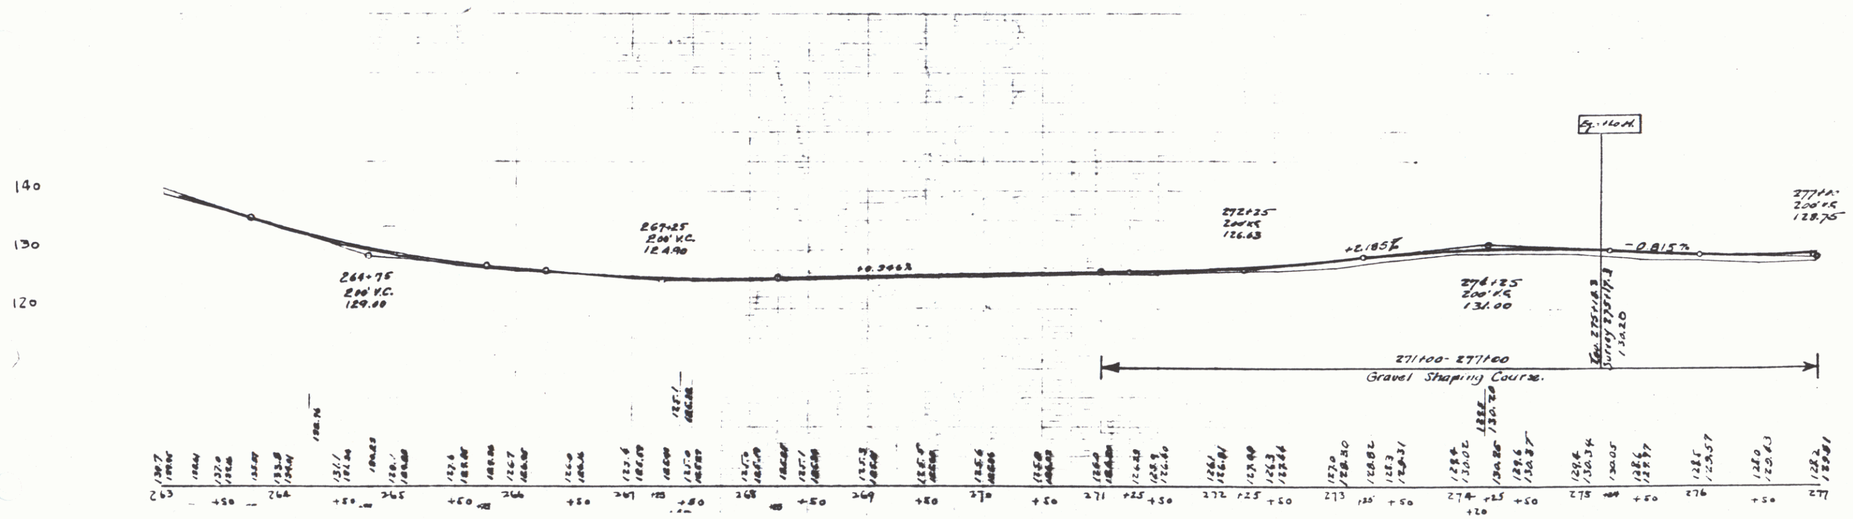
140
130
120
Sy. 140A
264+75
200' V.C.
129.00
267+25
200' V.C.
128.90
+0.396%
272+25
200' V.C.
126.63
+2.185%
-0.815%
274+25
200' V.C.
131.00
277+25
200' V.C.
128.75
271+00 - 277+00
Gravel Shaping Course.

11