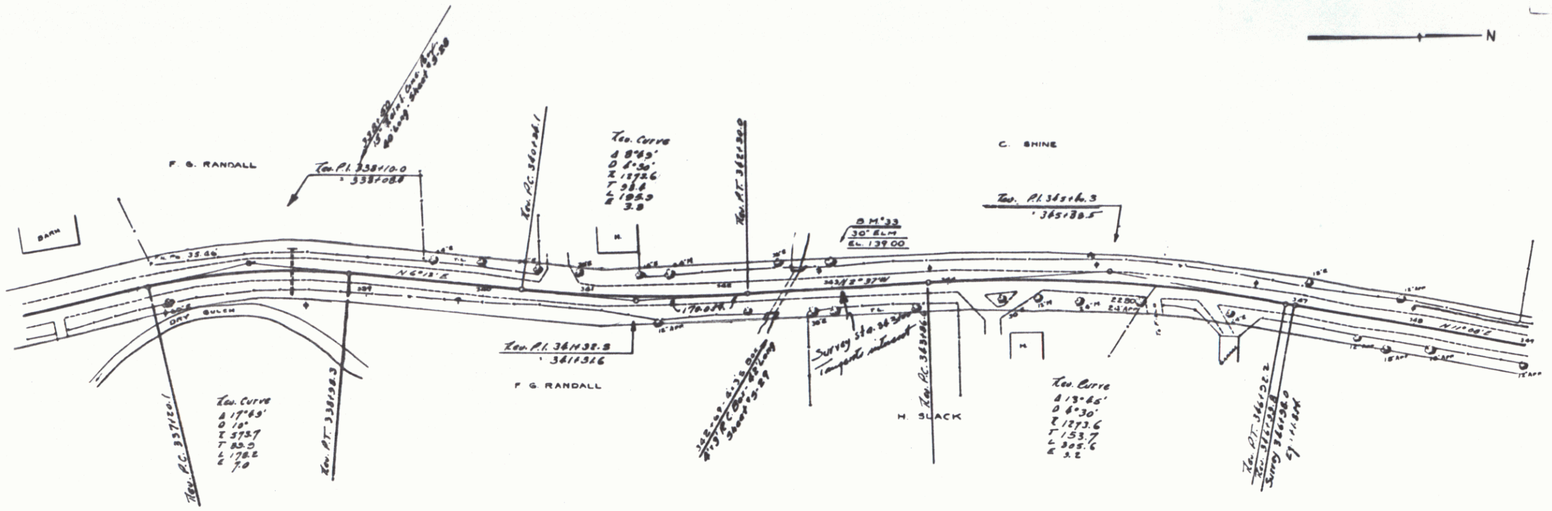

Old Grade	New Grade
342+28	342+25
250' V.C.	250' V.C.
139.90	140.80

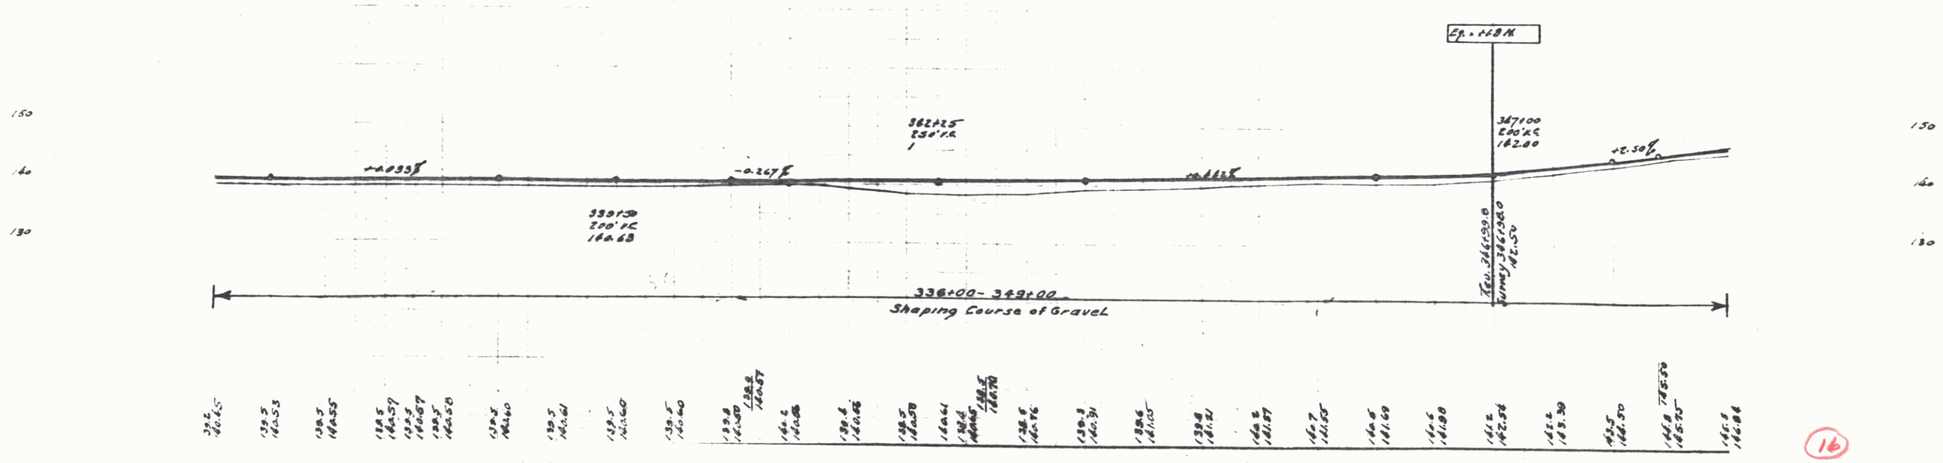

16

15