STATE
159-L 1936 7 26

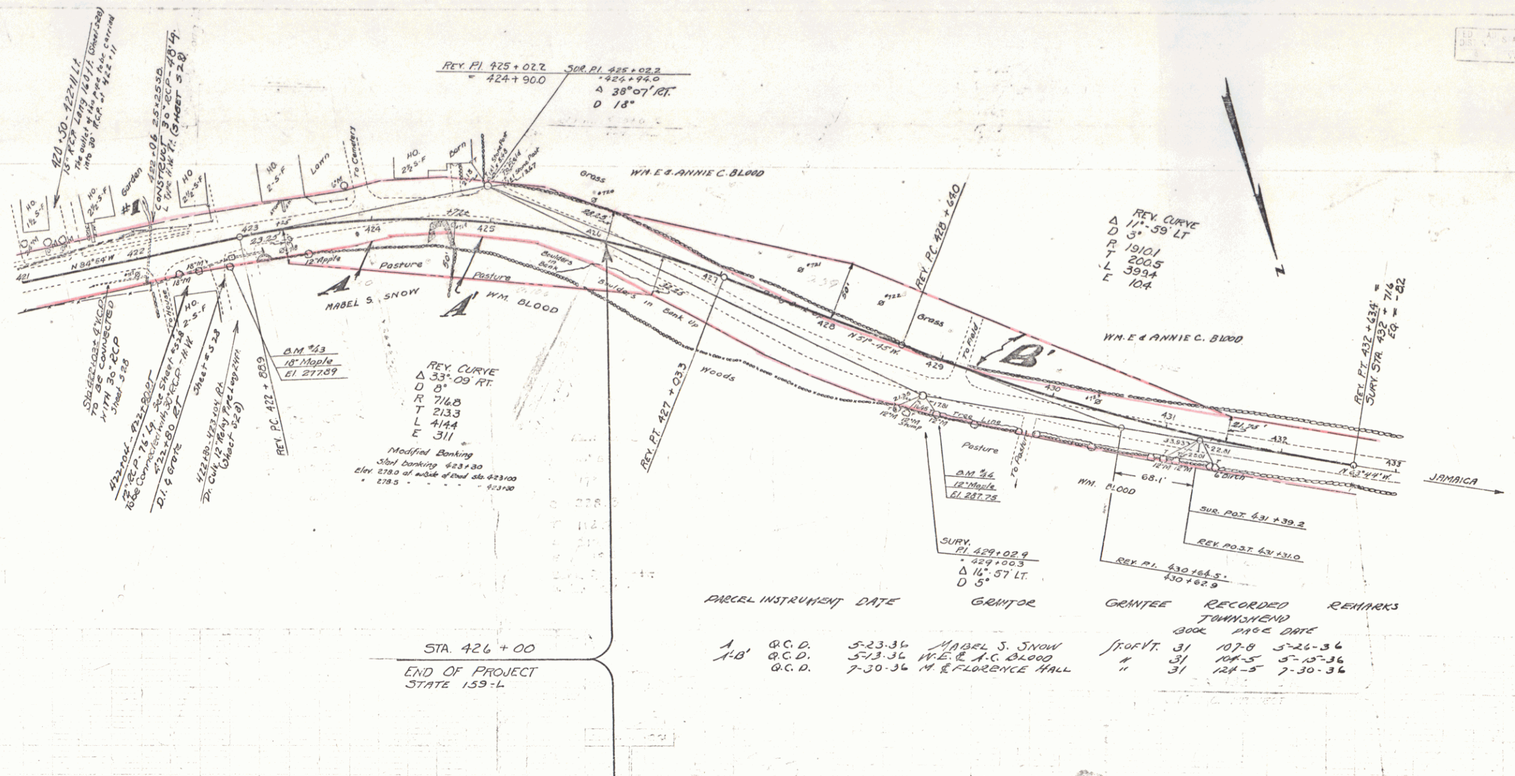

5