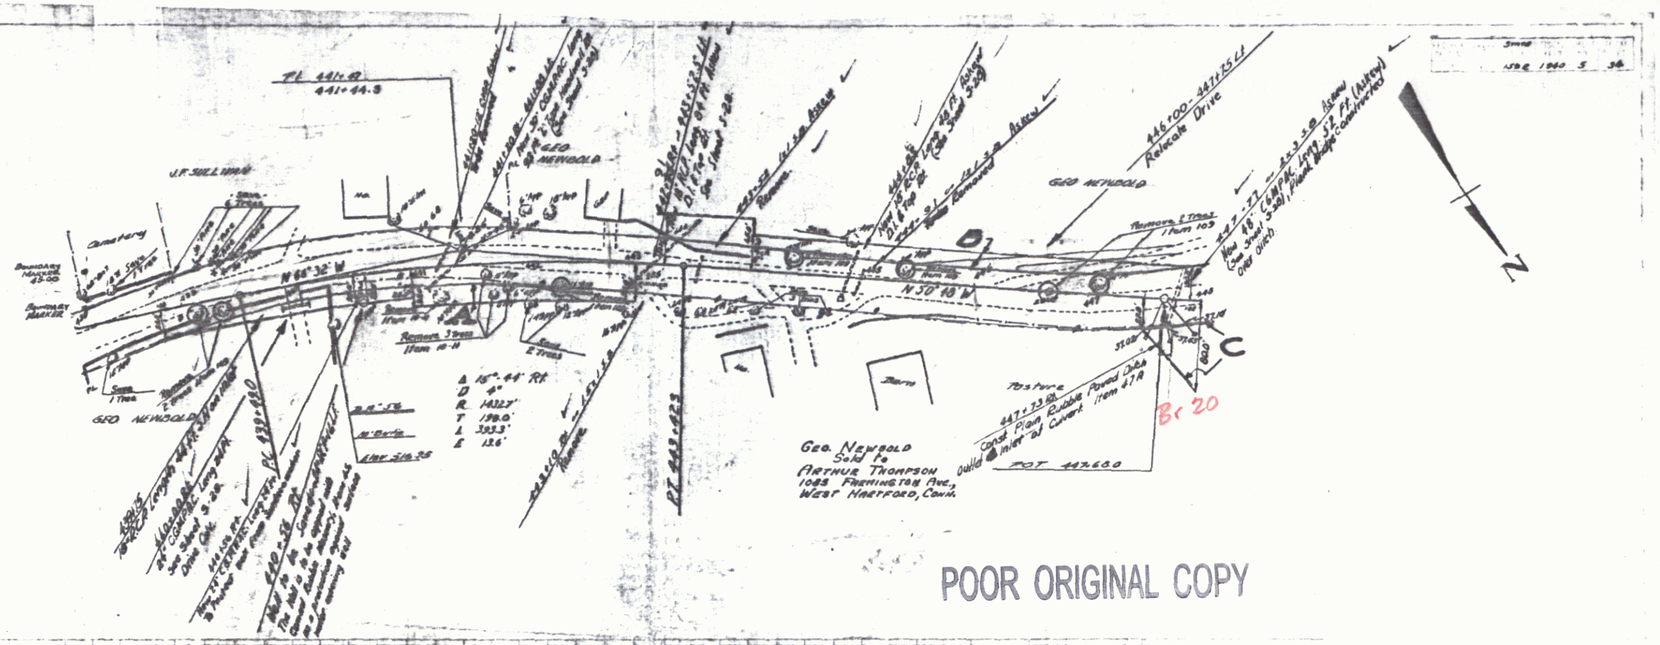

POOR ORIGINAL COPY

Parcel	Instrument	Date	Grantor	Grantee	Recorded Book	Recorded Page	Recorded Date	Remarks
4050	QCD	12-31-38	George Newbold	Stafff.	31	397-99	1-2-39	Cal 938125 + 996160

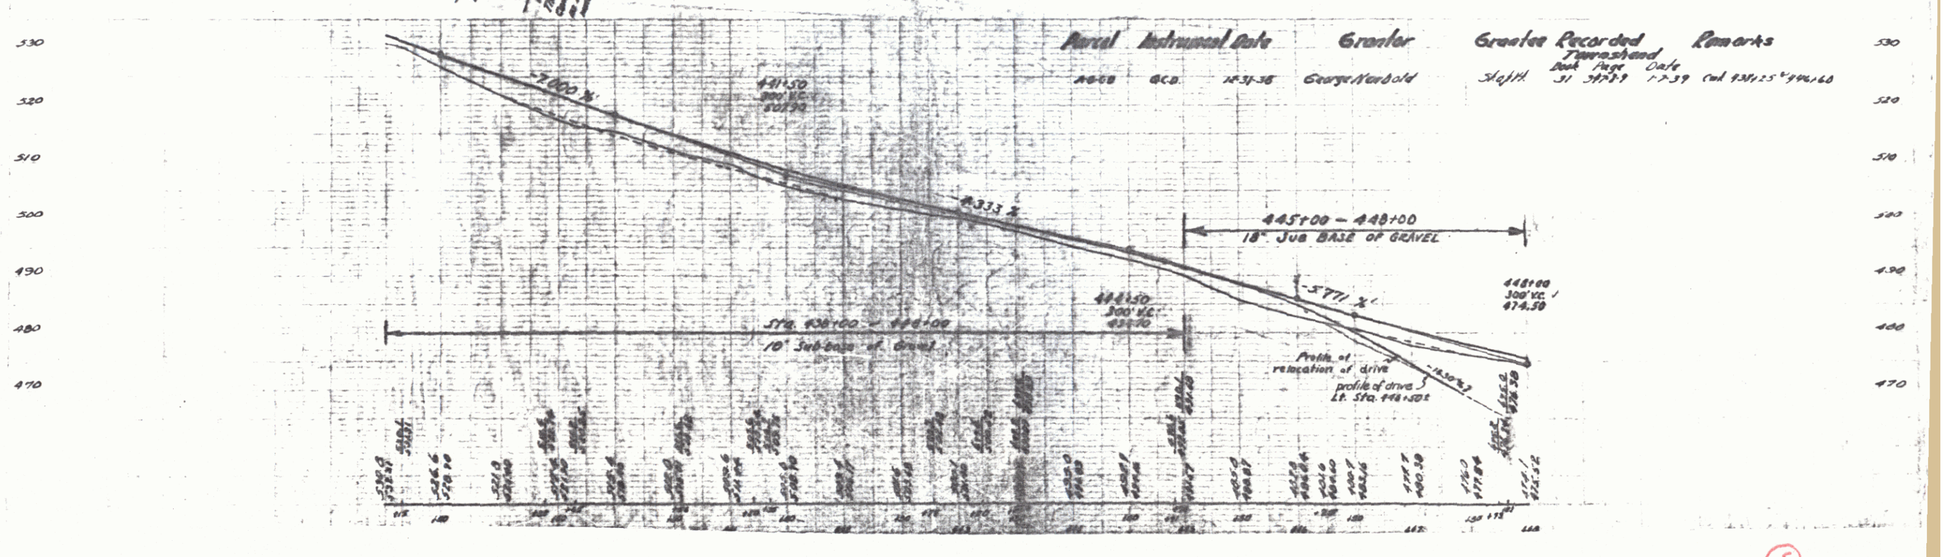

5

3