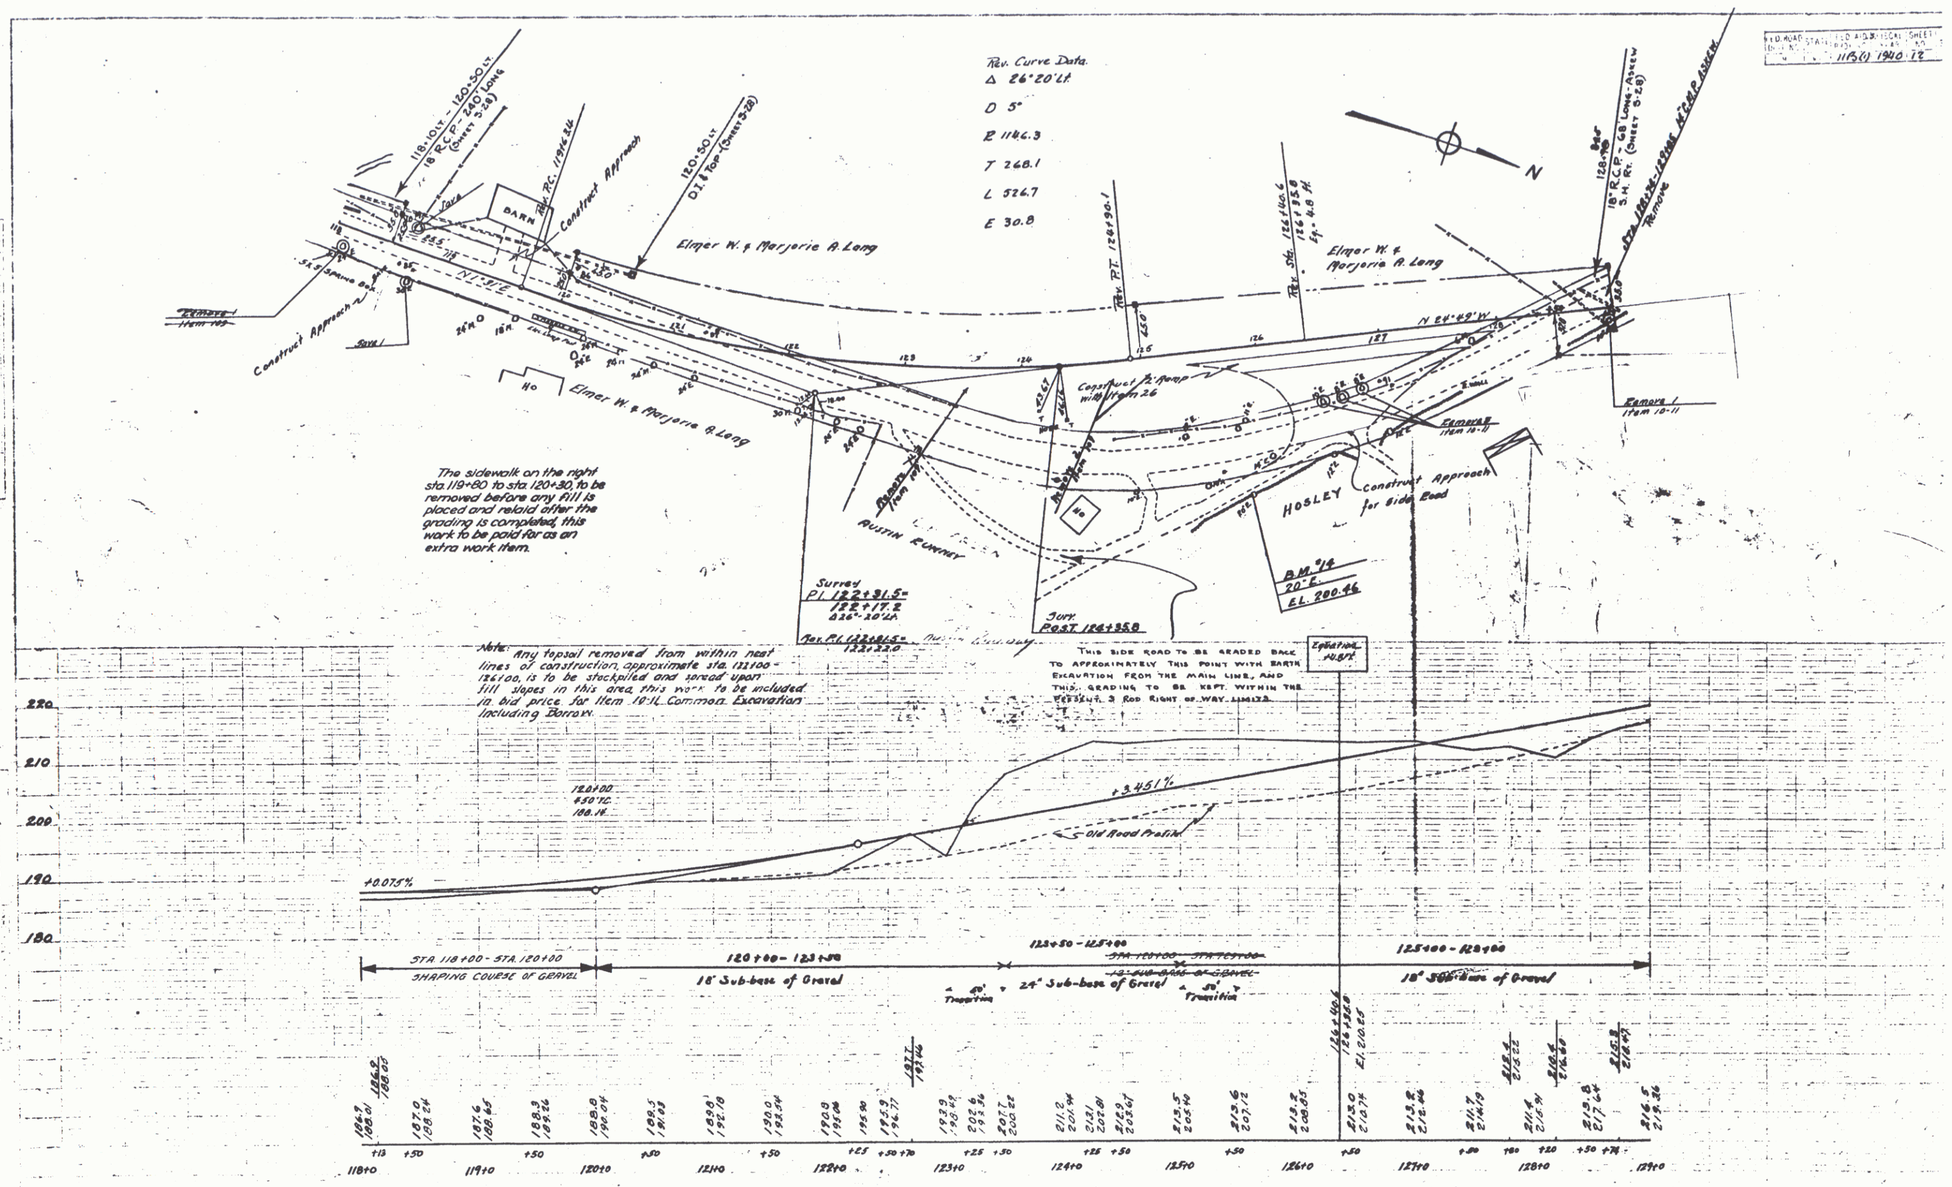

B.M. #14 SPIKE IN TRUNK 20" ELM 130' RT. STA. 125+88 ELEV. 200.46

SERIES 7AS No. 11(B)(1)
SHEET (12) of 74

10