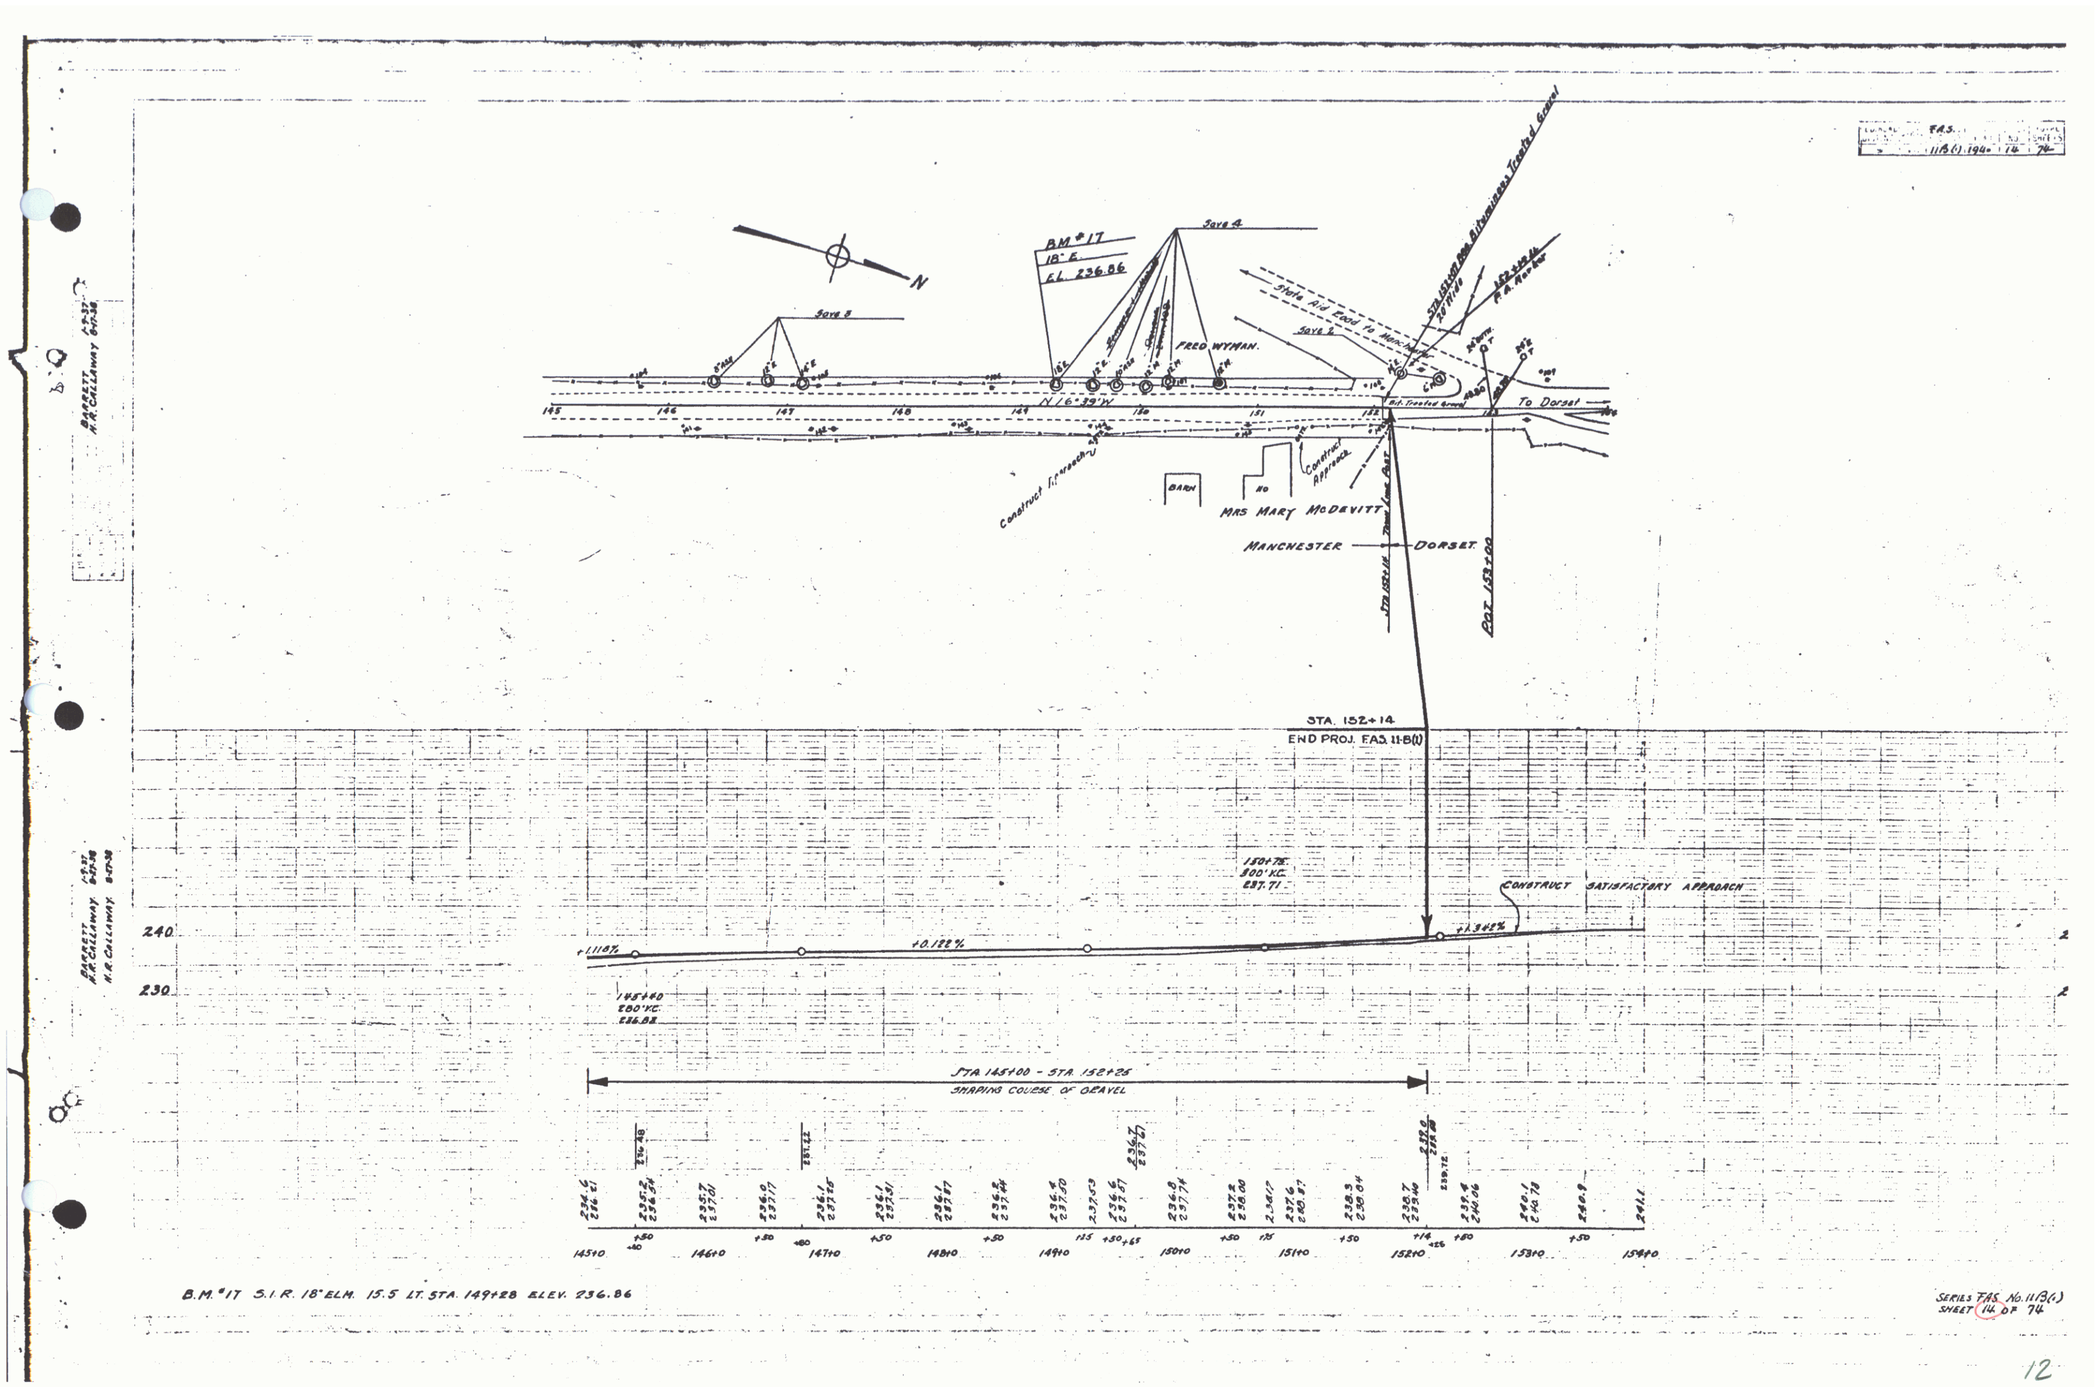
F.A.S.
11B(1) 1940 14 74
N
BM #17
18" E.
EL. 236.86
Save 4
Save 3
Save 2
FRED WYMAN
N 16° 39' W
To Dorset
Construct Approach
BARN
MRS MARY McDEVITT
MANCHESTER — DORSET
STA. 152+14
END PROJ. FAS 11-B(1)
CONSTRUCT SATISFACTORY APPROACH
+0.188%
+1.348%
145+40
280' VC.
236.82
STA. 145+00 - STA. 152+25
SHAPING COURSE OF GRAVEL
B.M. #17 5.1 R. 18" ELM. 15.5 LT. STA. 149+28 ELEV. 236.86
SERIES FAS No. 11B(1)
SHEET 14 OF 74
12