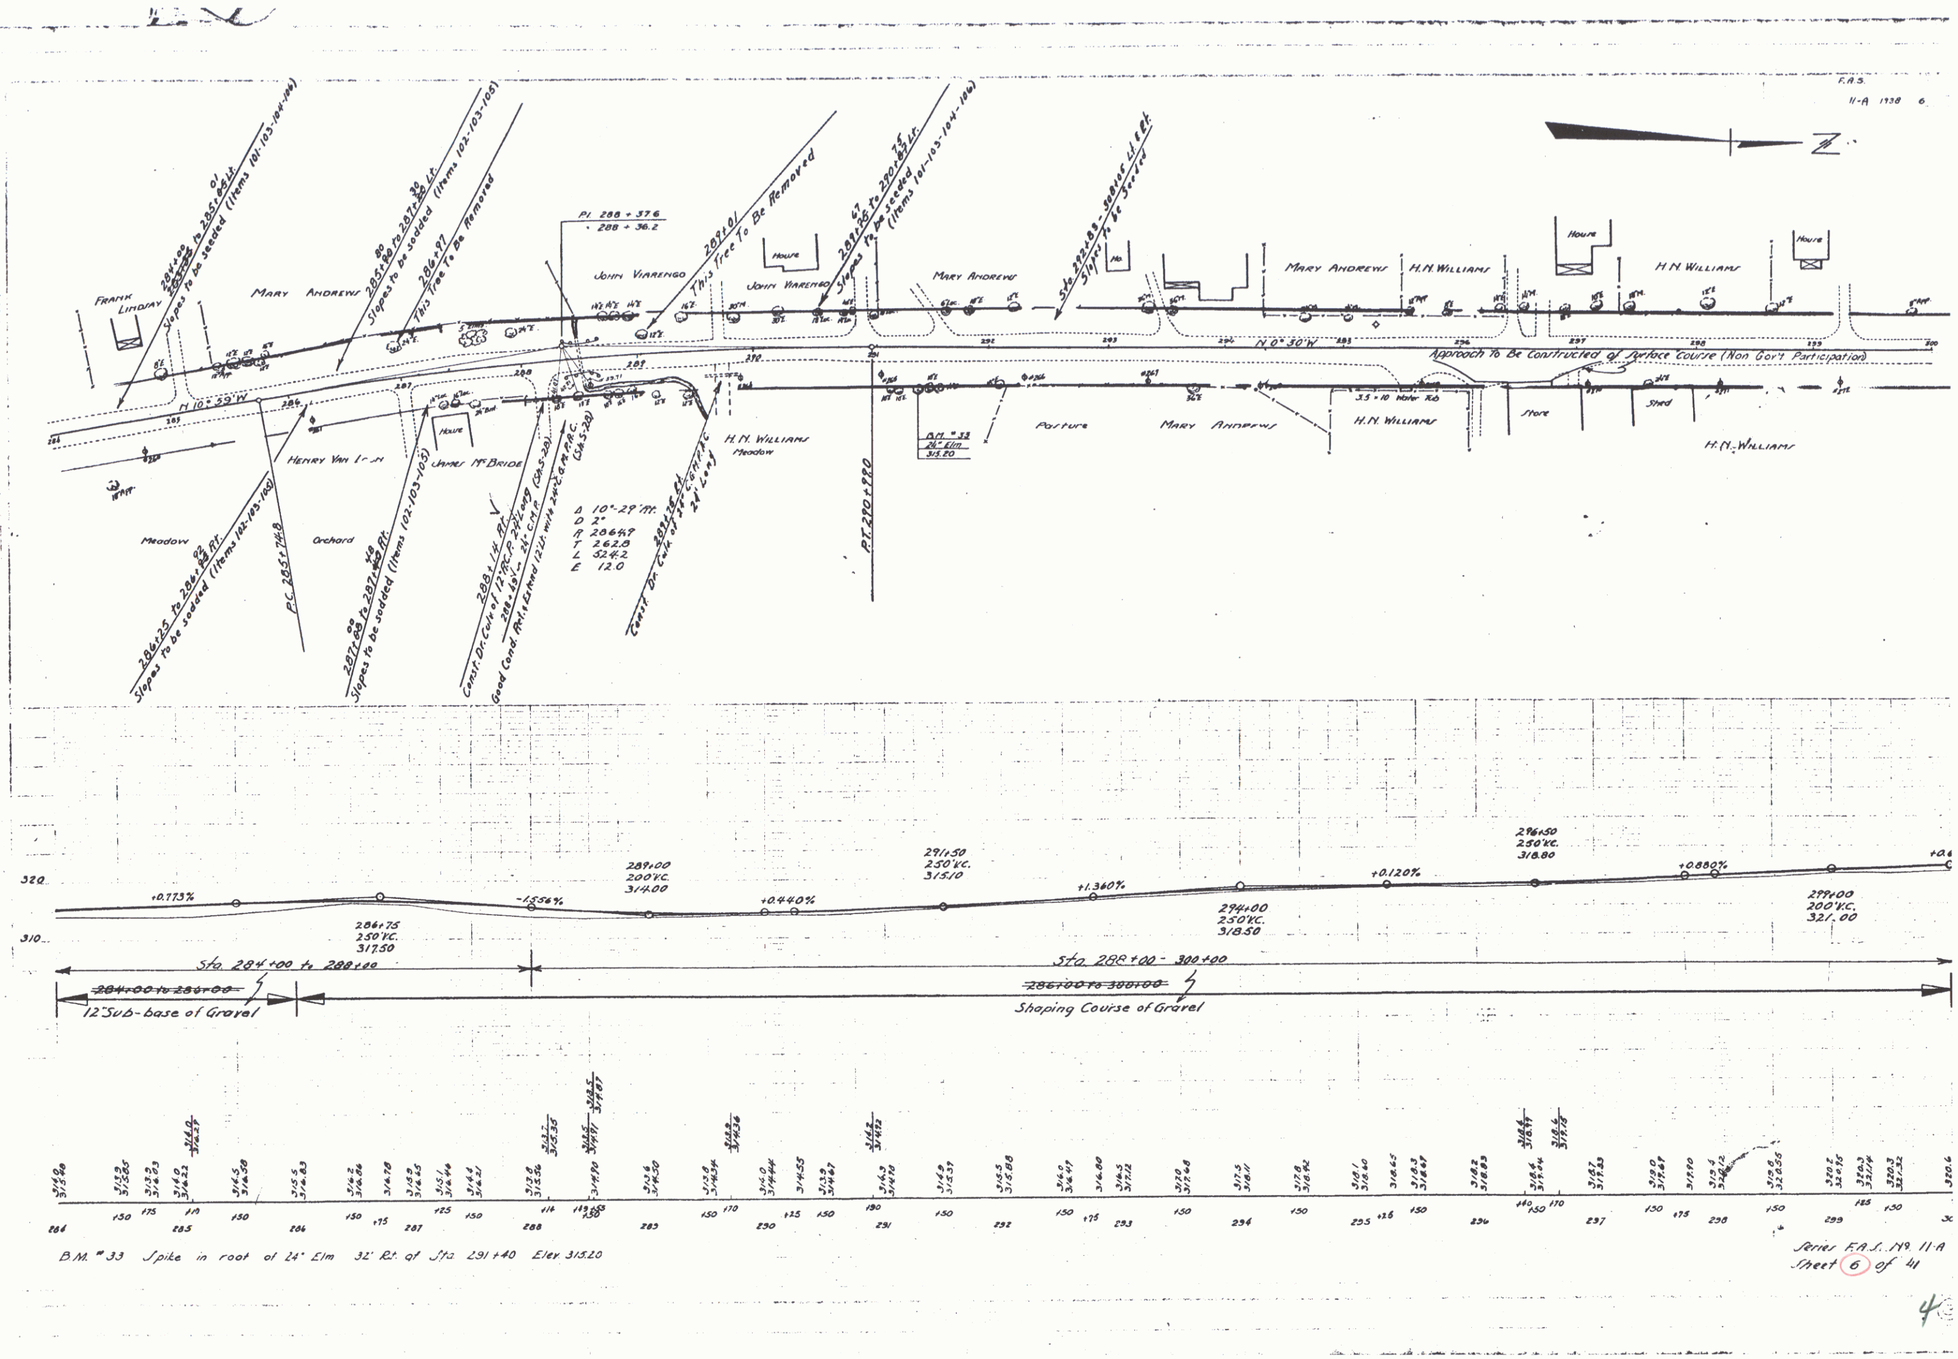
F.A.S.
11-A 1938 6
N
Frank Lindsay
Mary Andrews
John Viarengo
Mary Andrews
H.N. Williams
Mary Andrews
H.N. Williams
House
Slopes to be seeded (Items 101-103-104-106)
This tree to be Removed
Slopes to be seeded (Items 102-103-105)
Slopes to be Sodded
PI 288 + 37.6
288 + 36.2
N 10° 29' W
N 0° 30' W
Approach To Be Constructed of Surface Course (Non Gov't Participation)
Henry Van Ness
James McBride
Meadow
Orchard
H.N. Williams Meadow
Pasture
Mary Andrews
H.N. Williams
3.5 × 10 Water Tab
Store
Shed
H.N. Williams
P.C. 285+74.8
P.T. 290+29.8
Δ 10°-29' Rt.
D 2°
R 2864.9
T 262.8
L 524.2
E 12.0
B.M. = 53
24" Elm
315.20
+0.773%
-1.556%
+0.440%
+1.360%
+0.120%
+0.880%
286+75
250' V.C.
317.50
289+00
200' V.C.
314.00
291+50
250' V.C.
315.10
294+00
250' V.C.
318.50
296+50
250' V.C.
318.80
299+00
200' V.C.
321.00
Sta 284+00 to 288+00
Sta 288+00 - 300+00
12" Sub-base of Gravel
Shaping Course of Gravel
B.M. # 33 Spike in root of 24" Elm 32' Rt. of Sta 291+40 Elev 315.20
Series F.A.S. 149 11-A
Sheet 6 of 41