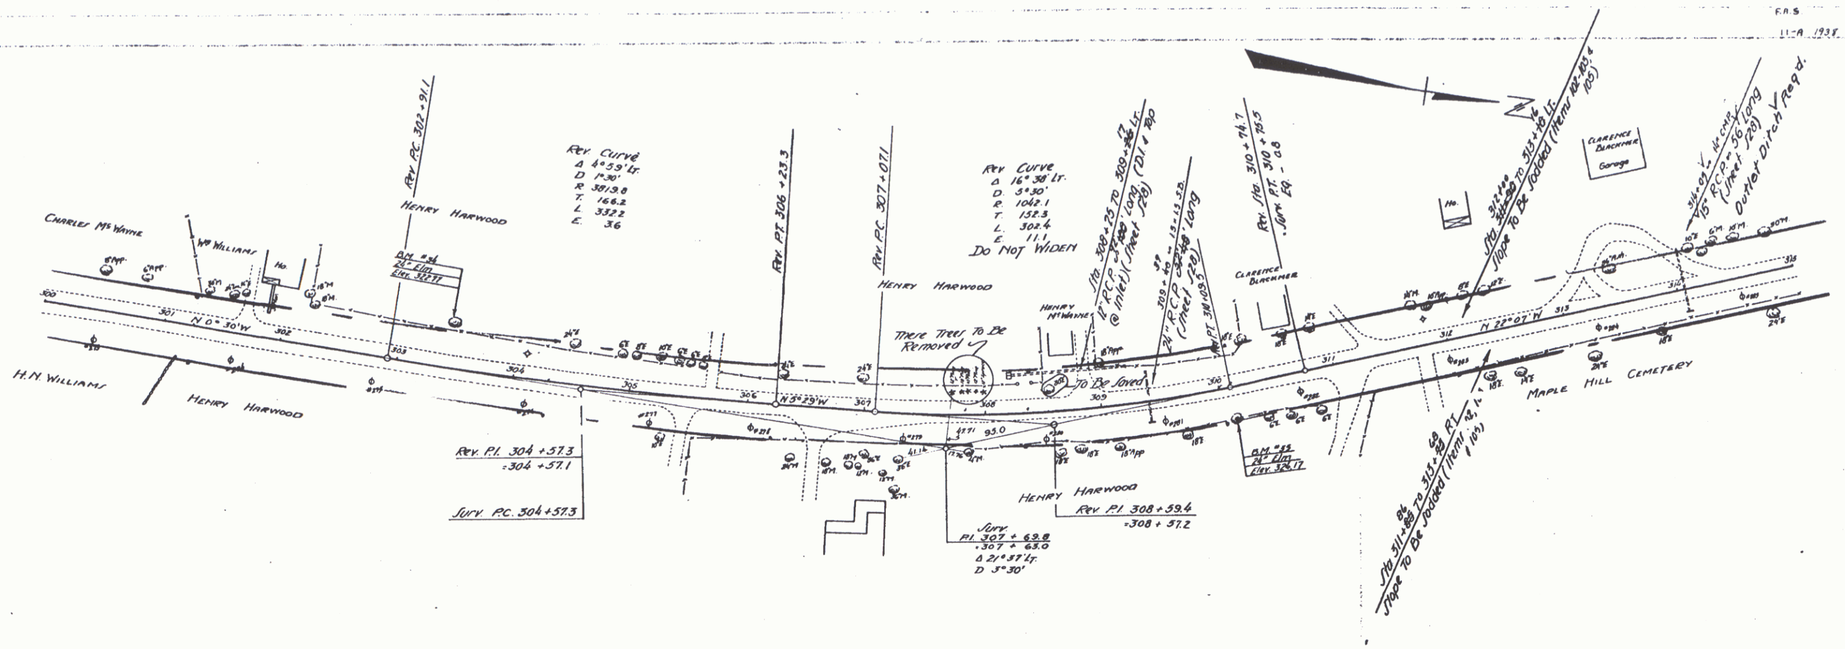

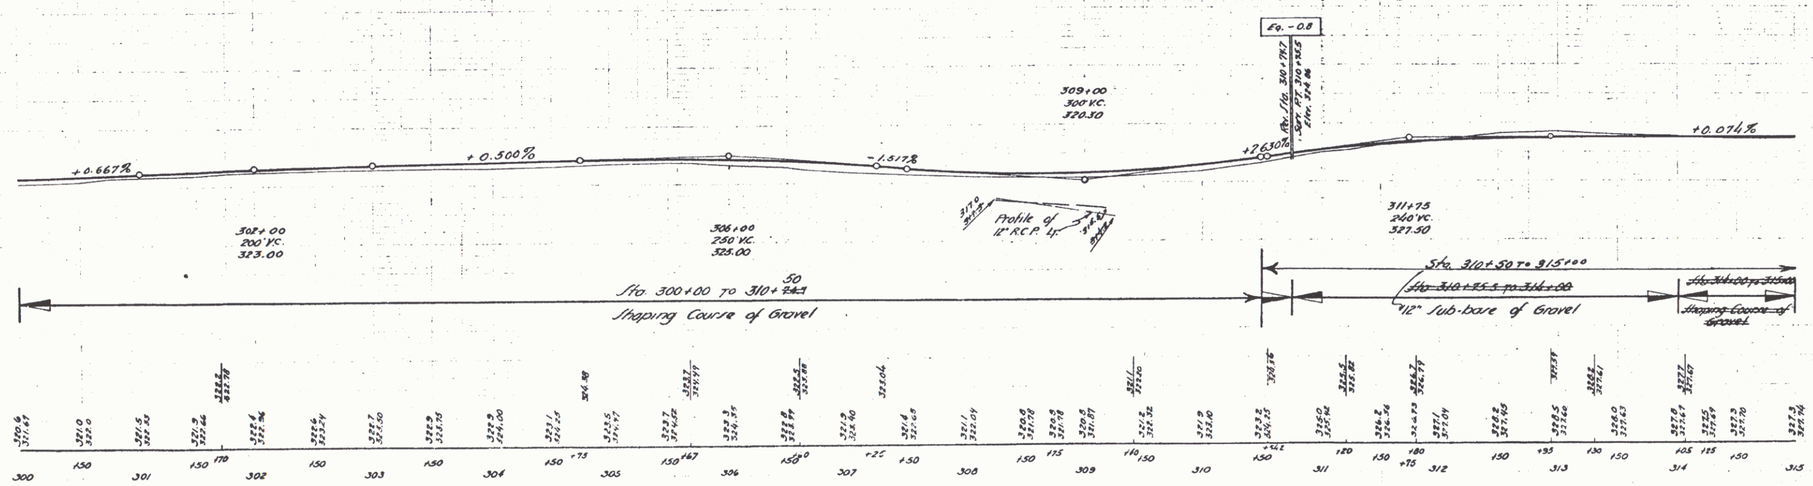

BM # 34 Spike in root of 24" Elm 35' Lt. of Sta. 303+42 Elev. 322.77

B.M. # 35 Spike in root of 24" Elm 25' Rt. of Sta. 310+10 Elev. 324.17

Series F.A.S. No 11-A
Sheet 7 of 41

5.