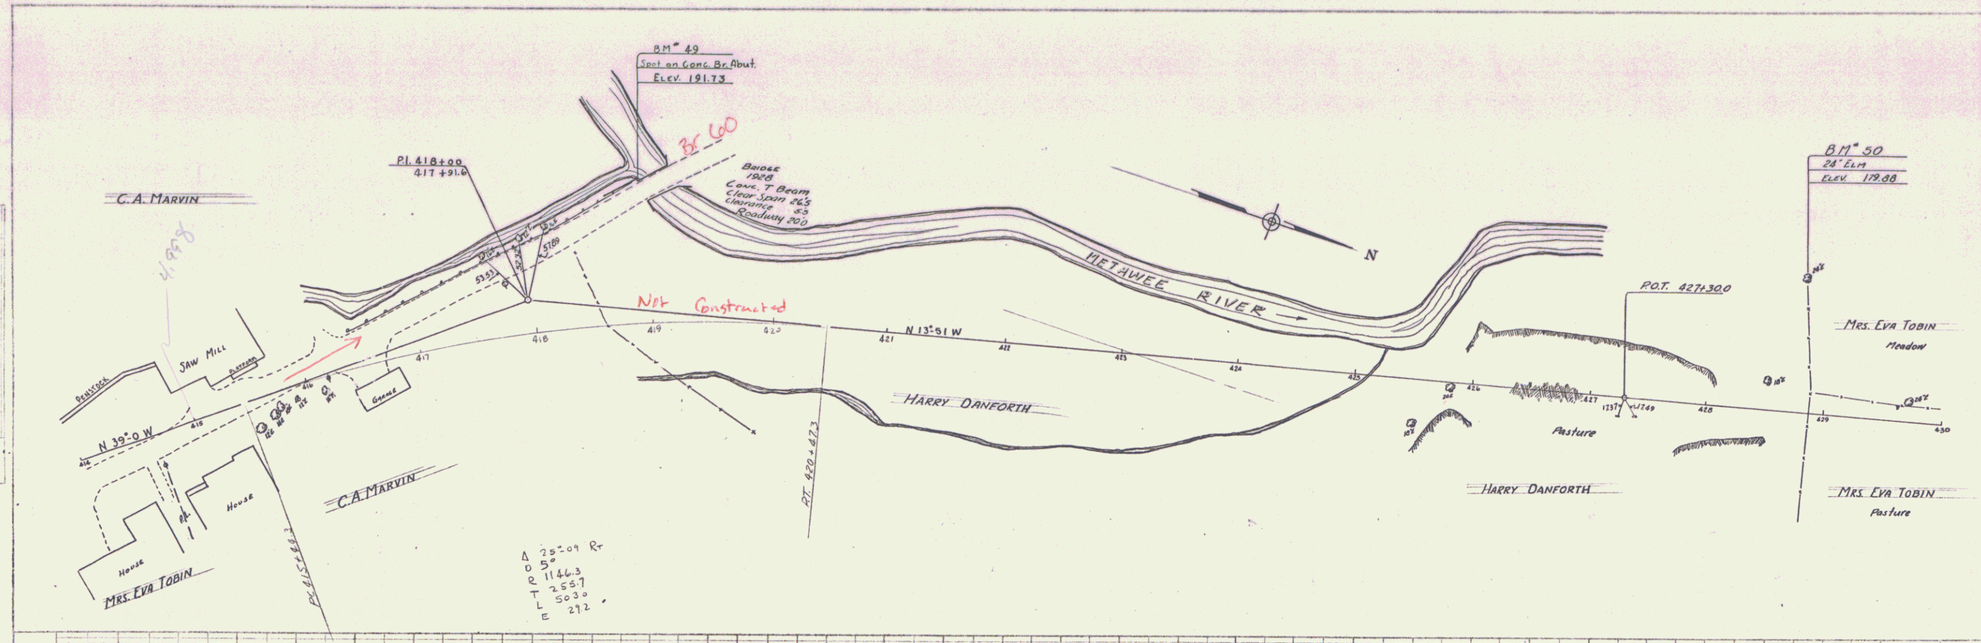


BM # 49 Spot on Conc. Bridge Abut 122 Lt. Sta. 417+90 Elev. 191.73
BM # 50 Spike in Root 20" Elm 112.5 Lt. Sta. 428+77 Elev. 179.88

SHEET 3

4