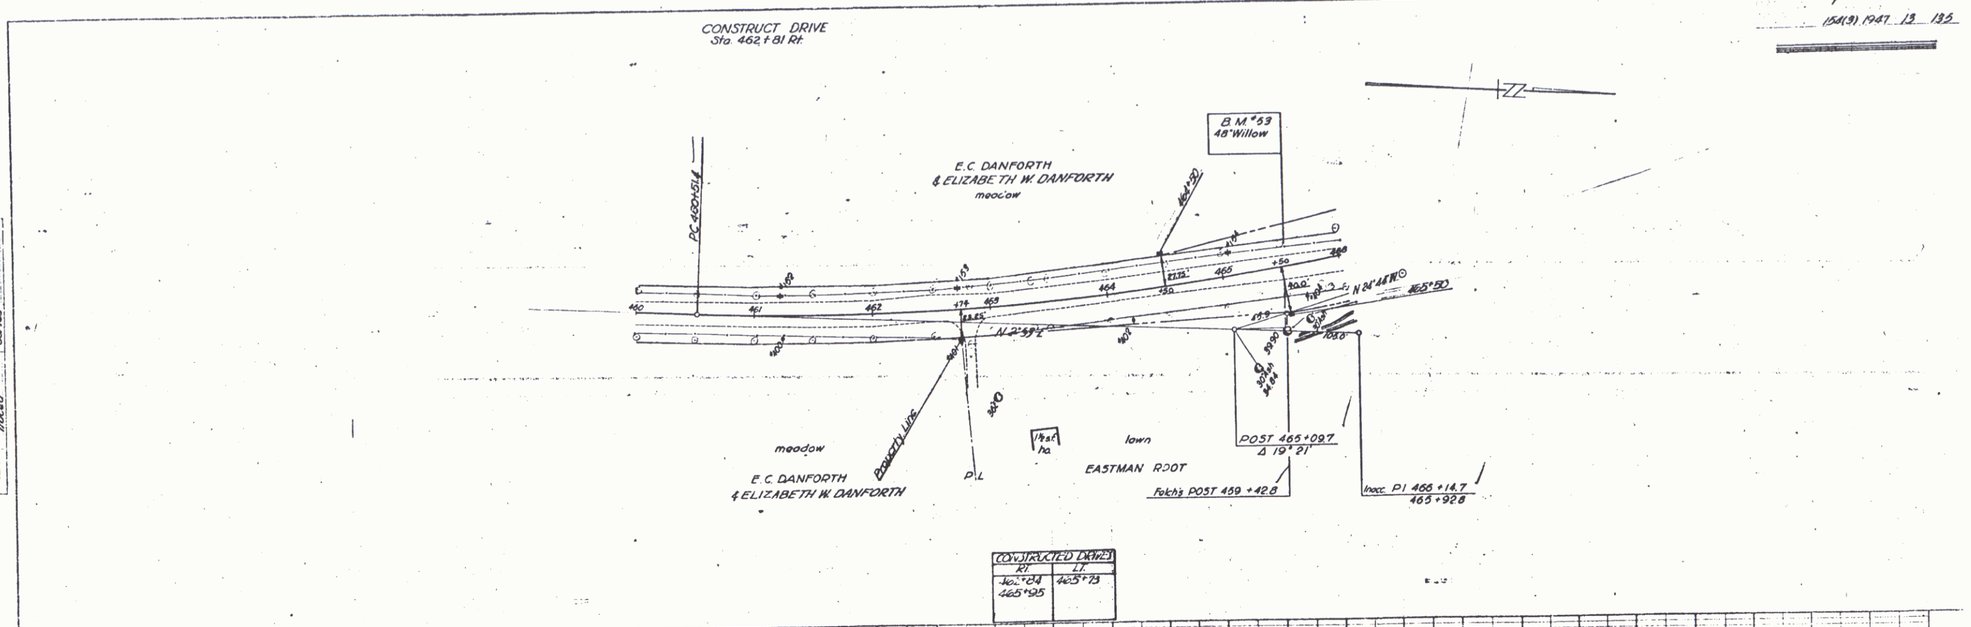

CONSTRUCTED DRIVES	
RT.	LT.
461+84 465+95	465+73

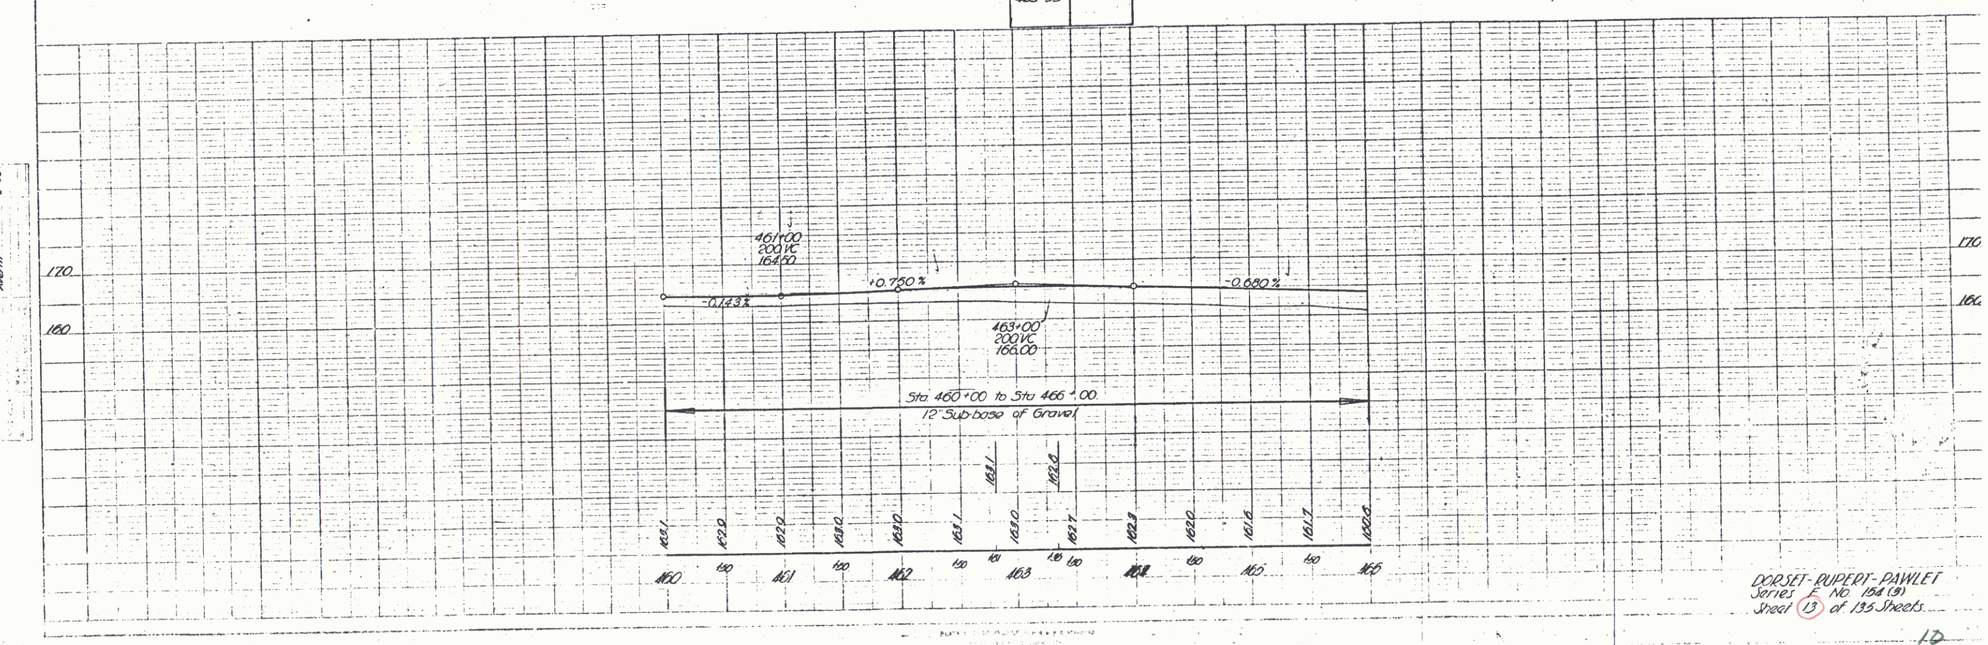

DORSET-RUPERT-PAWLET
Series F No. 154 (9)
Sheet 13 of 135 Sheets