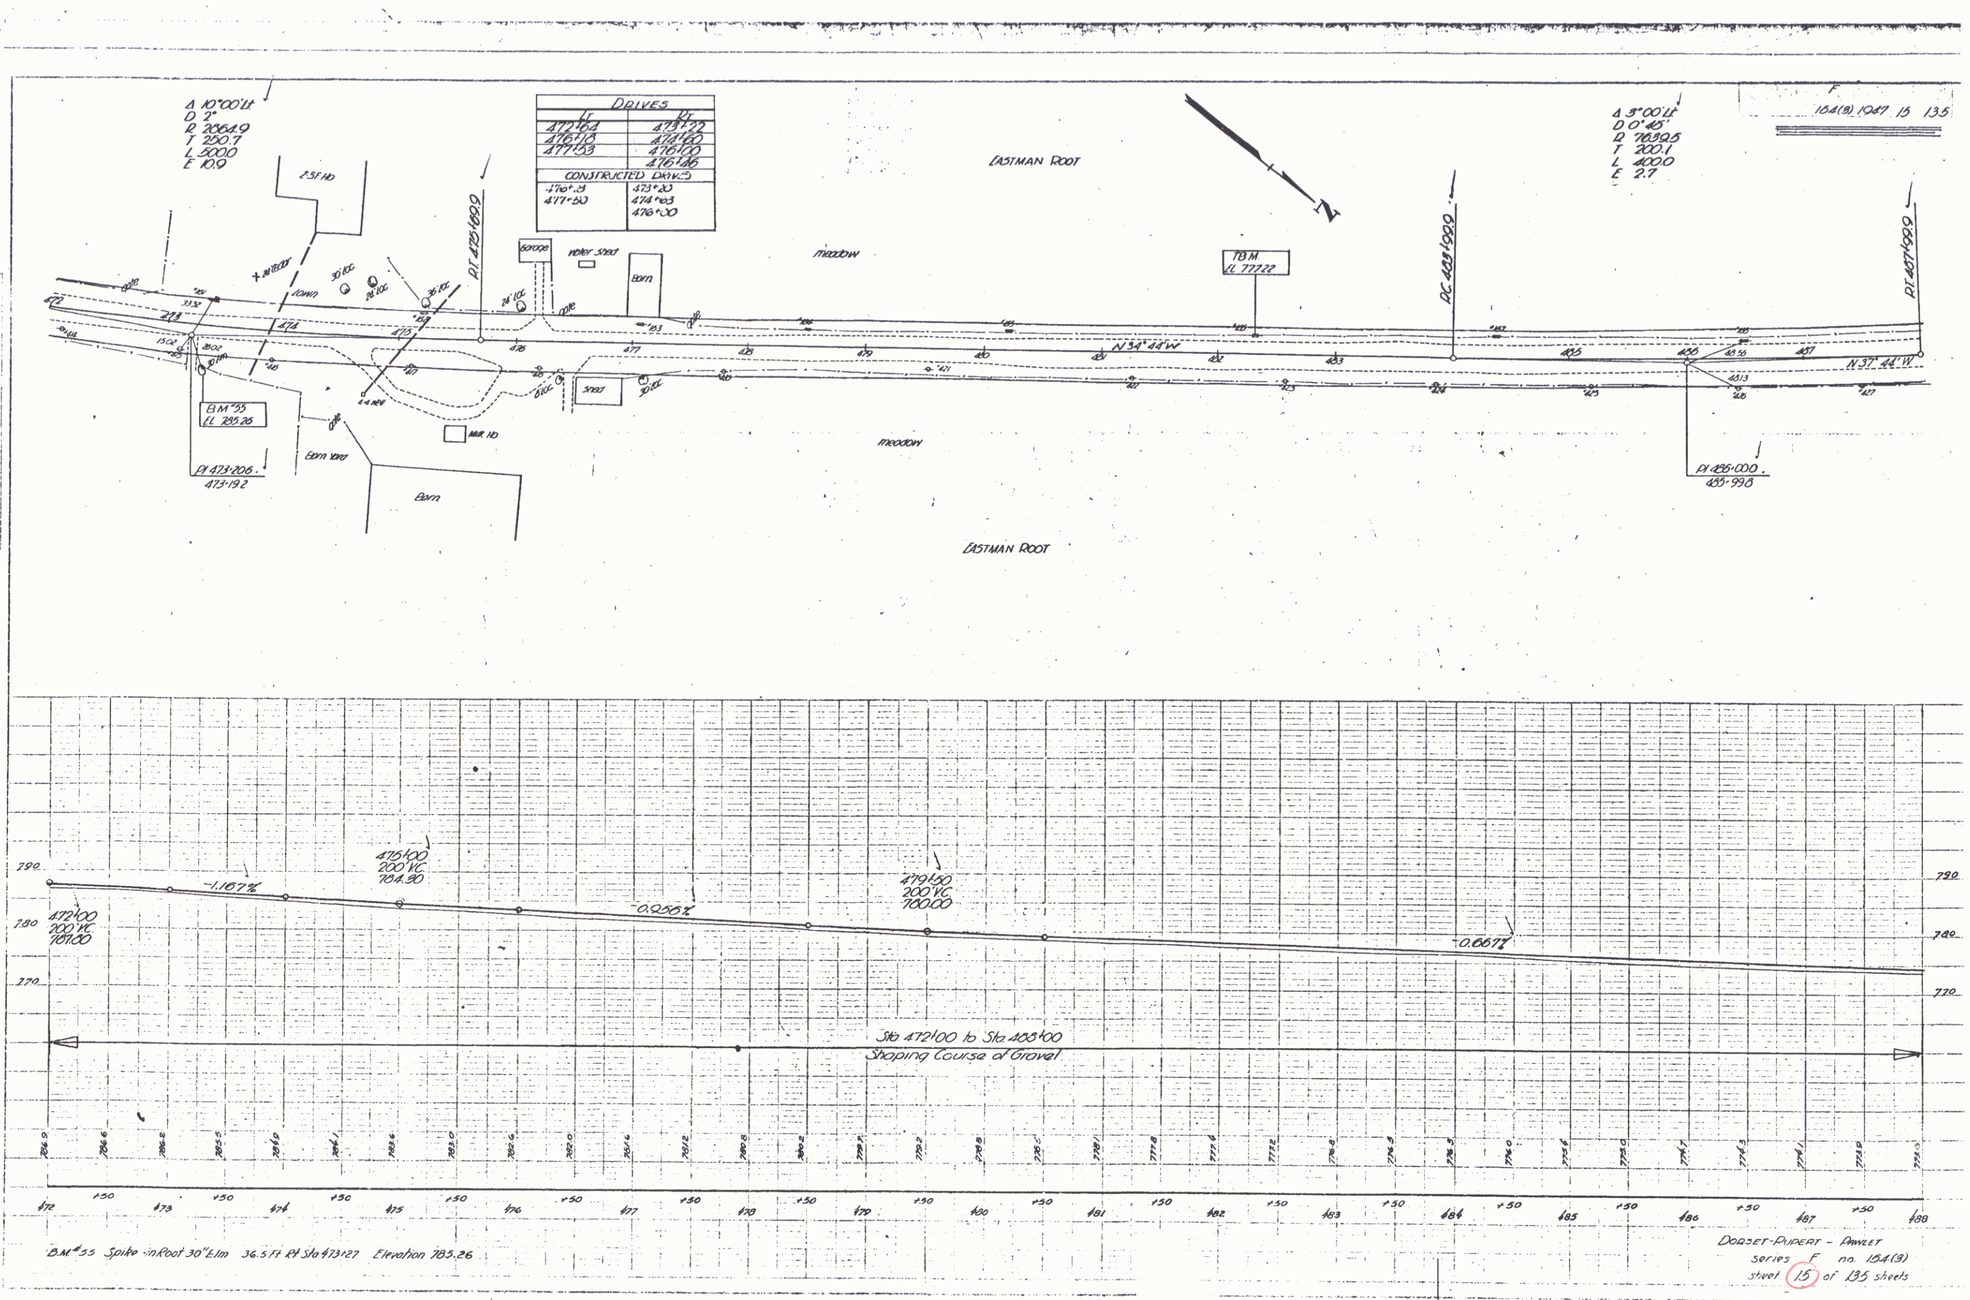
Δ 10°00'Lt
D 2°
R 2864.9
T 250.7
L 500.0
E 10.9
DRIVES
Ft Ft
472+64 473+22
476+03 476+00
477+53 476+00
476+86
CONSTRUCTED DRIVES
476+.8 473+20
477+50 474+63
476+00
2 SF Ho
Garage
Water Stand
Barn
Meadow
EASTMAN ROOT
TBM
EL 777.22
Δ 9°00'Lt
D 0°45'
R 7639.5
T 200.1
L 400.0
E 2.7
N 34° 44' W
N 37° 44' W
BM #55
EL 785.26
PI 473+206
473+192
Barn Yard
Barn
Shed
Meadow
PI 485+000
485+998
EASTMAN ROOT
-1.167%
-0.256%
-0.667%
472+00
200' VC
784.00
476+00
200' VC
784.90
479+50
200' VC
780.00
Sta 472+00 to Sta 485+00
Shaping Course of Gravel
BM #55 Spike in Root 30" Elm 36.5 Ft Rt Sta 473+27 Elevation 785.26
DORSET-RUPERT - PAWLET
Series F no. 154(3)
Sheet 15 of 135 Sheets

12