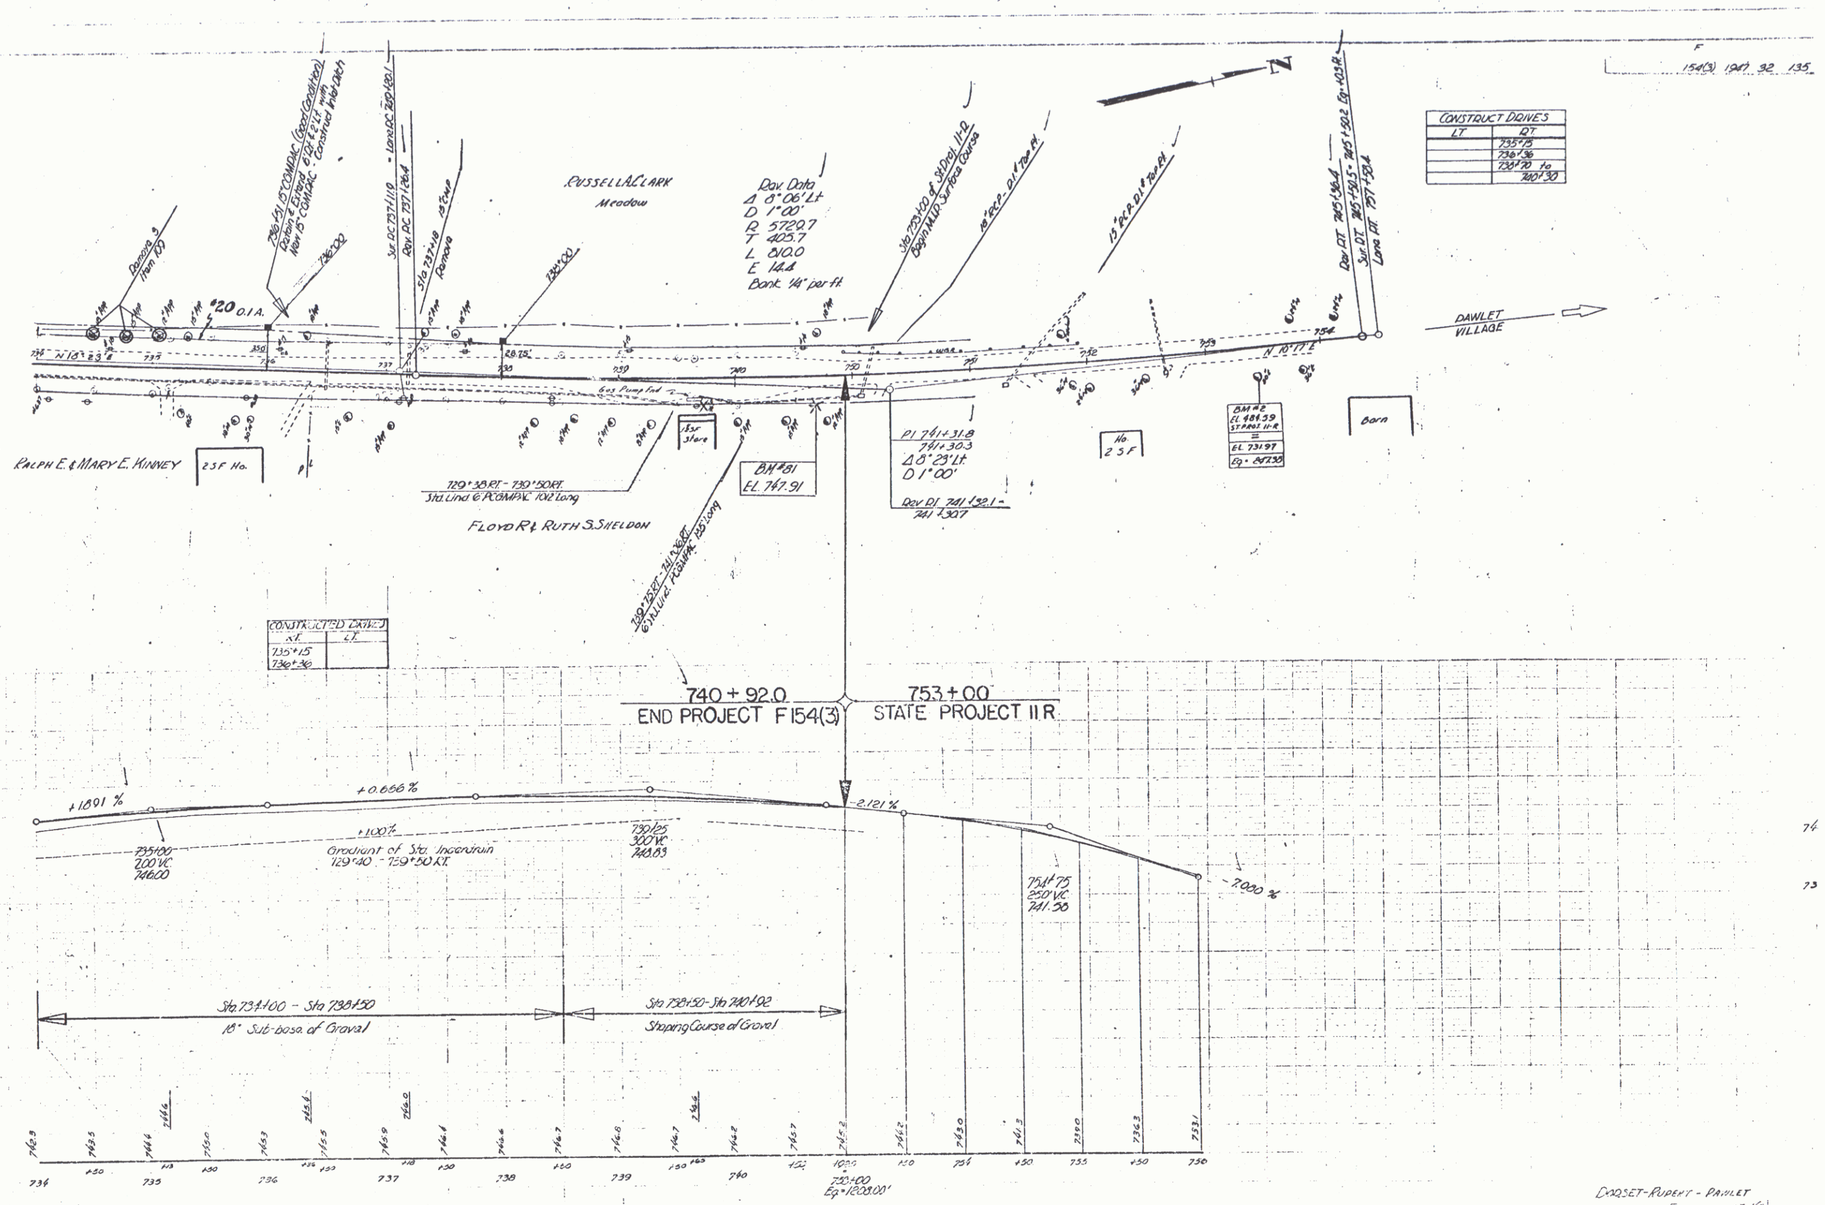
F
154(3) 1947 92 135
N
CONSTRUCT DRIVES
LT RT
735+75
736+36
738+70 to
740+30
Rev. Data
Δ 8°06' Lt
D 1°00'
R 5729.7
T 405.7
L 810.0
E 14.4
Bank 14" per ft.
RUSSELL A. CLARK
Meadow
Sta 733+20 of 98 Dwg. 11-R
Begin MLIP Surface Course
18" RCP - 31.4' to Rt.
15" RCP - 31.4' to Rt.
Rev. LT 745+38.4
Sur. LT 745+38.5 = 745+102 Eq. 103.R
Long LT 747+59.4
DAWLET VILLAGE
N 10°17' E
Barn
BM #2
EL 764.59
ST. PROJ. 11-R
EL 731.97
Eq. = 84.730
No. 23 F
PI 741+31.8
741+30.3
Δ 8°29' Lt
D 1°00'
Rev. PI 741+32.1 - 741+30.7
BM #81
EL 747.91
Sta 729+50 RT.
Sta. Line @ P.COMPAC. 102' Long
FLOYD R. & RUTH S. SHELDON
RALPH E. & MARY E. KINNEY
23 F No.
Sur. 15" Store
Rev. PC 737+11.9 - Long PC 737+18.1
Sta 737+48 15" CMP Remove
Remove & Install 60' of 12" CMP Non 15" CMP Contrac. Contract Will Catch
