	#1	#2A	#2B	#25	#26	#A
Parcel	#1	#2A	#2B	#25	#26	#A
Instr.	W.D.O.E.	W.D.O.E.	W.D.O.E.	W.D.O.E.	W.D.O.E.	W.D.O.E.
Date	10-5-51	10-5-51	7-1-52	7-1-52	7-1-52	12-13-41
Grantor	John & Ruth Rodovich	Gilbert F. & Edith W. Mach	Gilbert F. & Edith W. Mach	John B. & Audrey F. Mach	Maurice Foulla	J. H. Smith
Grantee	St. of Vt.	St. of Vt.	St. of Vt.	St. of Vt.	St. of Vt.	St. of Vt.
Recorded	Pawlet	Pawlet	Pawlet	Pawlet	Pawlet	Pawlet
Book	30	30	30	30	30	36
Page	151	138	232	230	231	104
Date	10-29-51	10-29-51	7-23-52	7-7-52	7-10-52	1-13-42
Remarks					See Sect. 16	See St. Project 11 R

	#B
Parcel	#B
Instr.	W. D. O. E
Date	1-1-42
Grantor	Ada M. Smith
Grantee	St. of Vt.
Recorded	Pawlet
Book	26
Page	104
Date	1-15-42
Remarks	See St. Rq. 11-R Sheet 7

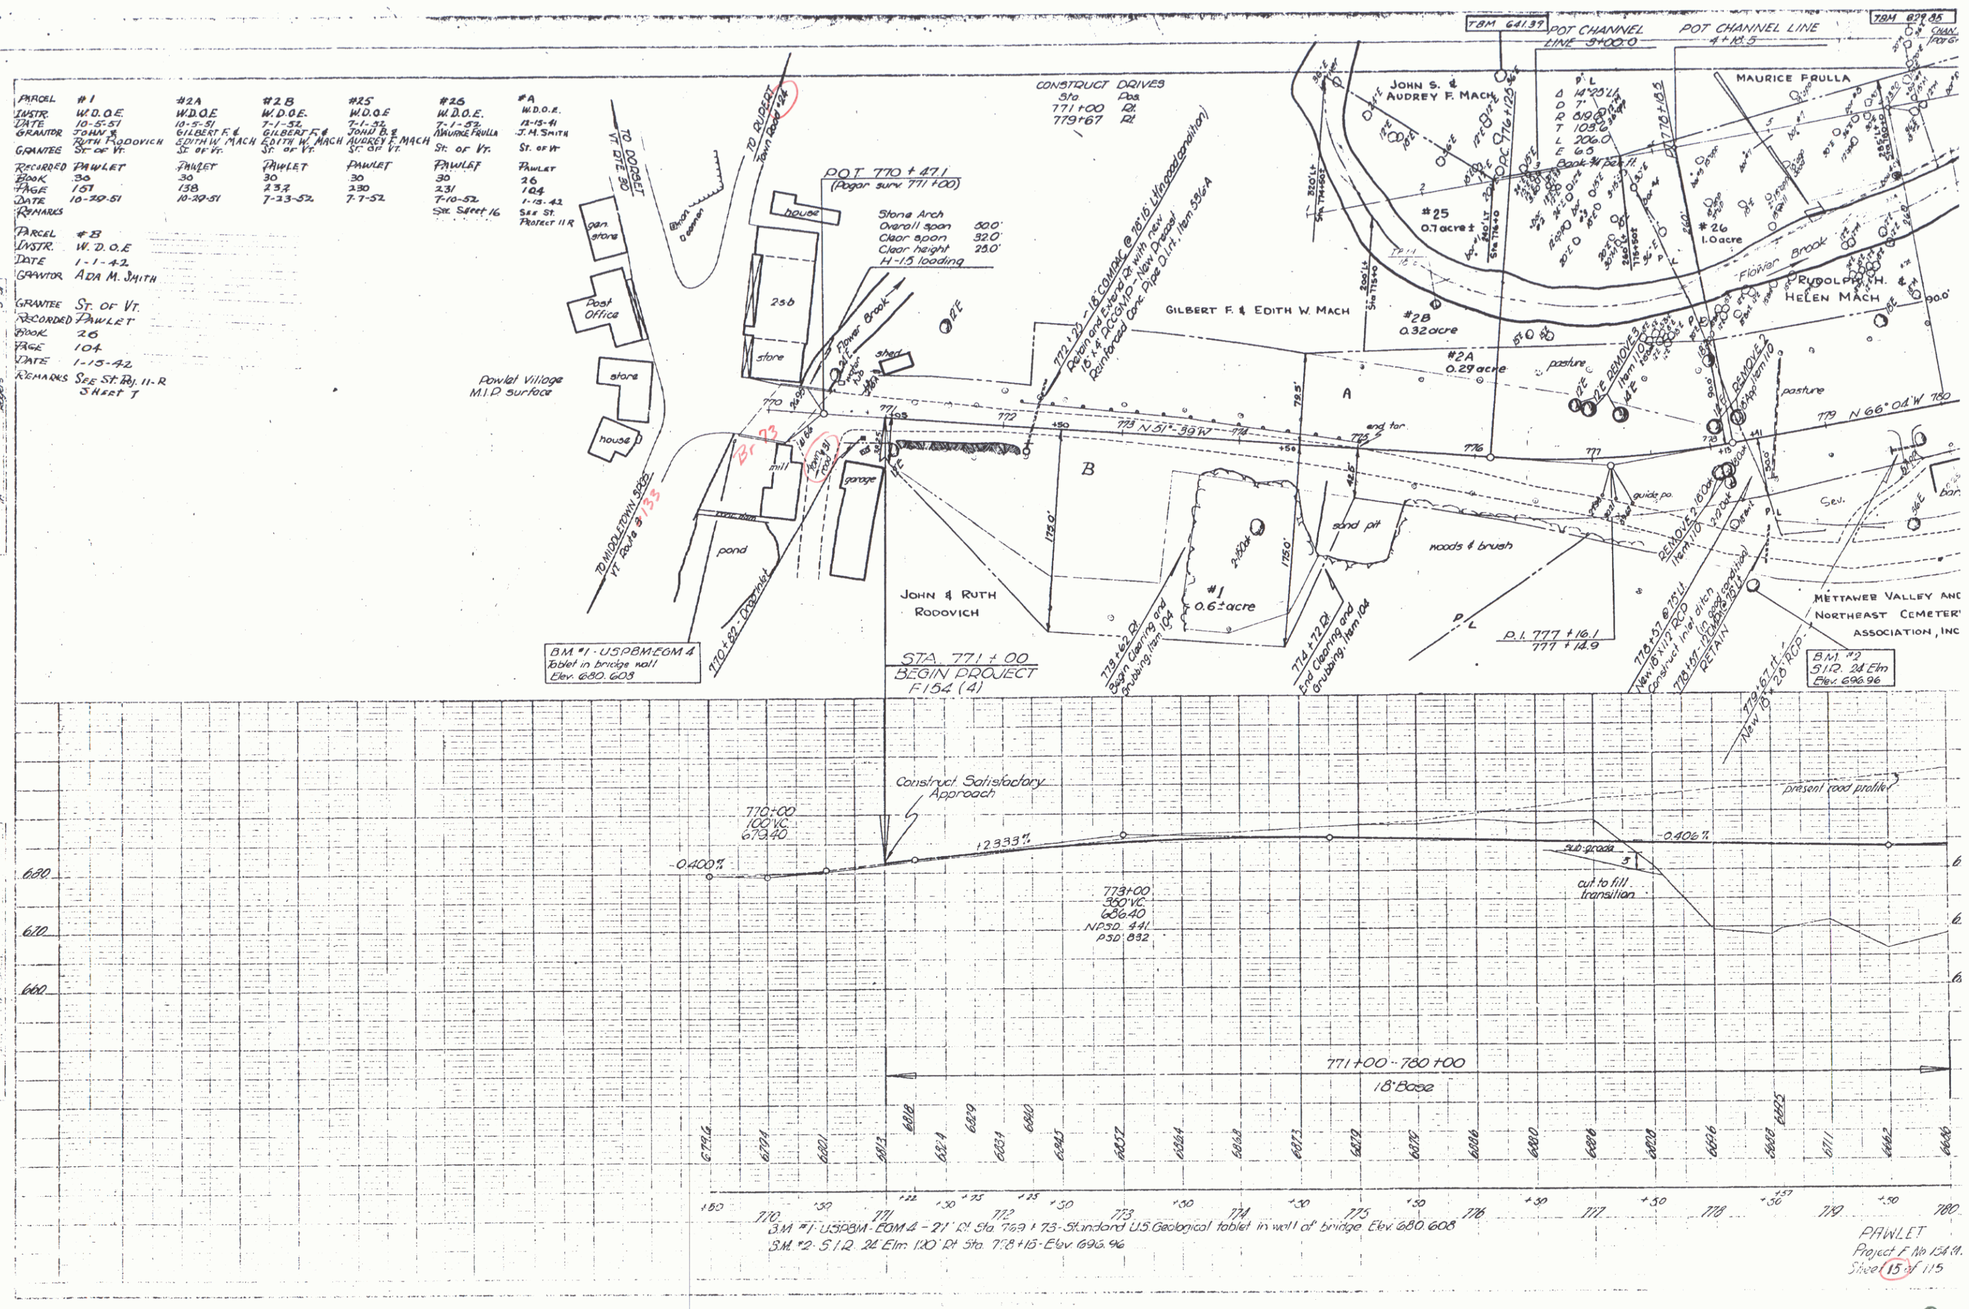

2