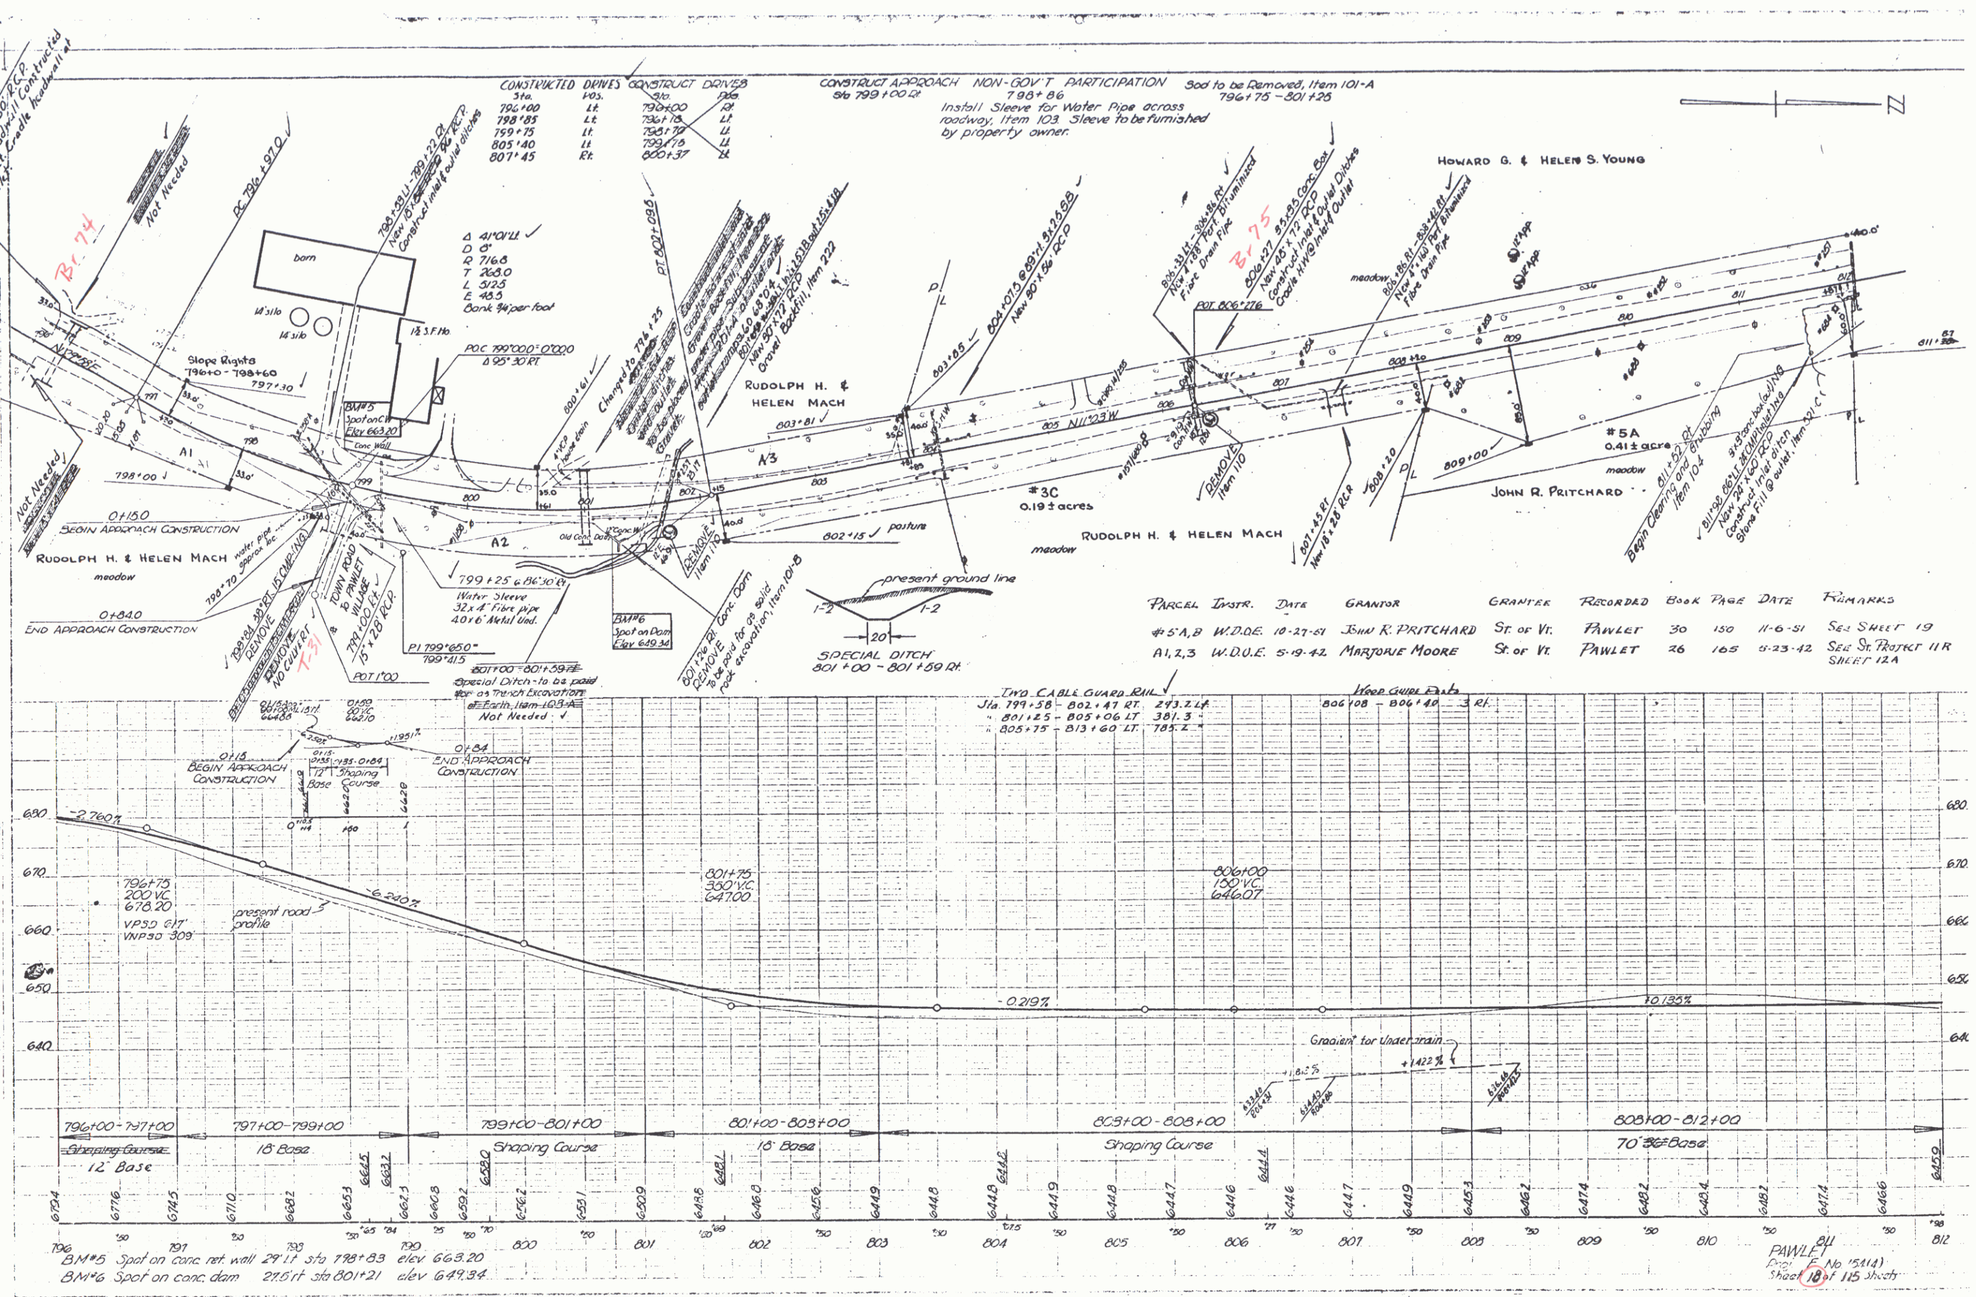

Parcel	Instr.	Date	Grantor	Grantee	Recorded	Book	Page	Date	Remarks
#5A,B	W.D.O.E.	10-27-51	John R. Pritchard	St. of Vt.	Pawlet	30	150	11-6-51	See Sheet 19
A1,2,3	W.D.O.E.	5-19-42	Marjorie Moore	St. of Vt.	Pawlet	26	165	6-23-42	See St. Project 11R Sheet 12A

6