NON-GOV'T PARTICIPATION
881 + 75
Install Sleeve for Water Pipe across roadway, Item 103. Sleeve to be furnished by property owner.

Construct Drives

sta.	pos.	Sta.	Pos.
~~876 + 56~~	~~Lt.~~	~~886 + 25~~	~~Rt.~~
~~881 + 14~~	~~Lt.~~	~~888 + 50~~	~~Lt.~~
881 + 65	Rt.	889 + 40	Lt.
882 + 92	Rt.		
~~888 + 00~~	~~Lt.~~		
889 + 25	Rt.		
890 + 82	Rt.		
881 + 50	Lt.		

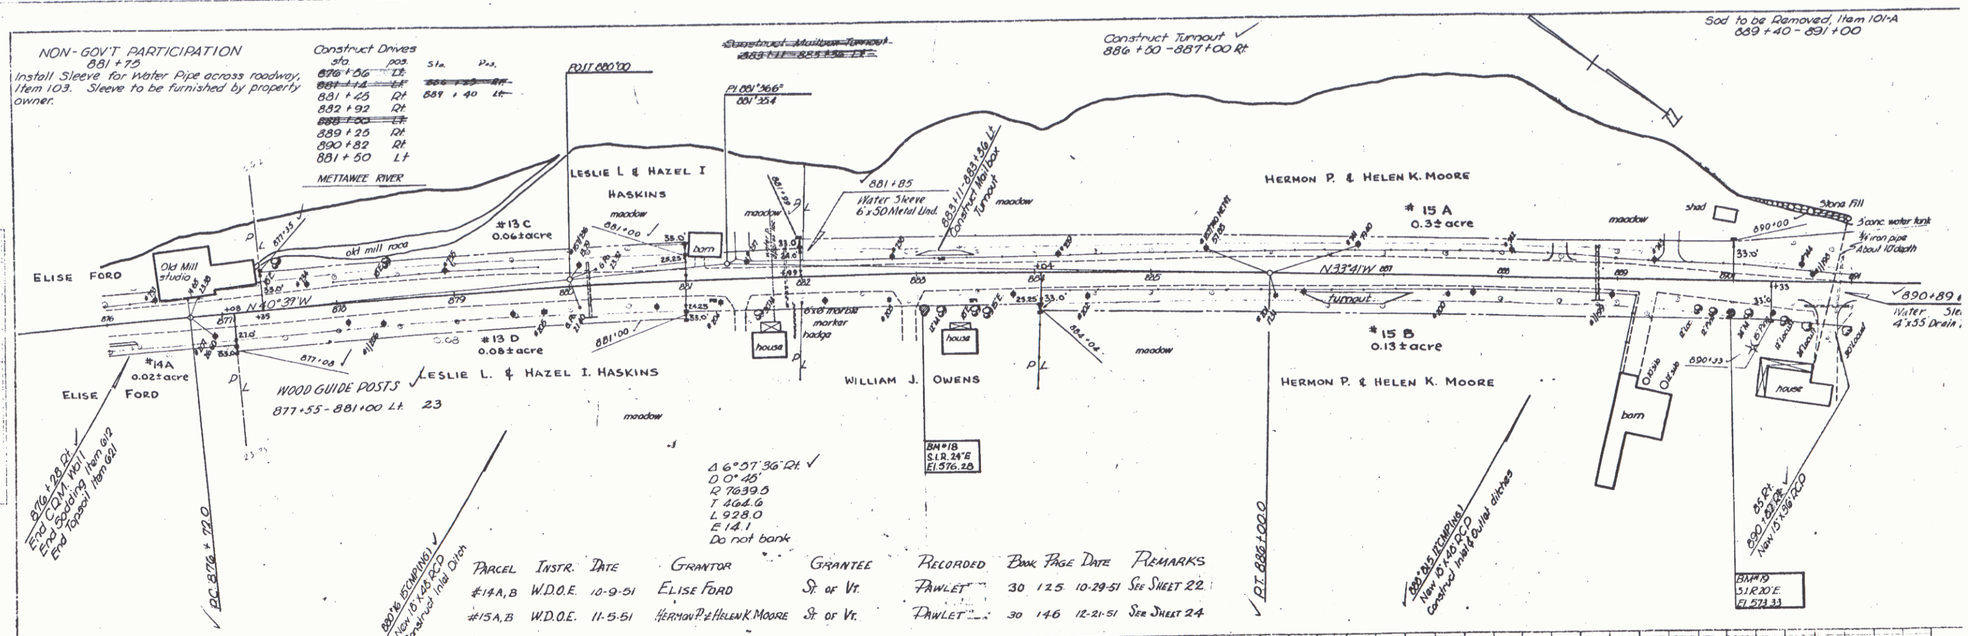

Parcel	Instr.	Date	Grantor	Grantee	Recorded	Book	Page	Date	Remarks
#14A,B	W.D.O.E.	10-9-51	Elise Ford	St. of Vt.	Pawlet	30	125	10-29-51	See Sheet 22
#15A,B	W.D.O.E.	11-5-51	Hermon P. & Helen K. Moore	St. of Vt.	Pawlet	30	146	12-21-51	See Sheet 24

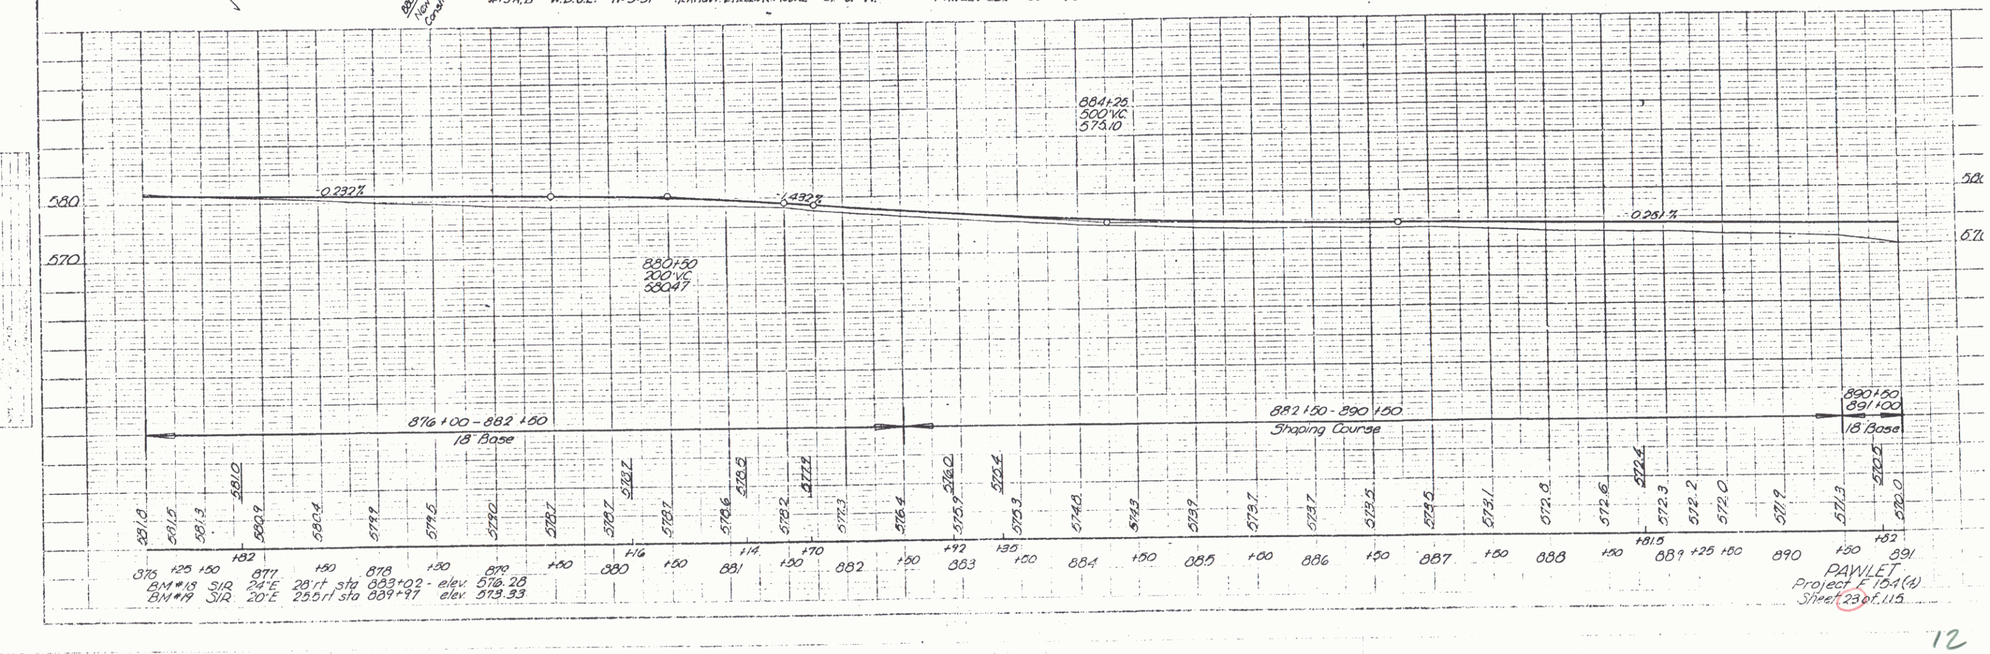

PAWLET
Project F 154(4)
Sheet 23 of 115

12