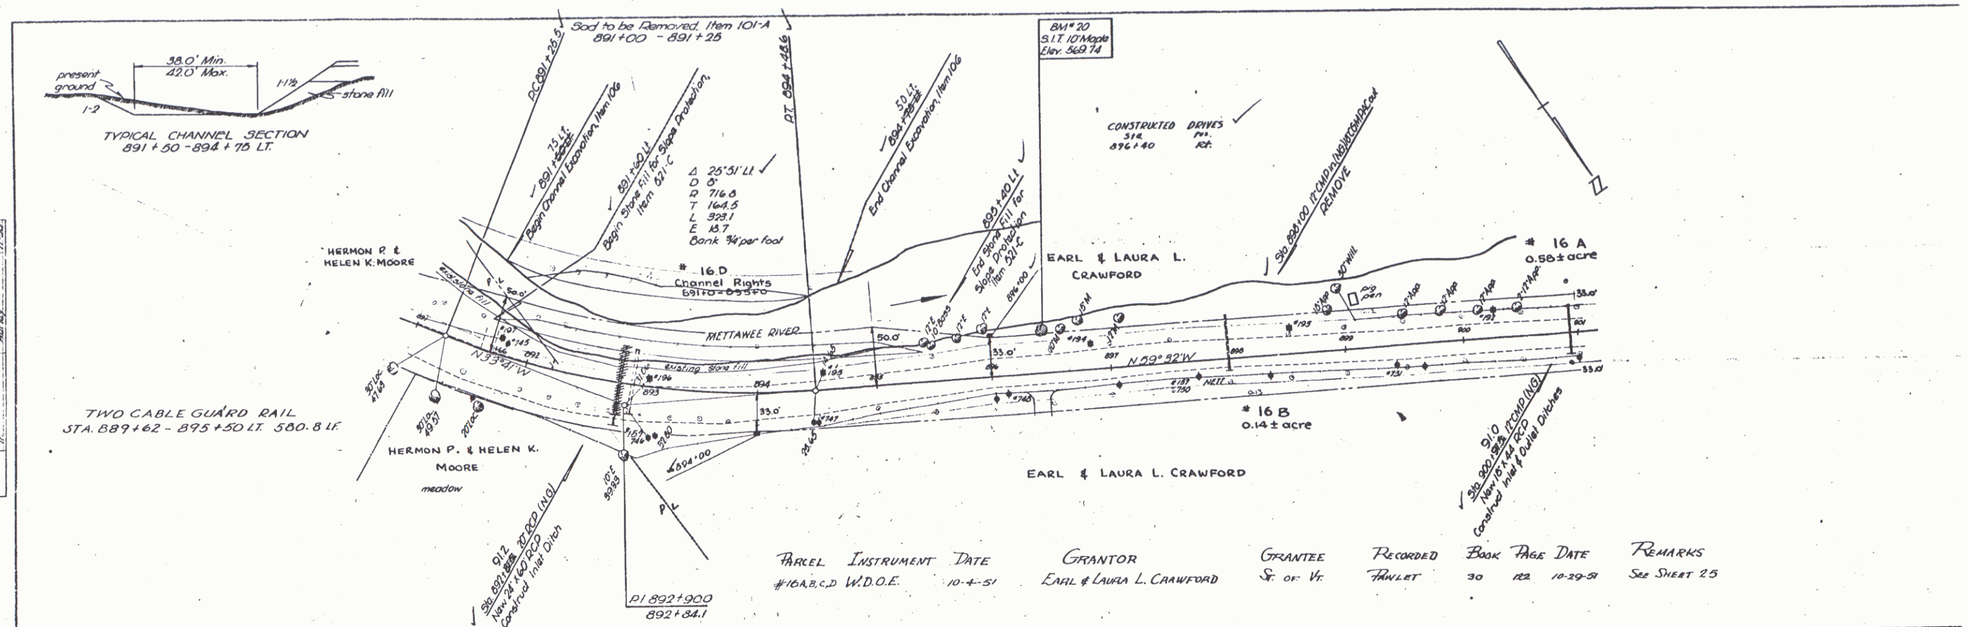

Parcel	Instrument	Date	Grantor	Grantee	Recorded	Book	Page	Date	Remarks
#16A,B,C,D	W.D.O.E.	10-4-51	Earl & Laura L. Crawford	Sr. of Vt.	Pawlet	30	182	10-29-51	See Sheet 25

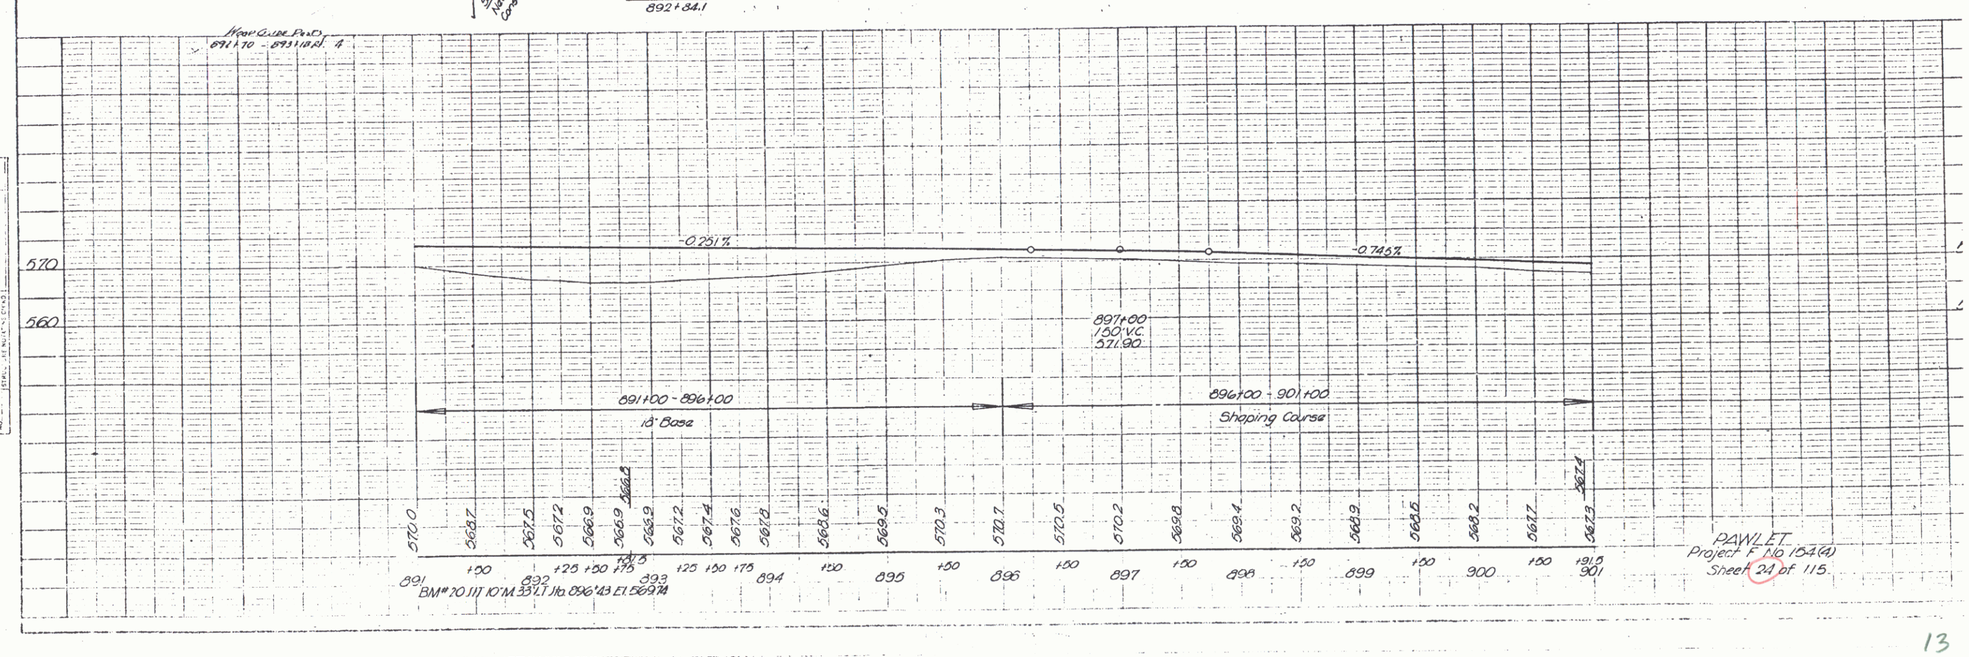

PAWLET
Project F No 154(4)
Sheet 24 of 115

13