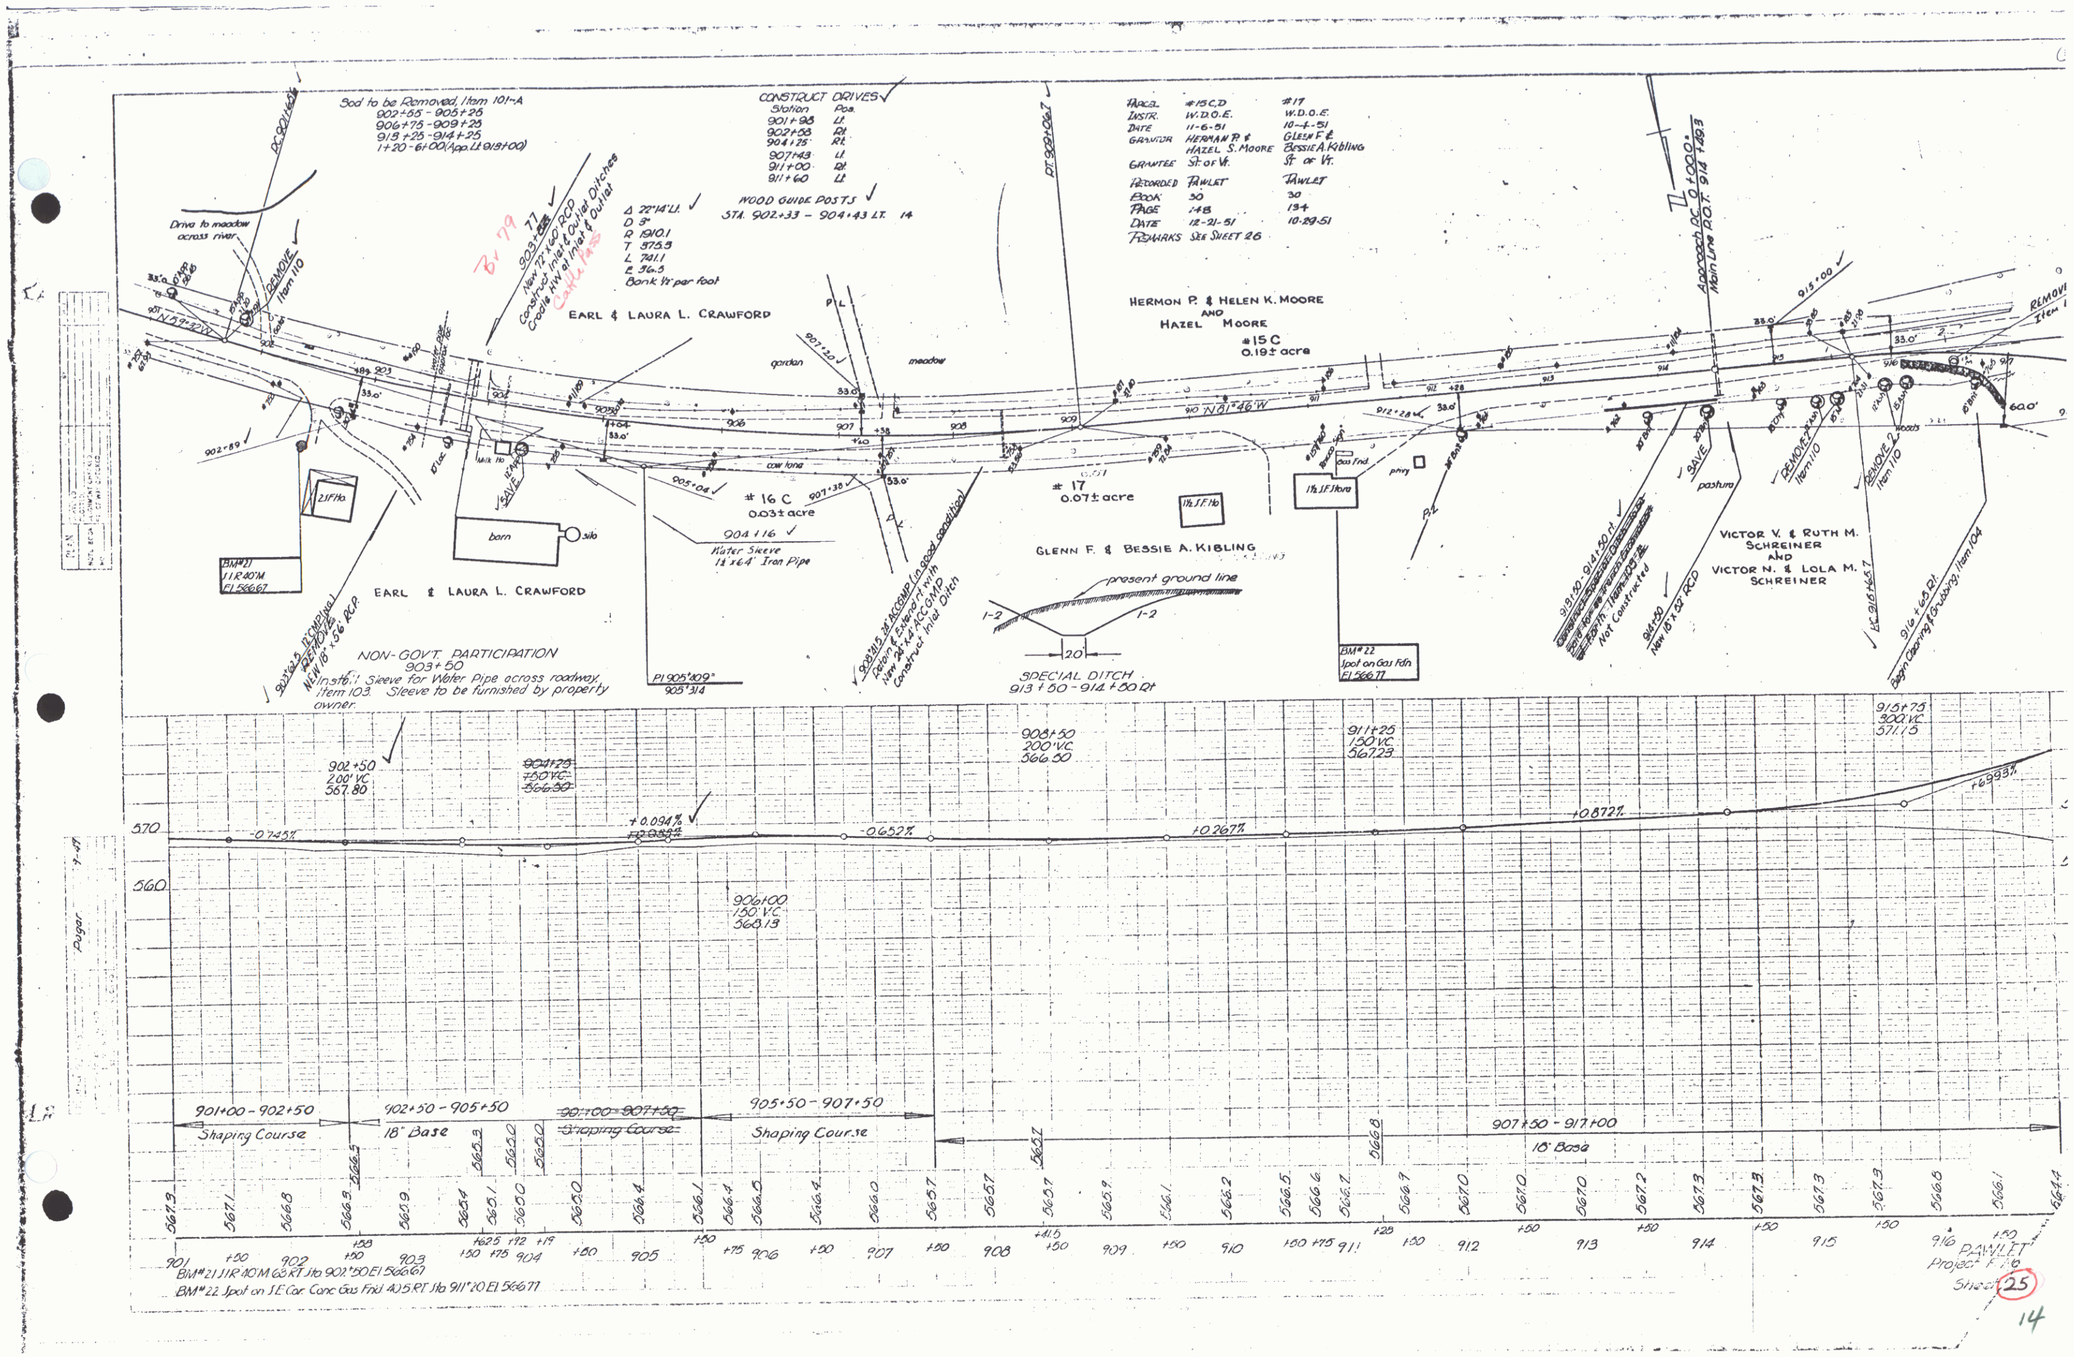
Sod to be Removed, Item 101-A
902+55 - 905+25
906+75 - 909+25
913+25 - 914+25
1+20 - 61+00 (App. Lt 913+00)
CONSTRUCT DRIVES
Station Pos.
901+95 Lt
902+53 Rt
904+25 Rt
907+43 Lt
911+00 Rt
911+60 Lt
WOOD GUIDE POSTS
STA. 902+33 - 904+43 LT. 14
PARCEL #15 C,D #17
INSTR. W.D.O.E. W.D.O.E.
DATE 11-6-51 10-4-51
GRANTOR HERMAN P. & HAZEL S. MOORE GLENN F. & BESSIE A. KIBLING
GRANTEE St. of Vt. St. of Vt.
RECORDED TAWLET TAWLET
BOOK 30 30
PAGE 148 134
DATE 12-21-51 10-29-51
REMARKS SEE SHEET 26
Drive to meadow across river
REMOVE Item 110
Δ 22°14' Lt.
D 3°
R 1910.1
T 375.3
L 741.1
E 36.5
Bank 1½' per foot
New 72" x 60' RCP Coordinate Inlet & Outlet Ditches Coordinate HW of Inlet & Outlet
EARL & LAURA L. CRAWFORD
HERMON P. & HELEN K. MOORE AND HAZEL MOORE
#15 C
0.19± acre
garden
meadow
cow lane
barn
silo
milk house
#16 C
0.03± acre
904+16
Water Sleeve 12' x 6.4' Iron Pipe
#17
0.07± acre
GLENN F. & BESSIE A. KIBLING
present ground line
SPECIAL DITCH
913+50 - 914+50 Rt
BM#21 11R 40'M El 566.67
BM#22 Spot on Gas Fdn El 566.77
NON-GOVT. PARTICIPATION
903+50
Install Sleeve for Water Pipe across roadway. Item 103. Sleeve to be furnished by property owner.
Approach PC 0+00 = Main Line P.O.T. 914+83
VICTOR V. & RUTH M. SCHREINER AND VICTOR N. & LOLA M. SCHREINER
pasture
SAVE
REMOVE 2 Item 110
Not Constructed
Begin Clearing & Excavating, Item 104
902+50 200' VC 567.80
904+75 150' VC 566.50
906+00 150' VC 568.13
908+50 200' VC 566.50
911+25 150' VC 567.23
915+75 200' VC 571.15
570
560
-0.745%
+0.094%
-0.652%
+0.267%
+0.872%
+6.993%
901+00 - 902+50 Shaping Course
902+50 - 905+50 18" Base
~~905+00 - 907+50 Shaping Course~~
905+50 - 907+50 Shaping Course
907+50 - 917+00 18" Base
BM#21 11R 40'M Gas Rt Jtb 902'50 El 566.61
BM#22 Spot on SE Cor. Conc Gas Fnd 4.0 Rt Jtb 911'20 El 566.77
TAWLET
Project F-10
Sheet 25
14