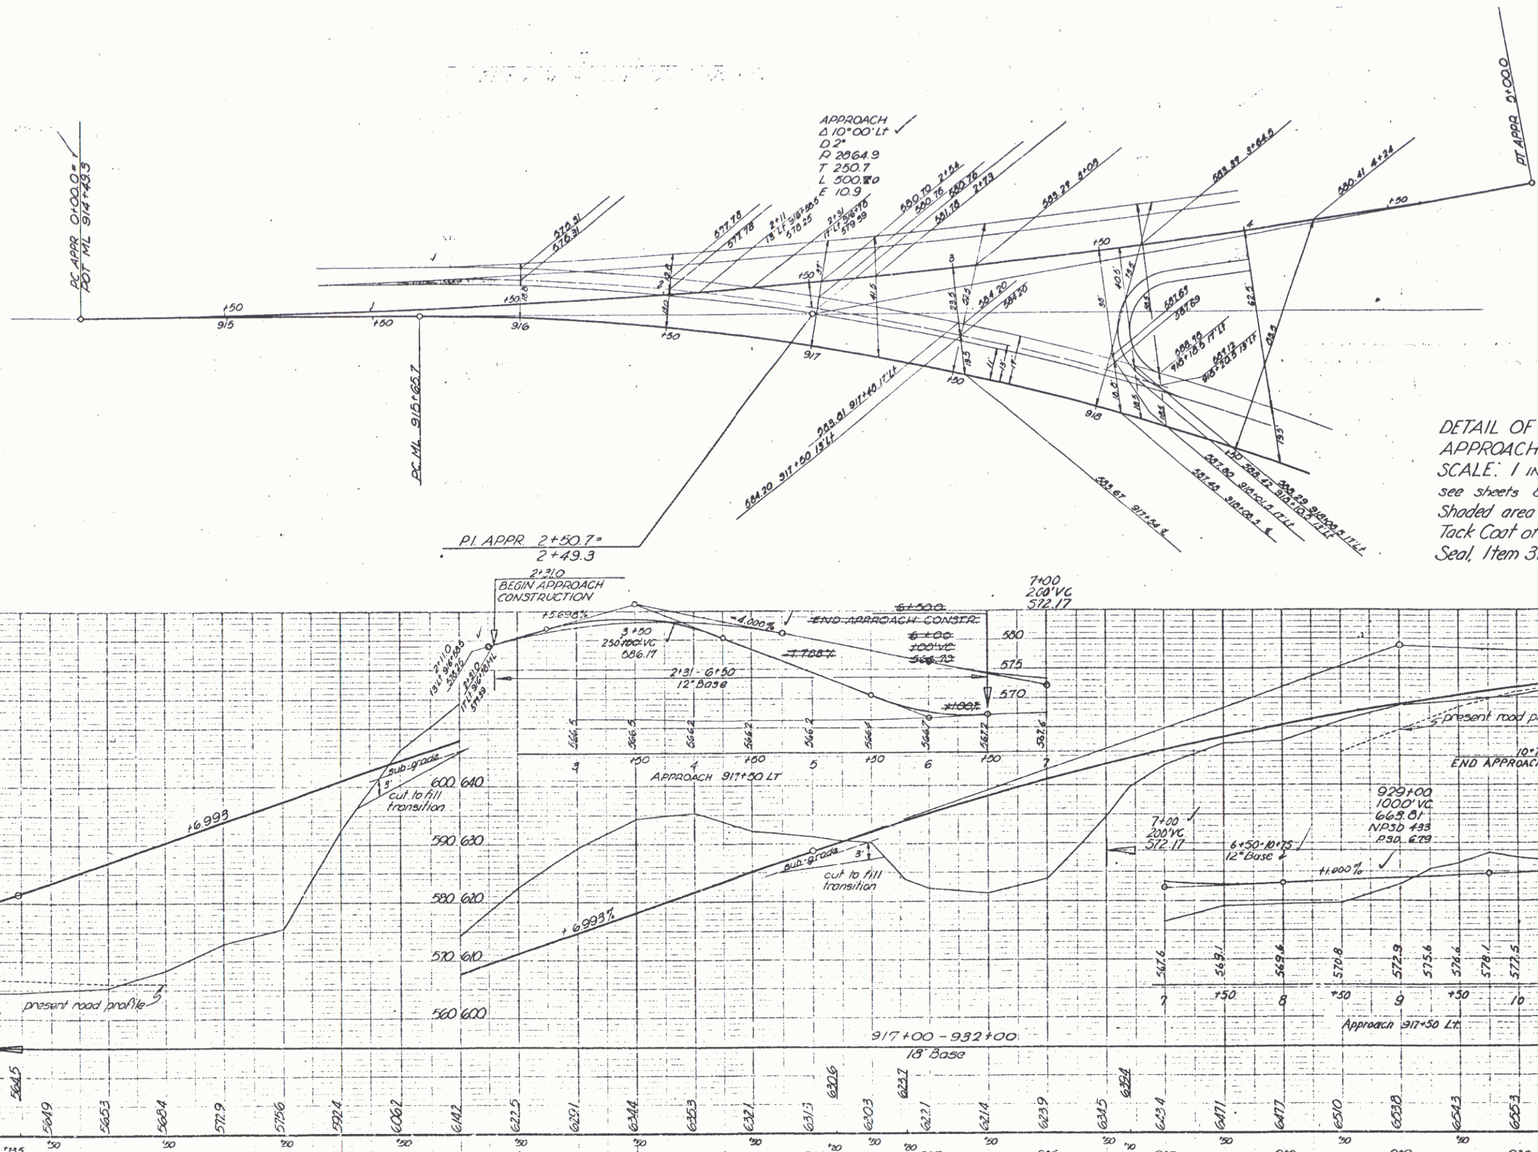

DETAIL OF INTERSECTION AT APPROACH 917+50 L.T.
SCALE: 1 INCH = 20 FEET
see sheets 87-92 of 115
Shaded area to be Surfaced with Double Tack Coat of Refined Tar with Pea Stone Seal, Item 312-A.

BM# 23 1.1 LT BM. Spot on Conc. HW 15.1 LT Sta. 917°21 El 566.01
BM# 24 1.1 R 24' M 122 RT Sta 921°57 El 620.77

BM# 25 Spot on Ladya 20 RT Sta 923°95 El 637.36
BM# 26 Spot on Ladya 182 LT Sta 927°525 El 623.49

BM# 27 1.1 R 20 M 35 RT Sta 929°22 El 658.26

PAWLET
Project F No 154(4)
Sheet 23 of 115

16