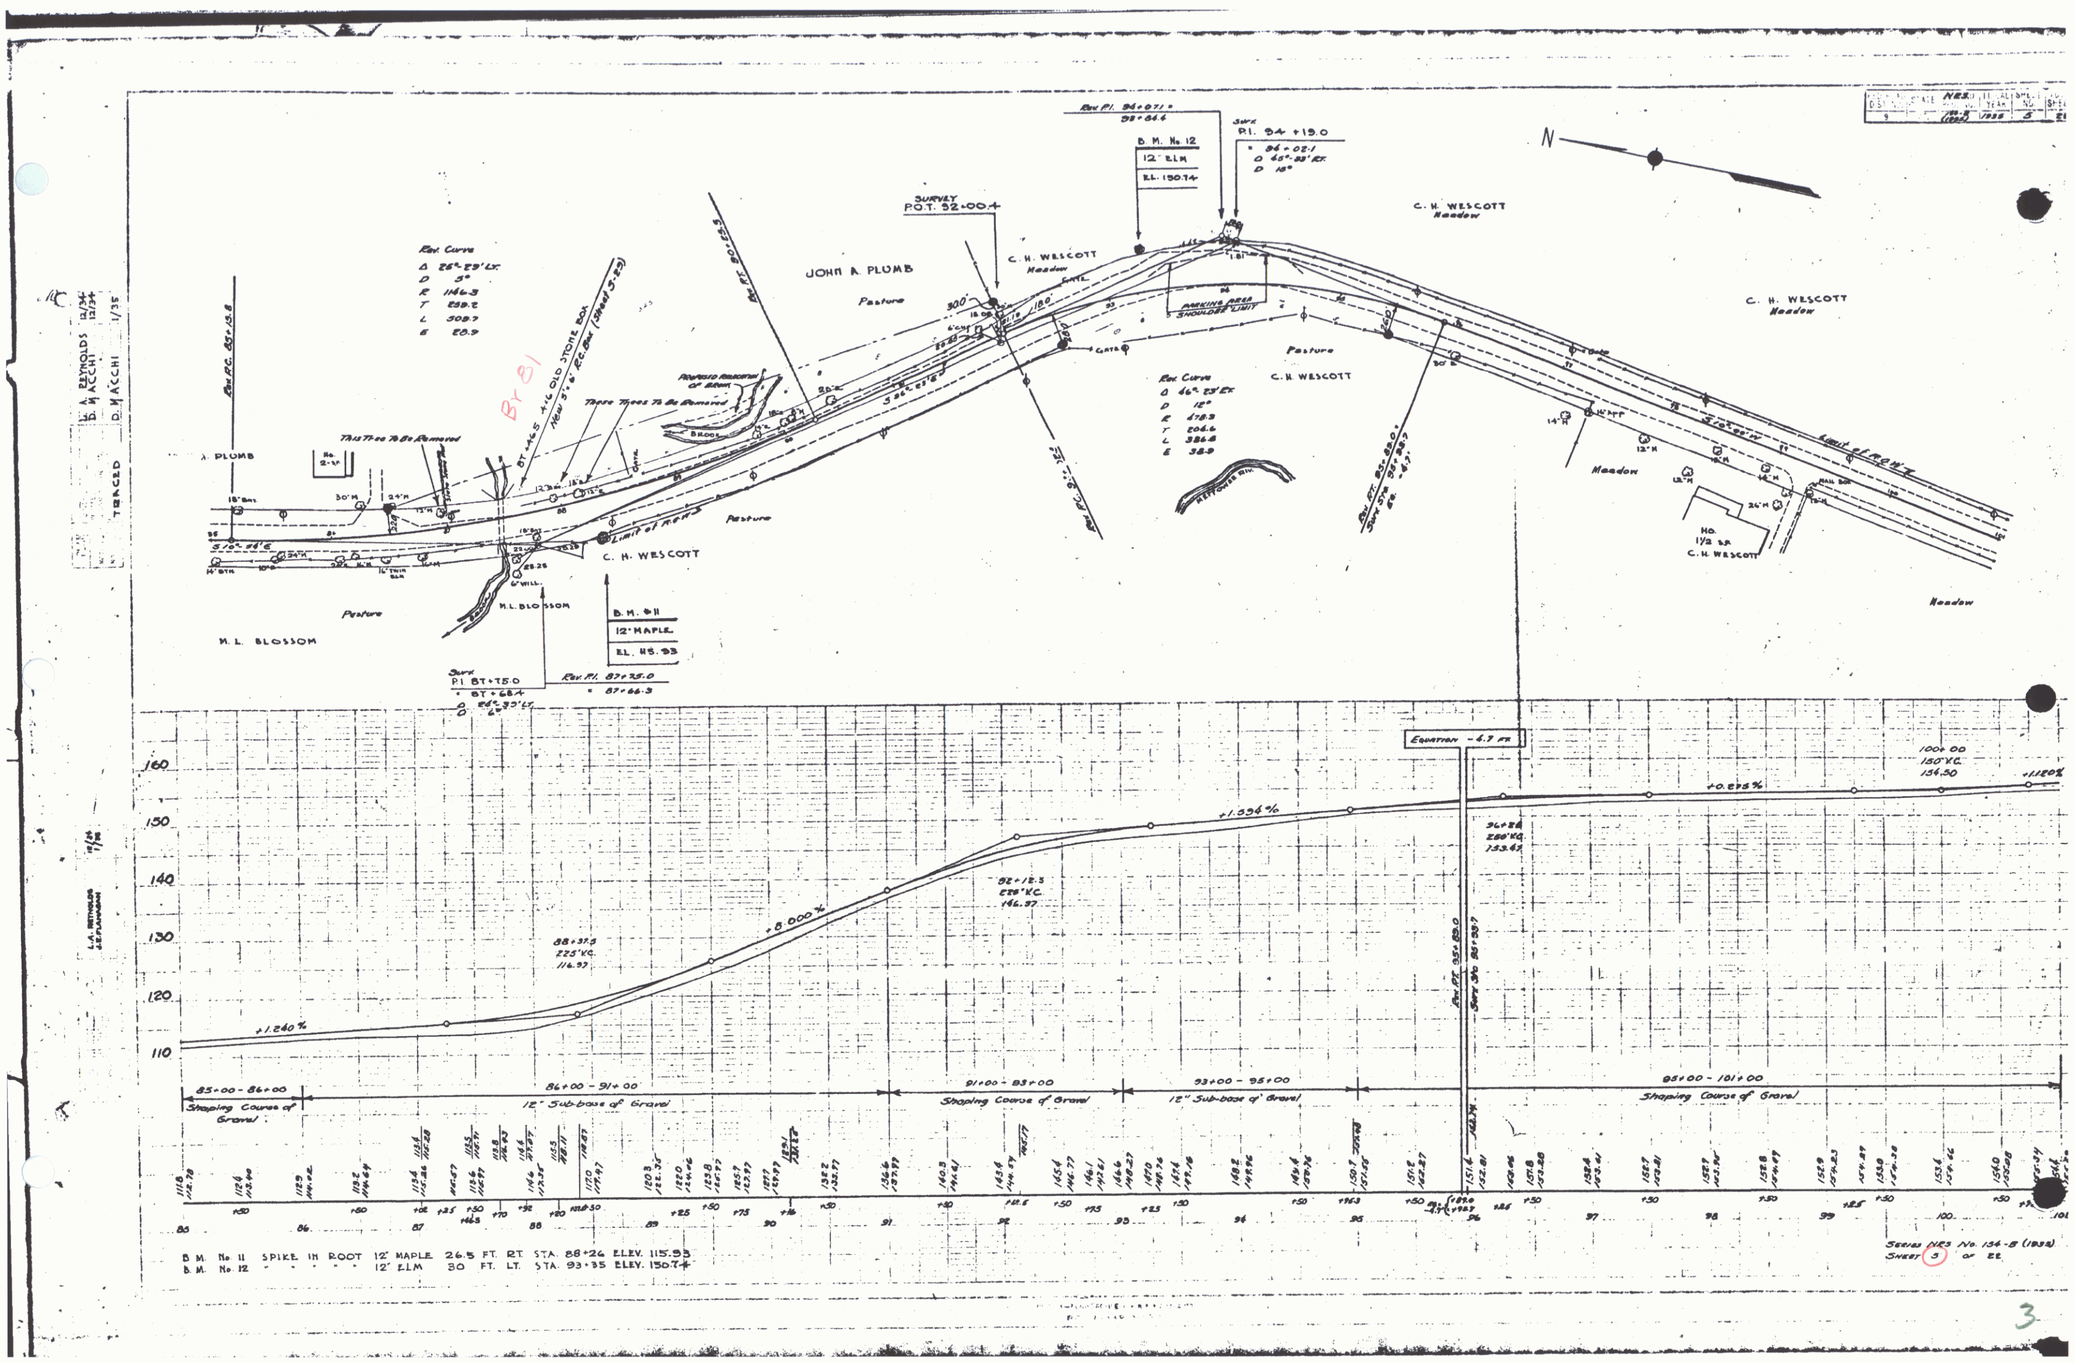
N
JOHN A. PLUMB
Pasture
C. H. WESCOTT
Meadow
M. L. BLOSSOM
Survey P.O.T. 52+00.4
B. M. No. 12
12" ELM
EL. 150.74
Surv. P.I. 94+19.0
Rev. P.I. 94+07.1
B. M. 11
12" MAPLE
EL. 115.93
Surv. P.I. 87+75.0
Rev. P.I. 87+75.0
Rev. Curve
Δ 26°-29' Lt.
D 2°
R 1146.3
T 269.2
L 509.7
E 20.9
Rev. Curve
Δ 46°-23' Rt.
D 12°
R 478.3
T 206.6
L 386.6
E 36.9
Parking Area Shoulder Limit
Limit of R.O.W.
Equation - 6.7 FT.
+1.240%
+8.000%
+1.334%
+0.275%
+1.120%
85+00 - 86+00
Shaping Course of Gravel
86+00 - 91+00
12" Sub-base of Gravel
91+00 - 93+00
Shaping Course of Gravel
93+00 - 95+00
12" Sub-base of Gravel
95+00 - 101+00
Shaping Course of Gravel
B.M. No 11 SPIKE IN ROOT 12" MAPLE 26.5 FT. RT. STA. 88+26 ELEV. 115.93
B.M. No 12 " " " " 12" ELM 30 FT. LT. STA. 93+35 ELEV. 150.74
Series NES No. 134-B (1938)
Sheet 3 of 22

3