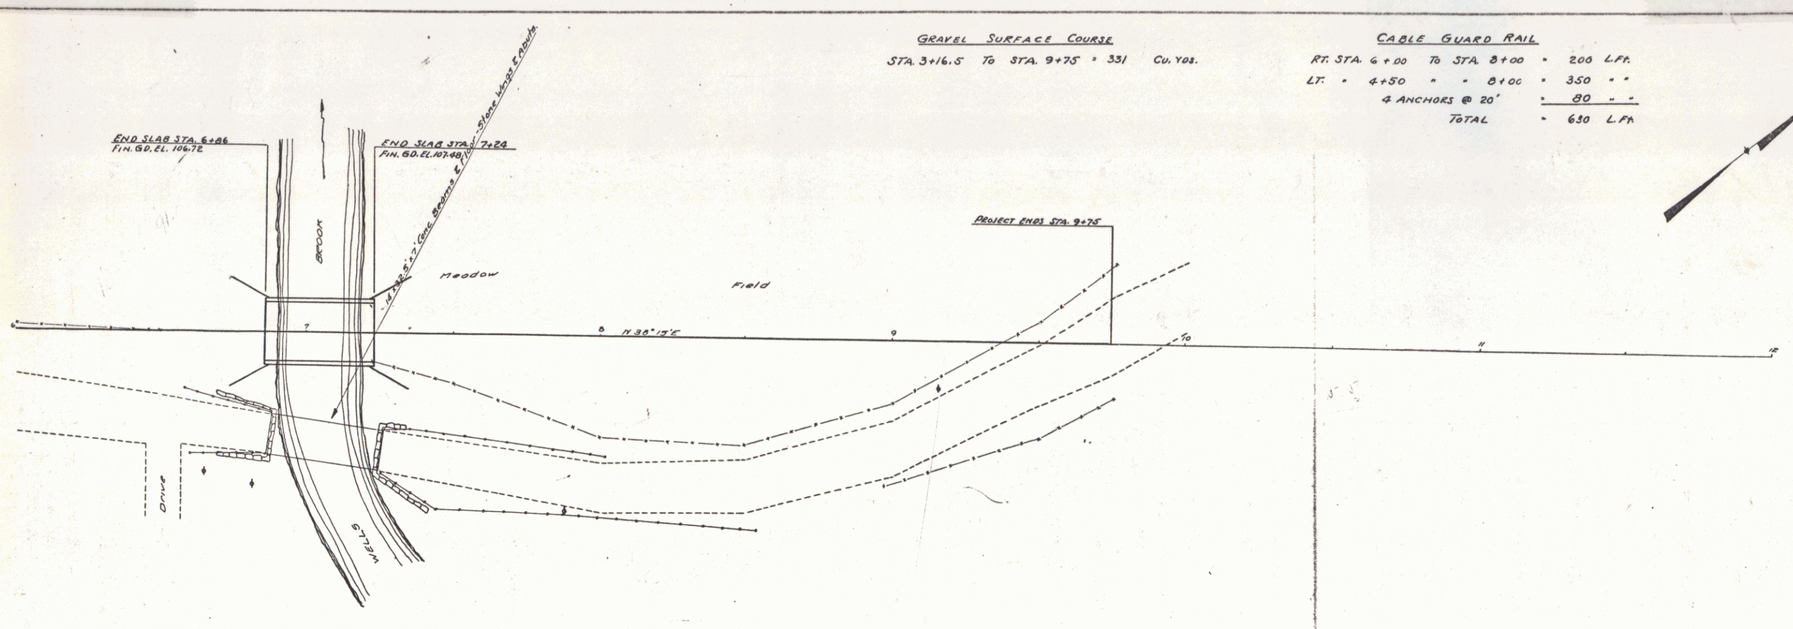

GRAVEL SURFACE COURSE

STA. 3+16.5 To STA. 9+75 = 331 Cu. Yds.

CABLE GUARD RAIL

Rt. Sta.	6+00	To Sta.	8+00	= 200 L.Ft.
Lt. "	4+50	" "	8+00	= 350 " "
4 Anchors @ 20'				= 80 " "
Total				= 630 L.Ft.

N

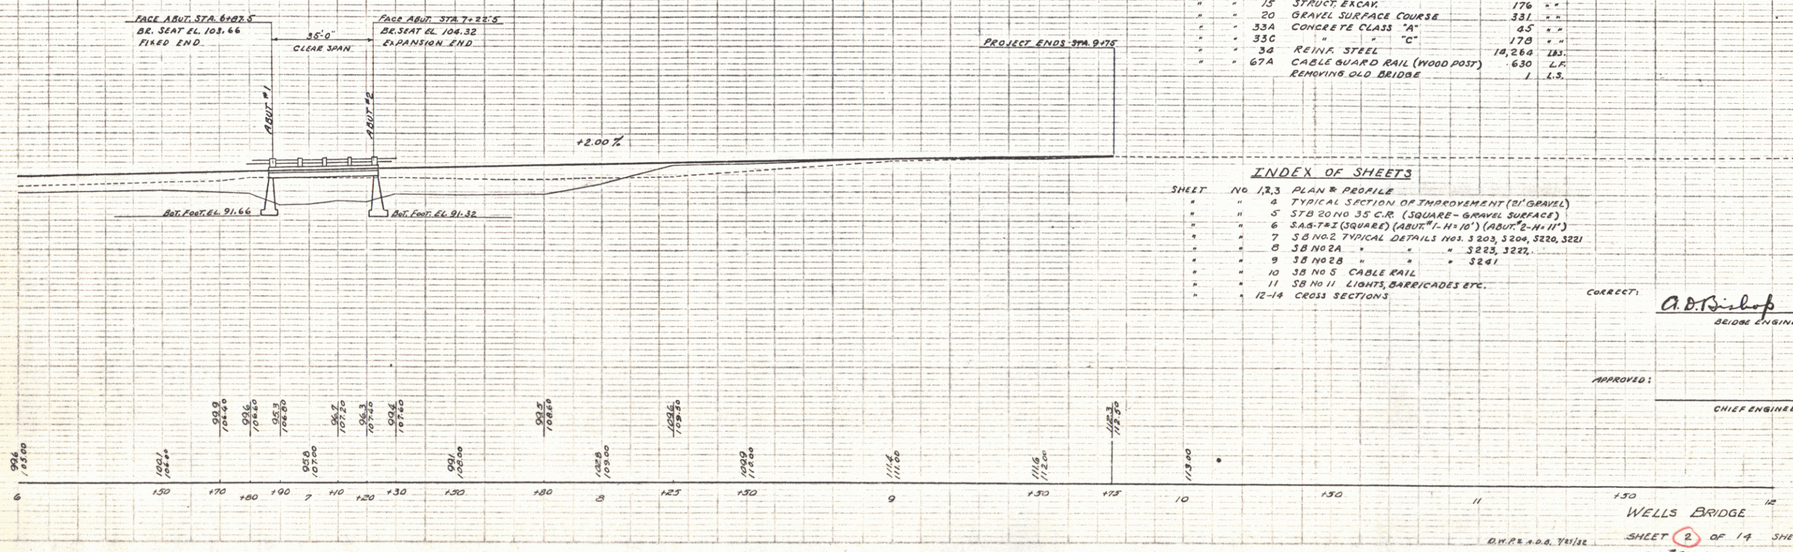

ESTIMATED QUANTITIES

Item	No.			
"	"	15	Struct. Excav.	176 C.Y.
"	"	20	Gravel Surface Course	331 " "
"	"	33A	Concrete Class "A"	65 " "
"	"	33C	" " "C"	178 " "
"	"	34	Reinf. Steel	18,264 Lbs.
"	"	67A	Cable Guard Rail (Wood Post)	630 L.F.
			Removing Old Bridge	1 L.S.

INDEX OF SHEETS

Sheet No.			
1,2,3			Plan & Profile
"	"	4	Typical Section of Improvement (21' Gravel)
"	"	5	Std. 20 No. 35 C.R. (Square - Gravel Surface)
"	"	6	S.A.S. 7-12 (Square) (Abut. #1 - H = 10') (Abut. #2 - H = 11')
"	"	7	St. No. 2 Typical Details Nos. 3203, 3204, 3220, 3221
"	"	8	St. No. 2A " " " 3223, 3227
"	"	9	St. No. 2B " " " 3241
"	"	10	St. No. 5 Cable Rail
"	"	11	St. No. 11 Lights, Barricades Etc.
"	"	12-14	Cross Sections

Correct: A. D. Bishop
Bridge Engineer

Approved:
Chief Engineer

WELLS BRIDGE

SHEET (2) OF 14 SHEETS

S.A. # 21-1932

D.W.P.R. & D.O. Y31/32

2