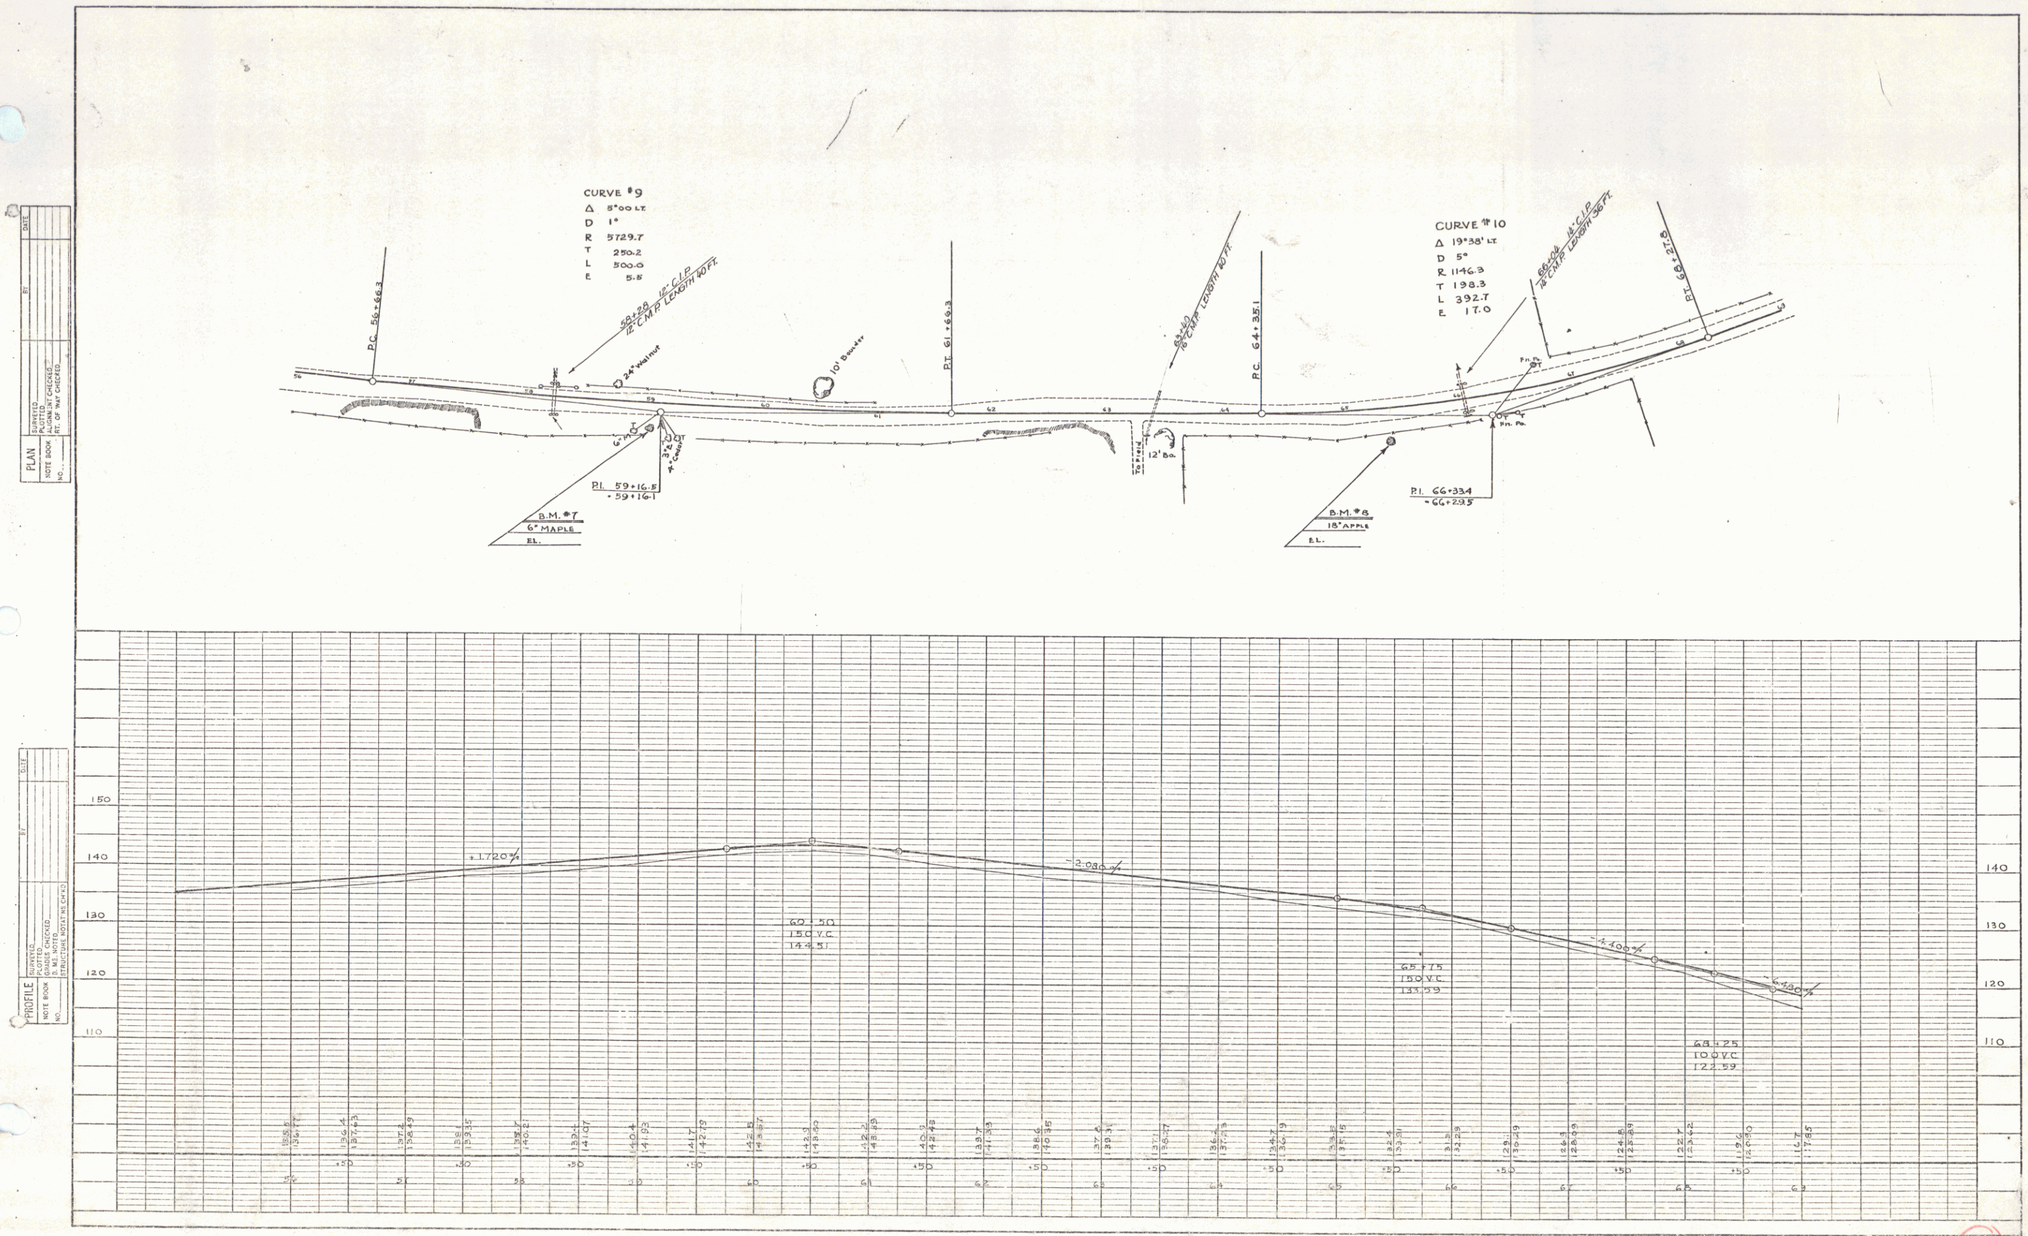


5

5