




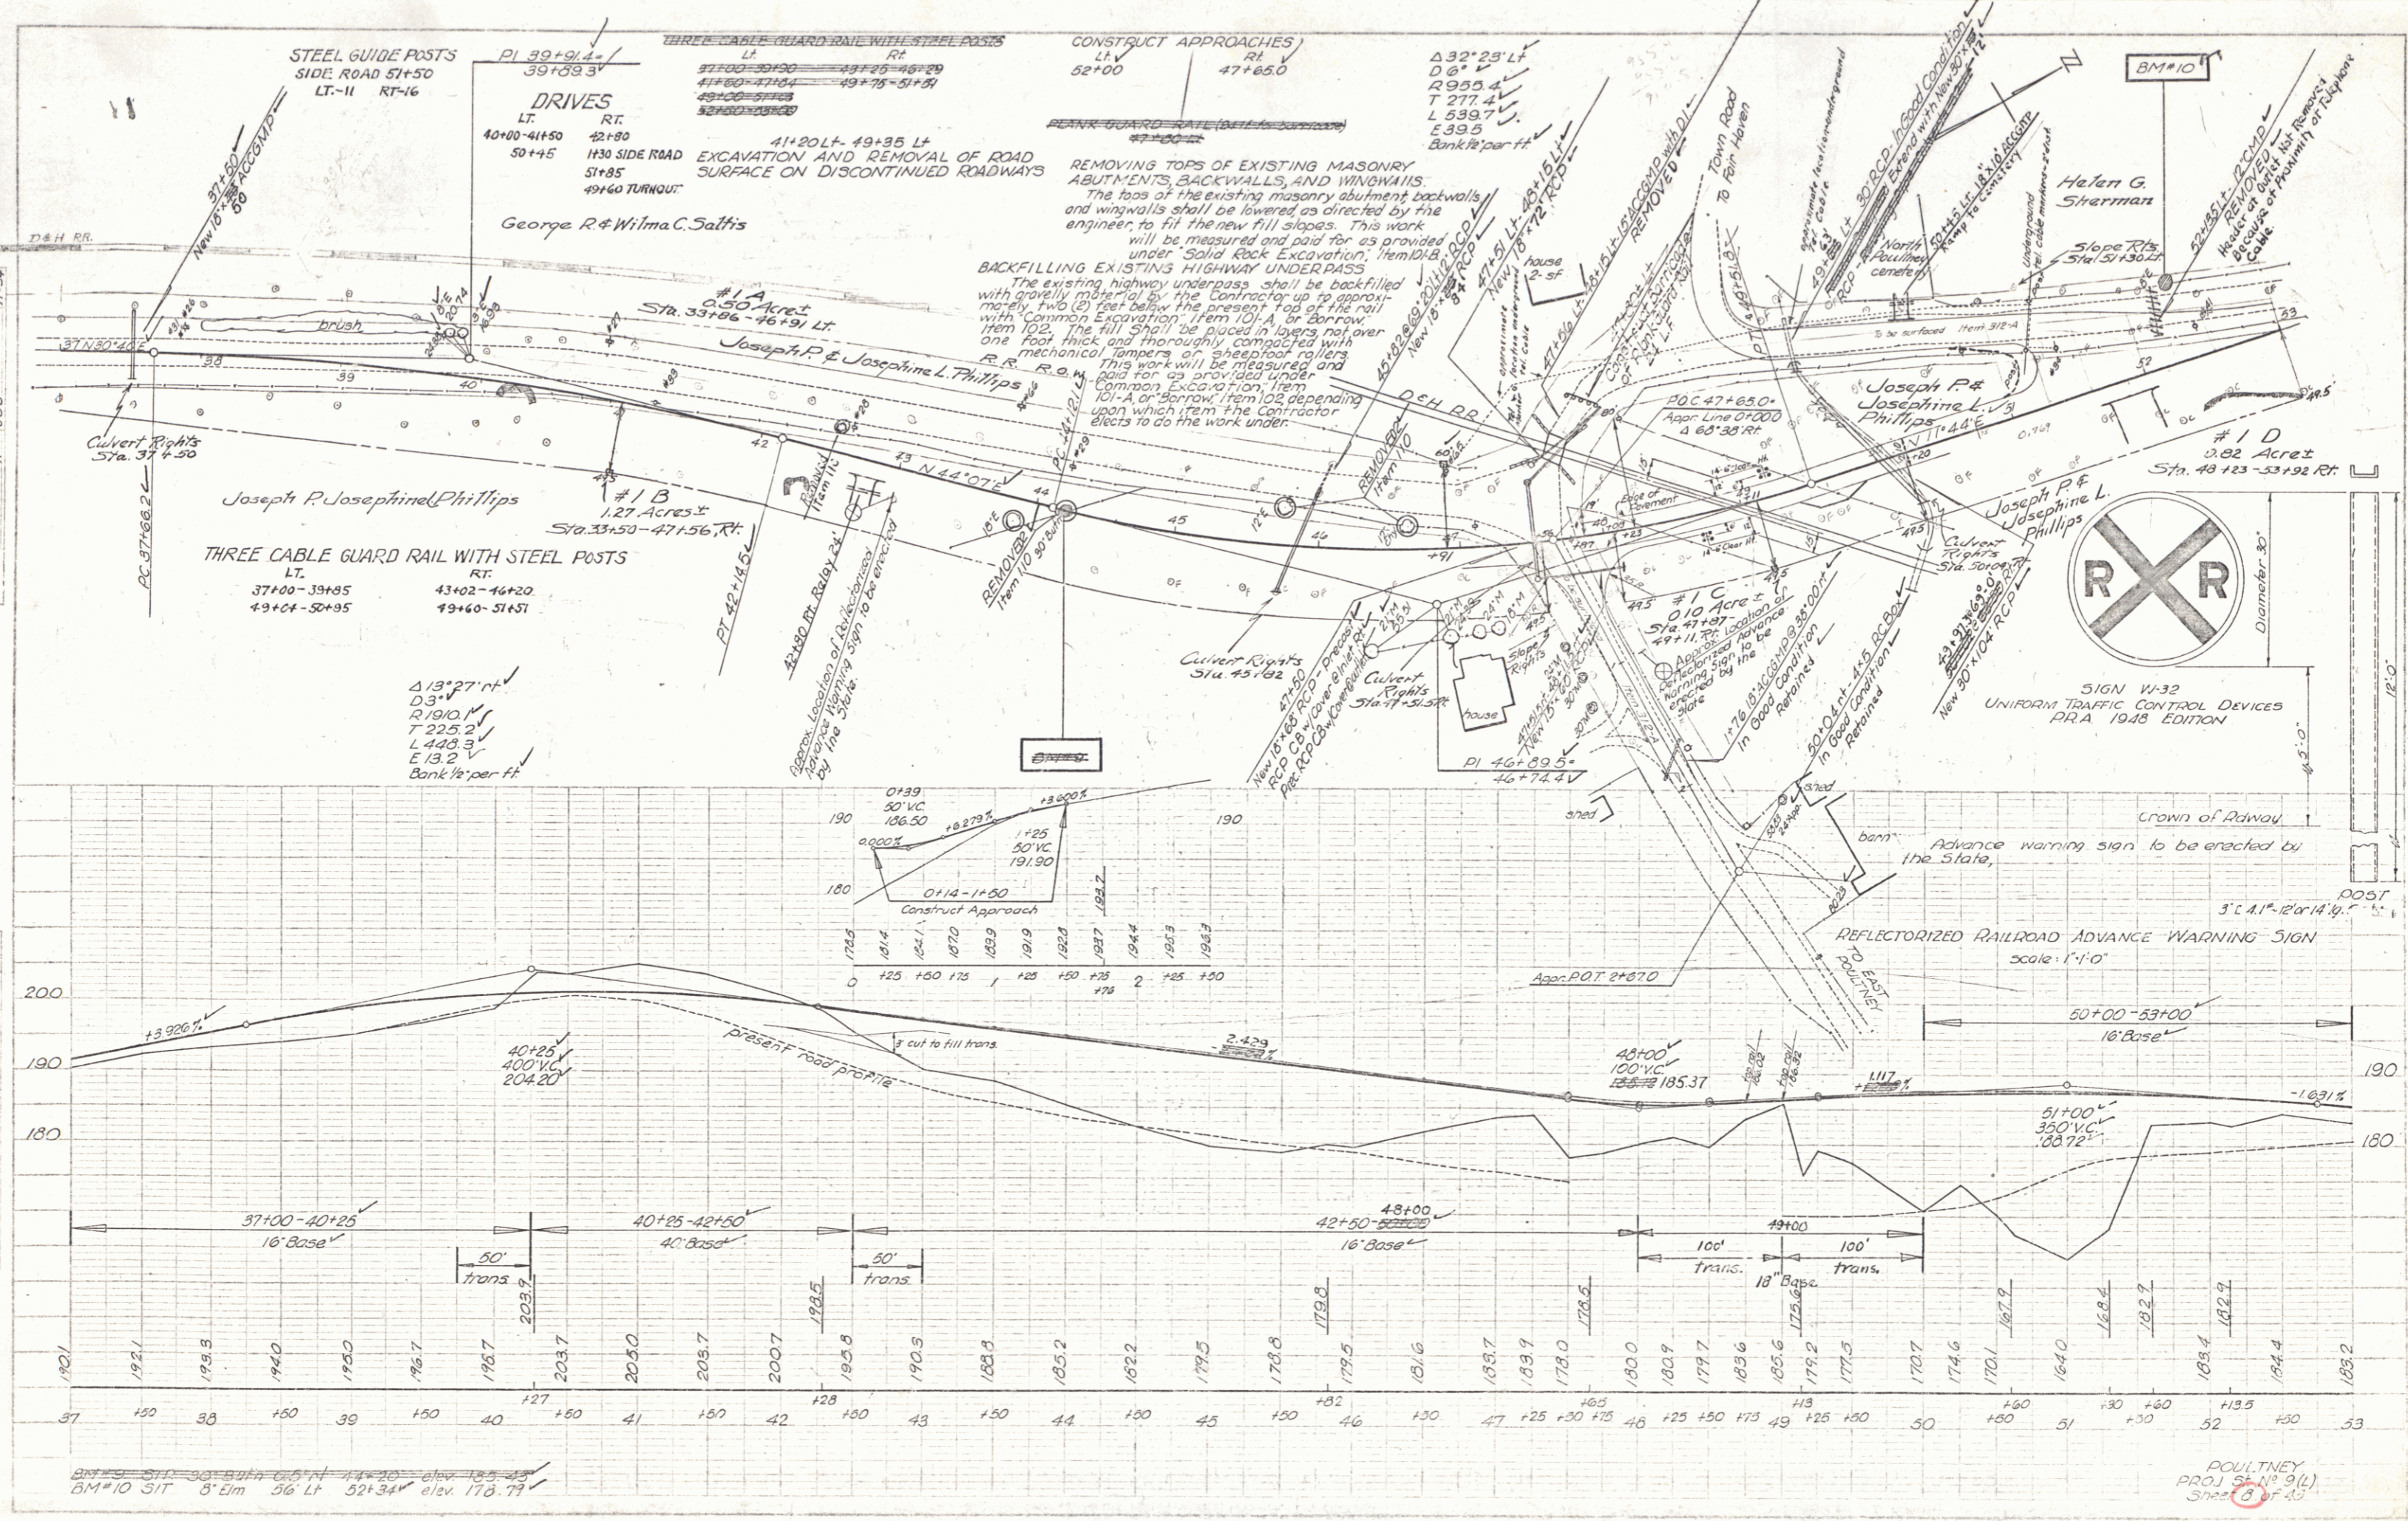

BM#10 SIT 5' Elm 56' Lt 52' 34" elev. 178.77'

POULTNEY
