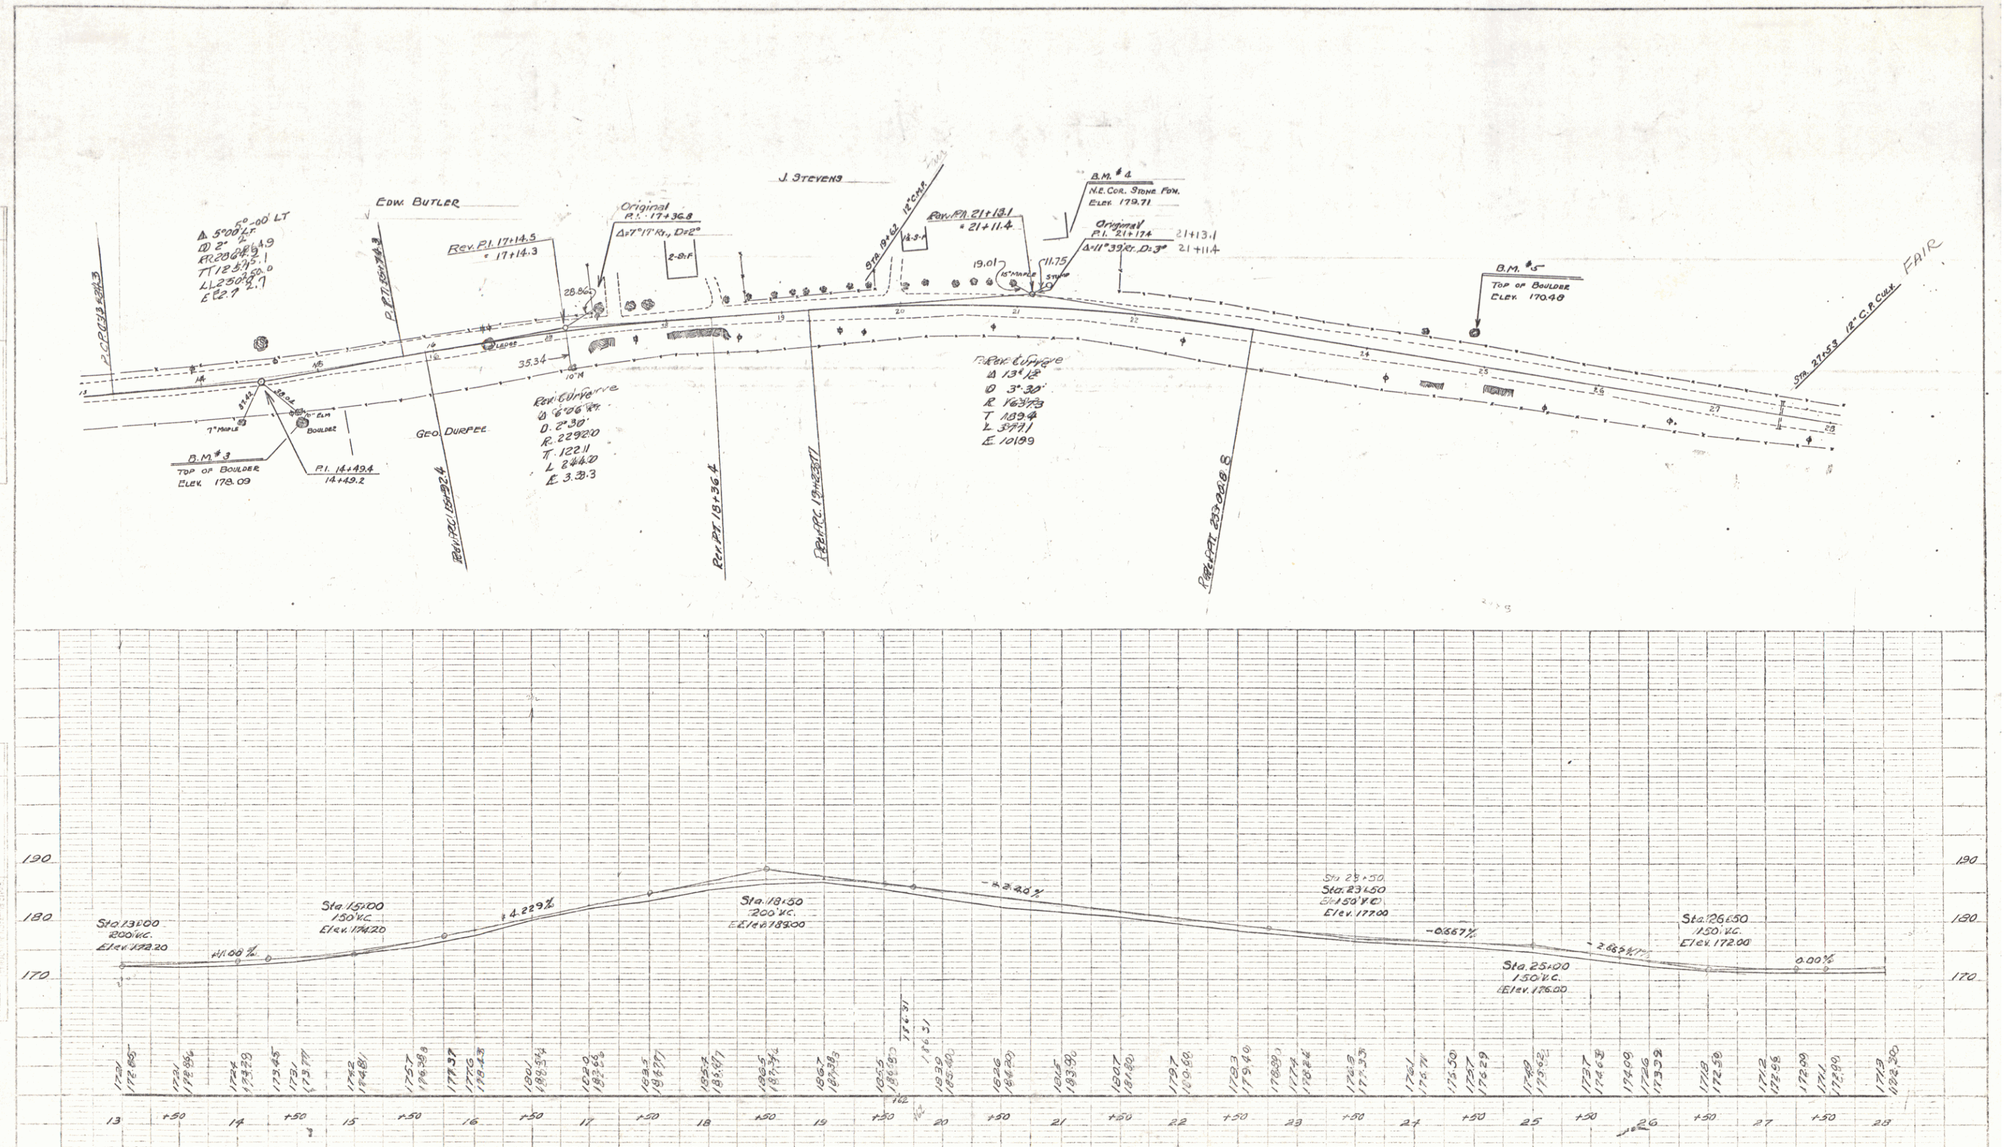

B.M. No. 3. Top of boulder, 35 ft. right of Sta. 14+78. Elev. 178.09
B.M. No. 4. N.E. corner of stone foundation, 68 ft. left of Sta. 21+36. Elev. 179.71
B.M. No. 5. Top of boulder, 29 ft. left of Sta. 24+84. Elev. 170.48

POULTNEY - CASTLETON
SHEET 4 OF

2