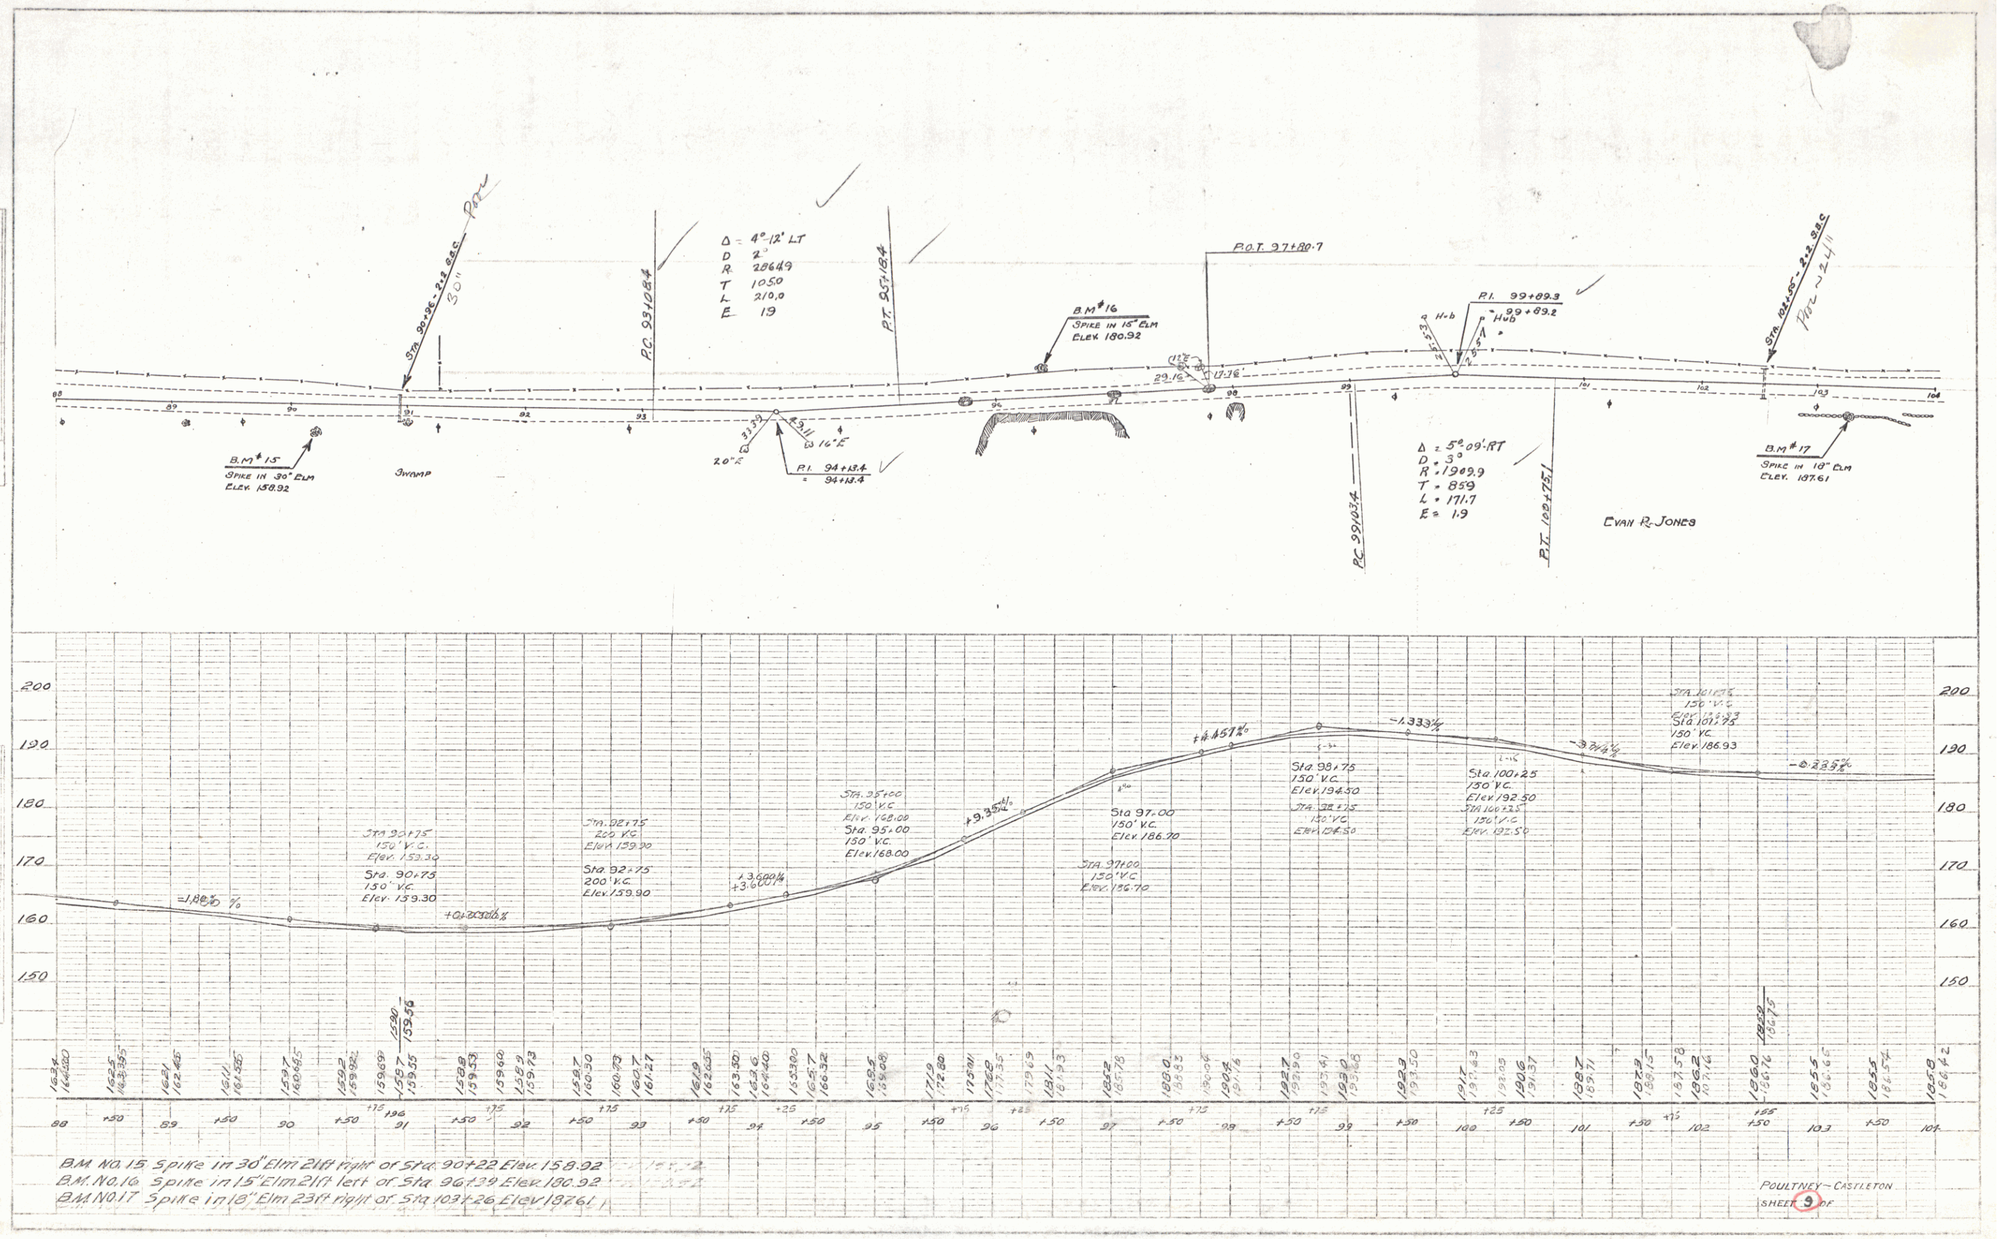

B.M. No. 15 Spike in 30" Elm 21ft right of Sta. 90+22 Elev. 158.92
B.M. No. 16 Spike in 15" Elm 21ft left of Sta. 96+39 Elev. 180.92
B.M. No. 17 Spike in 18" Elm 23ft right of Sta. 103+26 Elev. 187.61

POULTNEY – CASTLETON
SHEET 9 OF

7