WOOD GUARD RAIL REQUIRED

CULV. STA	LT.	RT.
174+27	28'	24'

REINF CONCRETE PIPE CULVERTS REQUIRED

STA.	DIAM.	LENG.	CONC. A	CONC. C	STEEL
174+27	15"	36'	23 CY.		33#

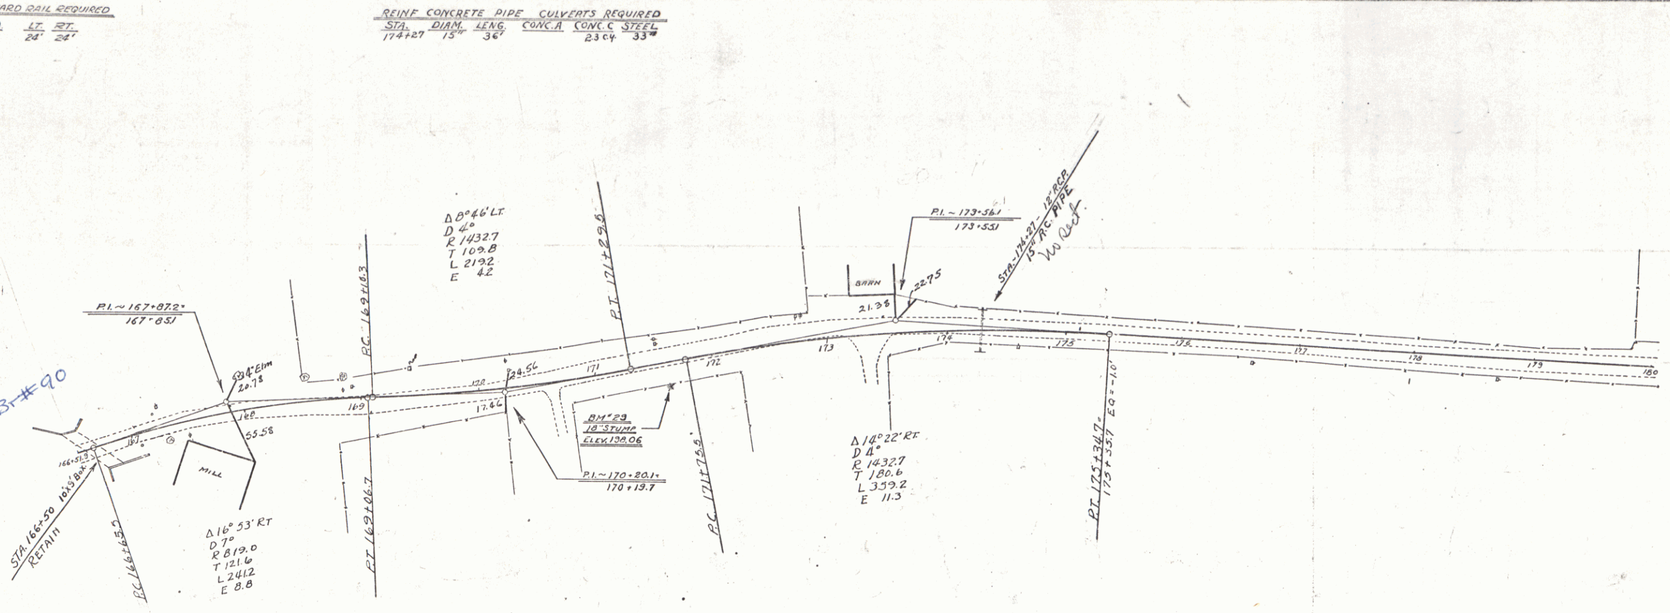

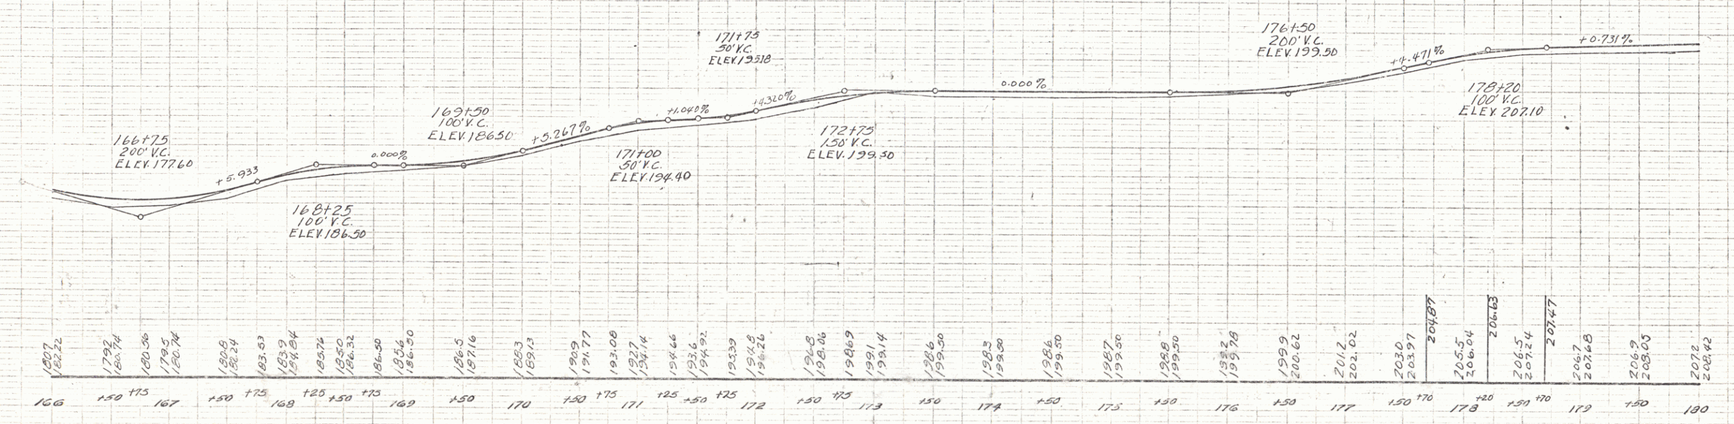

B.M. No. 28 Top of boulder right Elev. 185.35
B.M. No. 29 S. side in 18" stump 18ft. right of Sta. 171+60 Elev. 198.06

POULTNEY - CASTLETON
SHEET 14 OF

12