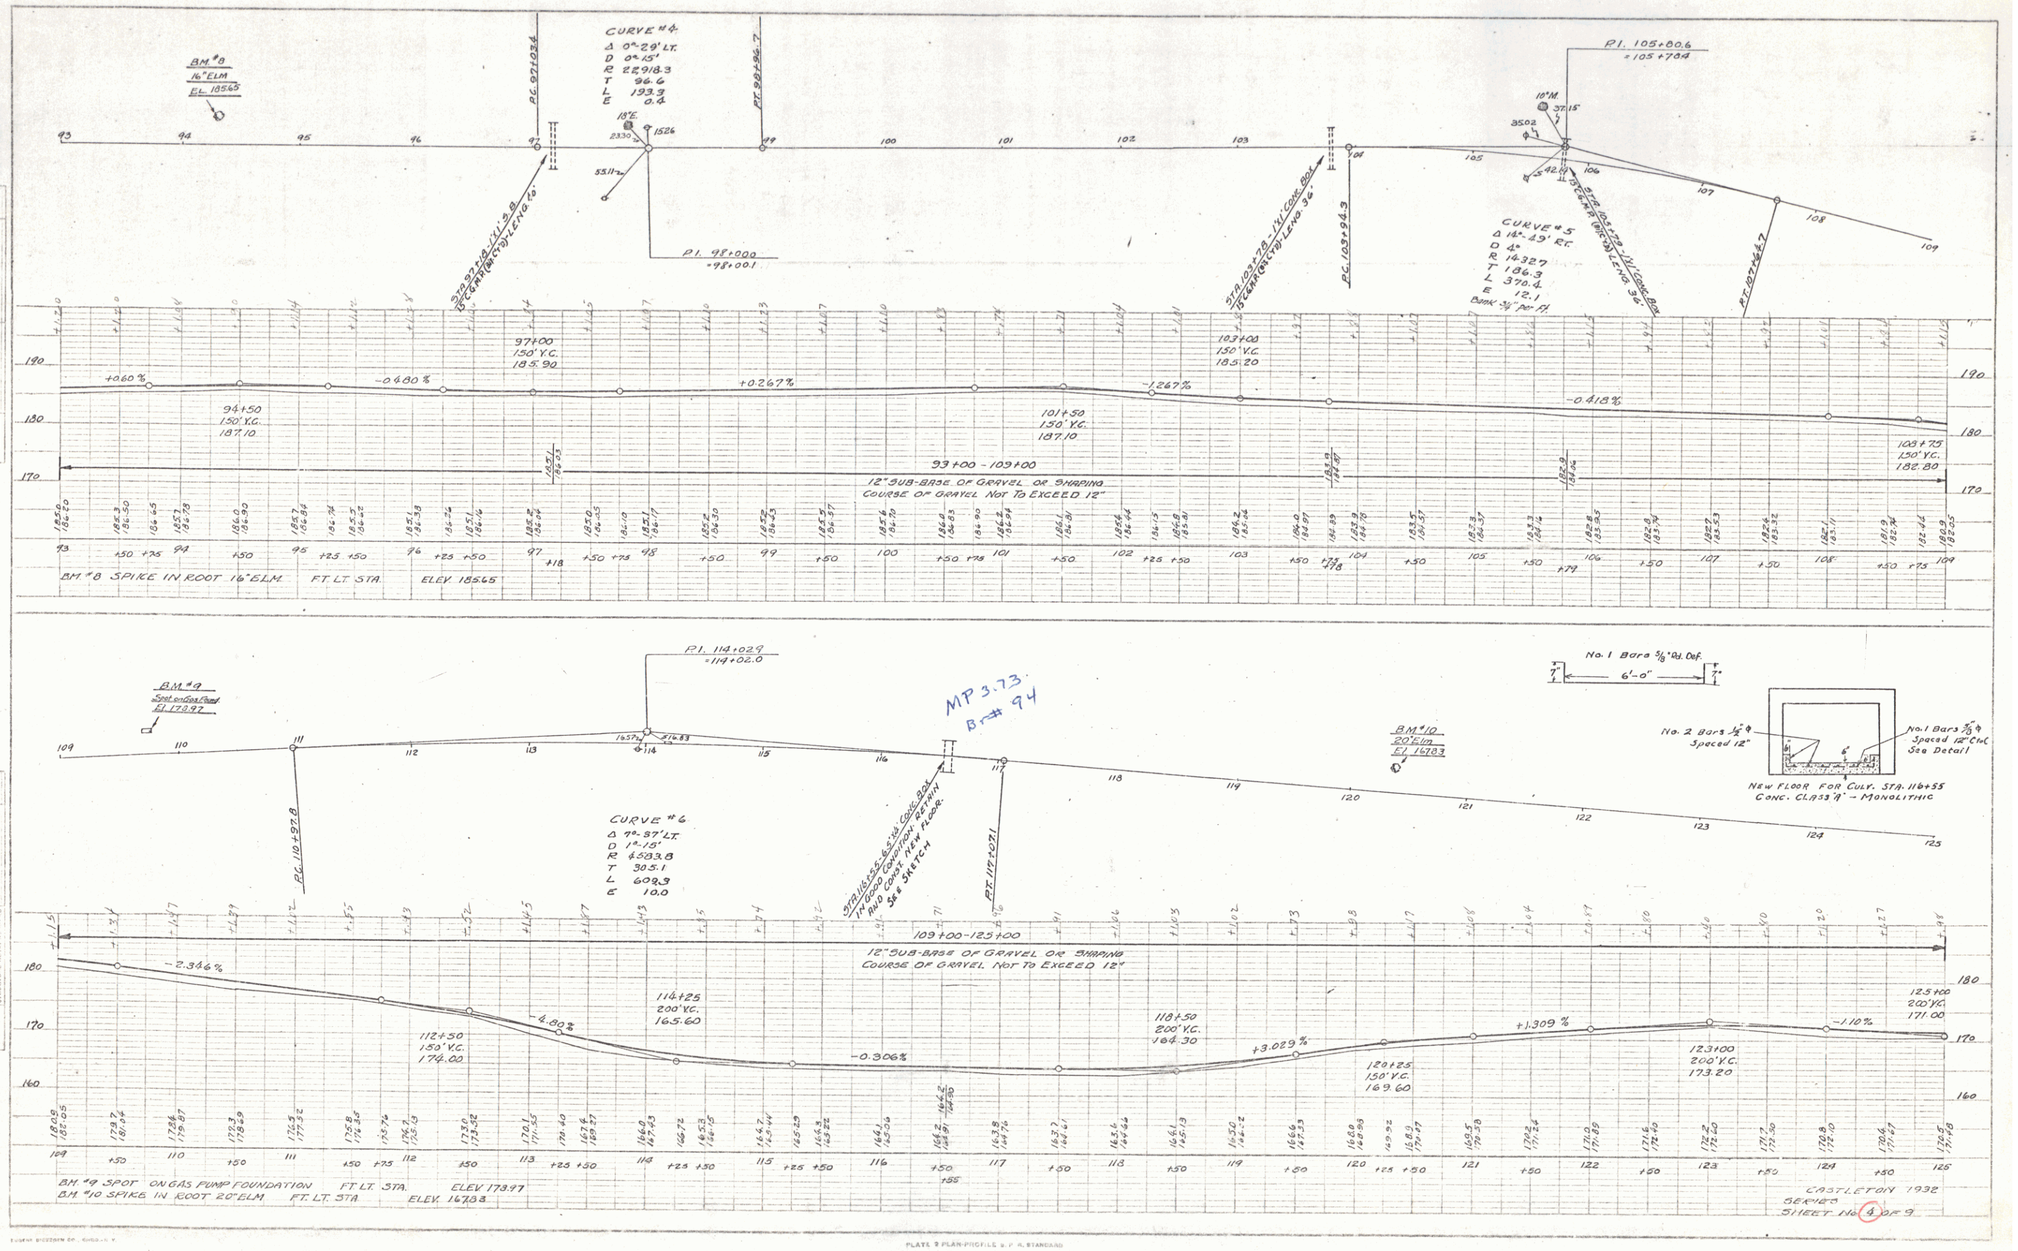

PLATE 2 PLAN-PROFILE & F. H. STANDARD

4