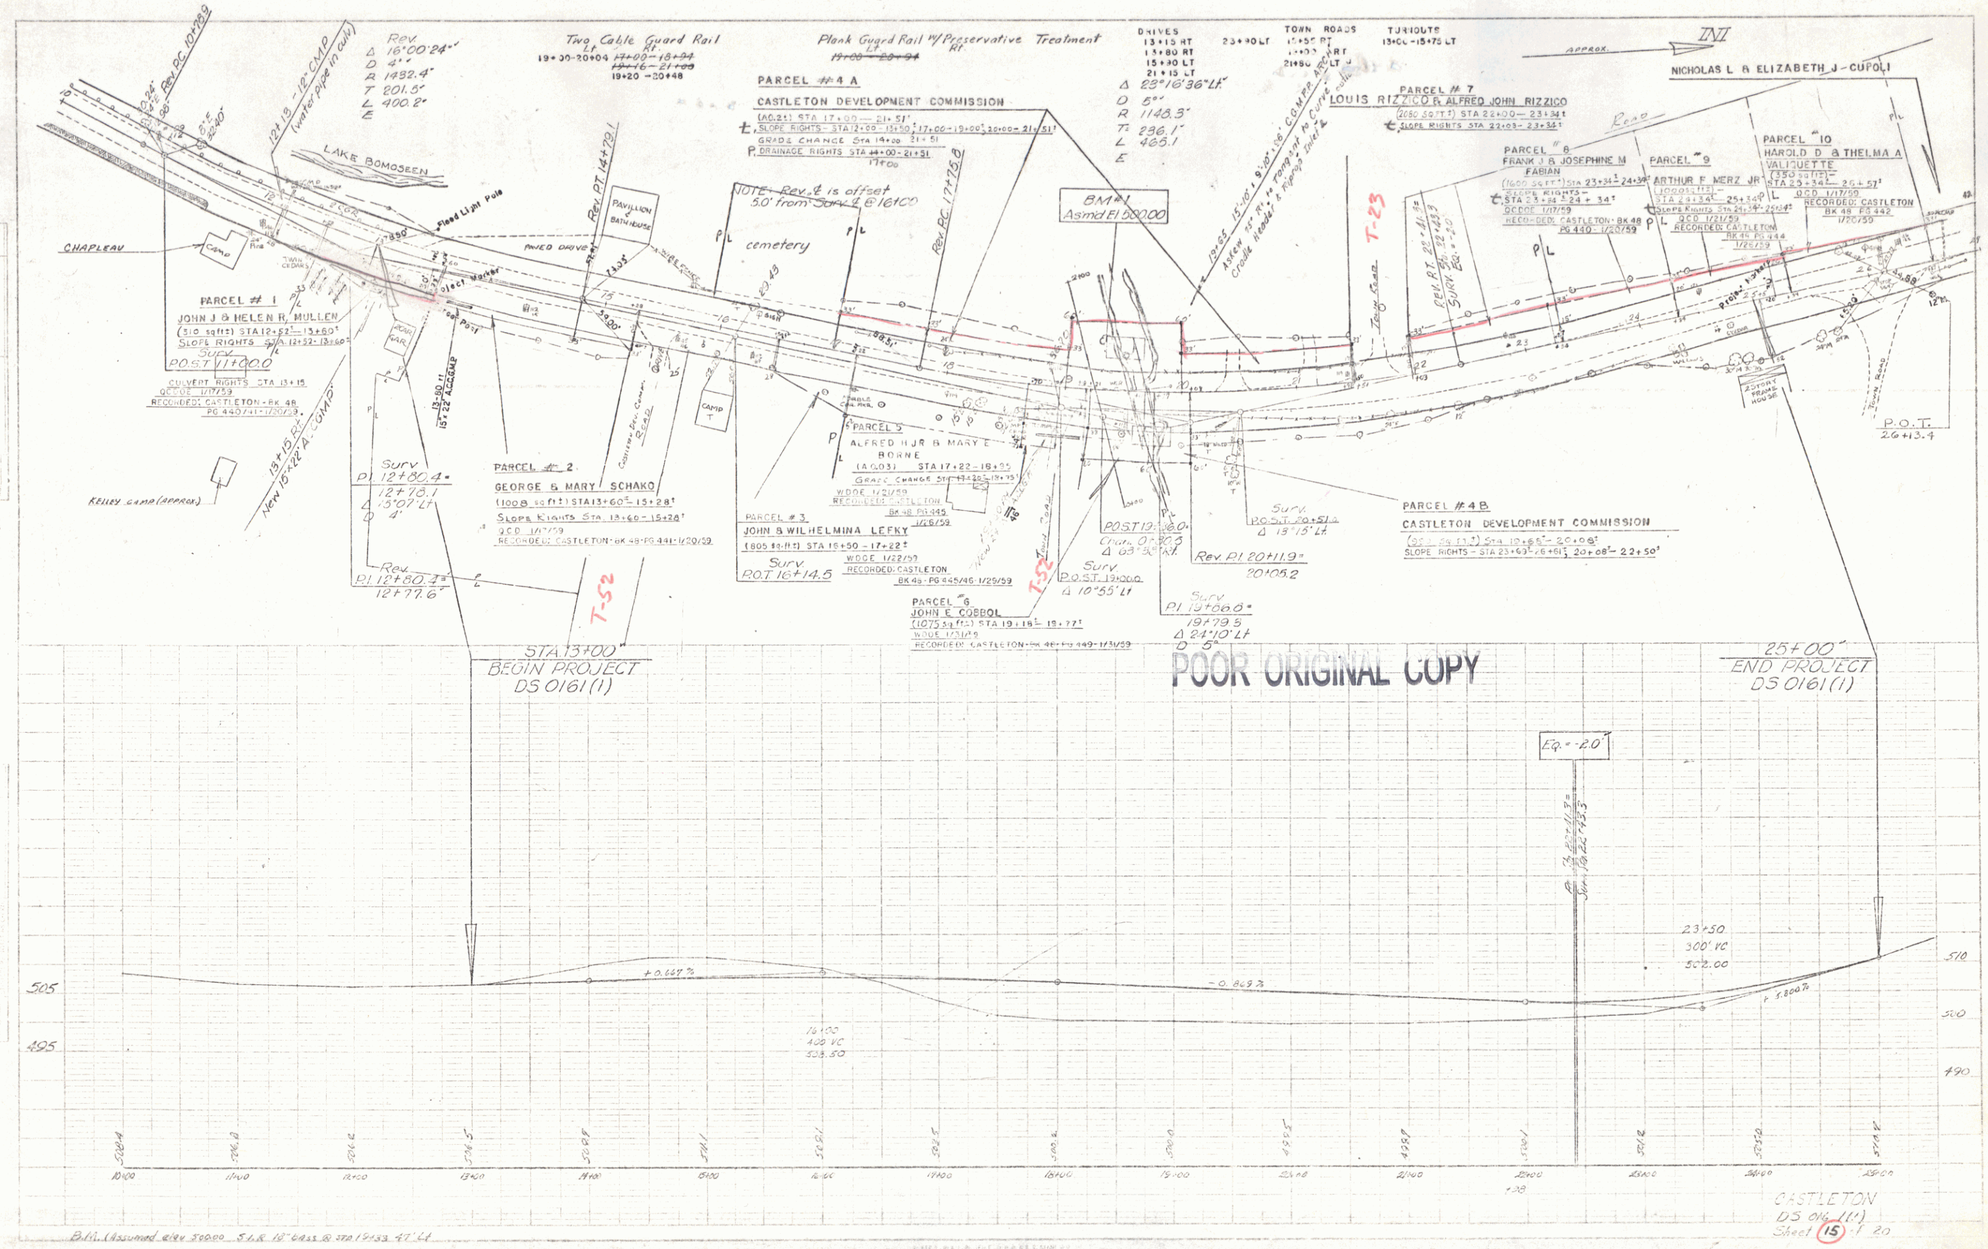
Rev. Δ 16°00'24" D 4° R 1432.4' T 201.5' L 400.2' E
Rev. PC 10+79.9
Two Cable Guard Rail
19+00-20+04 17+00-18+94 19+16-21+00
19+20-20+48
Plank Guard Rail w/ Preservative Treatment
19+00-20+94
DRIVES
13+15 RT
13+80 RT
15+90 LT
21+15 LT
23+90 LT
TOWN ROADS
17+55 RT
17+90 RT
21+50 LT
TURNOUTS
13+00-15+75 LT
APPROX.
N
NICHOLAS L & ELIZABETH J - CUPOLI
PARCEL # 4 A
CASTLETON DEVELOPMENT COMMISSION
(40.21) STA 17+00 - 21+51
SLOPE RIGHTS - STA 12+20 - 15+50, 17+00 - 19+00, 20+00 - 21+51
GRADE CHANGE STA 19+00 21+51
DRAINAGE RIGHTS STA 17+00 - 21+51
Δ 28°16'36" LT
D 5°
R 1148.3'
T 286.1'
L 483.1
E
PARCEL # 7
LOUIS RIZZICO & ALFRED JOHN RIZZICO
(2050 SQ FT) STA 22+00 - 23+34
SLOPE RIGHTS STA 22+03 - 23+34
LAKE BOMOSEEN
CHAPLEAU
CAMP
Flood Light Pole
PAVED DRIVE
PAVILLION BATHHOUSE
cemetery
NOTE: Rev. ℄ is offset 5.0' from Surv ℄ @ 16+00
Rev. PT 14+79.1
Rev. PC 17+75.8
BM #1 Asmd El 500.00
Rev. PT 22+41.1 Surv PC 22+33.3 Surv PC 22+20
T-23
T-52
PARCEL # 1
JOHN J & HELEN R. MULLEN
(510 sq ft) STA 12+52 - 13+60
SLOPE RIGHTS STA 12+52 - 13+60
Surv P.O.S.T. 11+00.0
CULVERT RIGHTS STA 13+15
QCDE 1/17/59
RECORDED: CASTLETON - BK 48 PG 440/441 - 1/20/59
PARCEL # 8
FRANK J & JOSEPHINE M FABIAN
(1600 SQ FT) STA 23+34 - 24+34
SLOPE RIGHTS - STA 23+34 - 24+34
QCDE 1/17/59
RECORDED: CASTLETON - BK 48 PG 440 - 1/20/59
PARCEL # 9
ARTHUR F. MERZ JR.
(1200 SQ FT) STA 24+34 - 25+34
SLOPE RIGHTS STA 24+34 - 25+34
QCD 1/21/59
RECORDED: CASTLETON BK 48 PG 444 1/26/59
PARCEL # 10
HAROLD D & THELMA A VALIQUETTE
(750 SQ FT) STA 25+34 - 26+57
QCD 1/17/59
RECORDED: CASTLETON BK 48 PG 442 1/20/59
Rev. PT 22+41.1 Surv PC 22+33.3 Surv PC 22+20
Rev. PC 20+11.9 20+06.2
Surv P.O.S.T. 20+51.0 Δ 15°15' LT
Surv P.O.S.T. 19+66.0 Δ 03°30' RT
Surv P.O.S.T. 19+00.0 Δ 10°55' LT
Surv P.I. 19+66.0 19+79.5 Δ 21°10' LT D 5°
P.O.T. 26+13.4
PARCEL # 4 B
CASTLETON DEVELOPMENT COMMISSION
(0.22 sq ft) STA 19+65 - 20+08
SLOPE RIGHTS - STA 23+63 - 26+61 20+08 - 22+50
Surv P.I. 12+80.4 12+78.1 Δ 15°07' LT D 4°
Rev. P.I. 12+80.4 12+77.6
PARCEL # 2
GEORGE & MARY SCHAKO
(1008 sq ft) STA 13+60 - 15+28
SLOPE RIGHTS STA 13+60 - 15+28
QCD 1/17/59
RECORDED: CASTLETON - BK 48 PG 441 - 1/20/59
PARCEL # 5
ALFRED H JR & MARY E BORNE
(4.603) STA 17+22 - 18+95
GRADE CHANGE STA 17+22 - 18+95
WDDE 1/21/59
RECORDED: CASTLETON BK 48 PG 445 1/26/59
PARCEL # 3
JOHN & WILHELMINA LEFKY
(805 sq ft) STA 15+50 - 17+22
Surv P.O.T. 16+14.5
WDDE 1/22/59
RECORDED: CASTLETON BK 48 - PG 445/446 - 1/26/59
PARCEL # 6
JOHN E COBBOL
(1075 sq ft) STA 19+16 - 19+77
WDDE 1/31/59
RECORDED: CASTLETON - BK 48 - PG 449 - 1/31/59
Rev. PT 19+79.5
Rev. PC 20+45.3
Eq. = -2.0'
STA 13+00 BEGIN PROJECT DS 0161(1)
25+00 END PROJECT DS 0161(1)
POOR ORIGINAL COPY
+0.667%
-0.869%
+5.800%
14+00 400 VC 503.50
23+50 300' VC 502.00
505
495
510
500
490
B.M. Assumed El 500.00 S.I.R. 18" Oak @ STA 19+53 47' Lt
CASTLETON DS 0161(1) Sheet 15 of 20

2