


PLAN
 SURVEYED
 ALIGNED
 CHECKED
 BY
 DATE

PROFILE
 PLOTTED
 CHECKED
 BY
 DATE

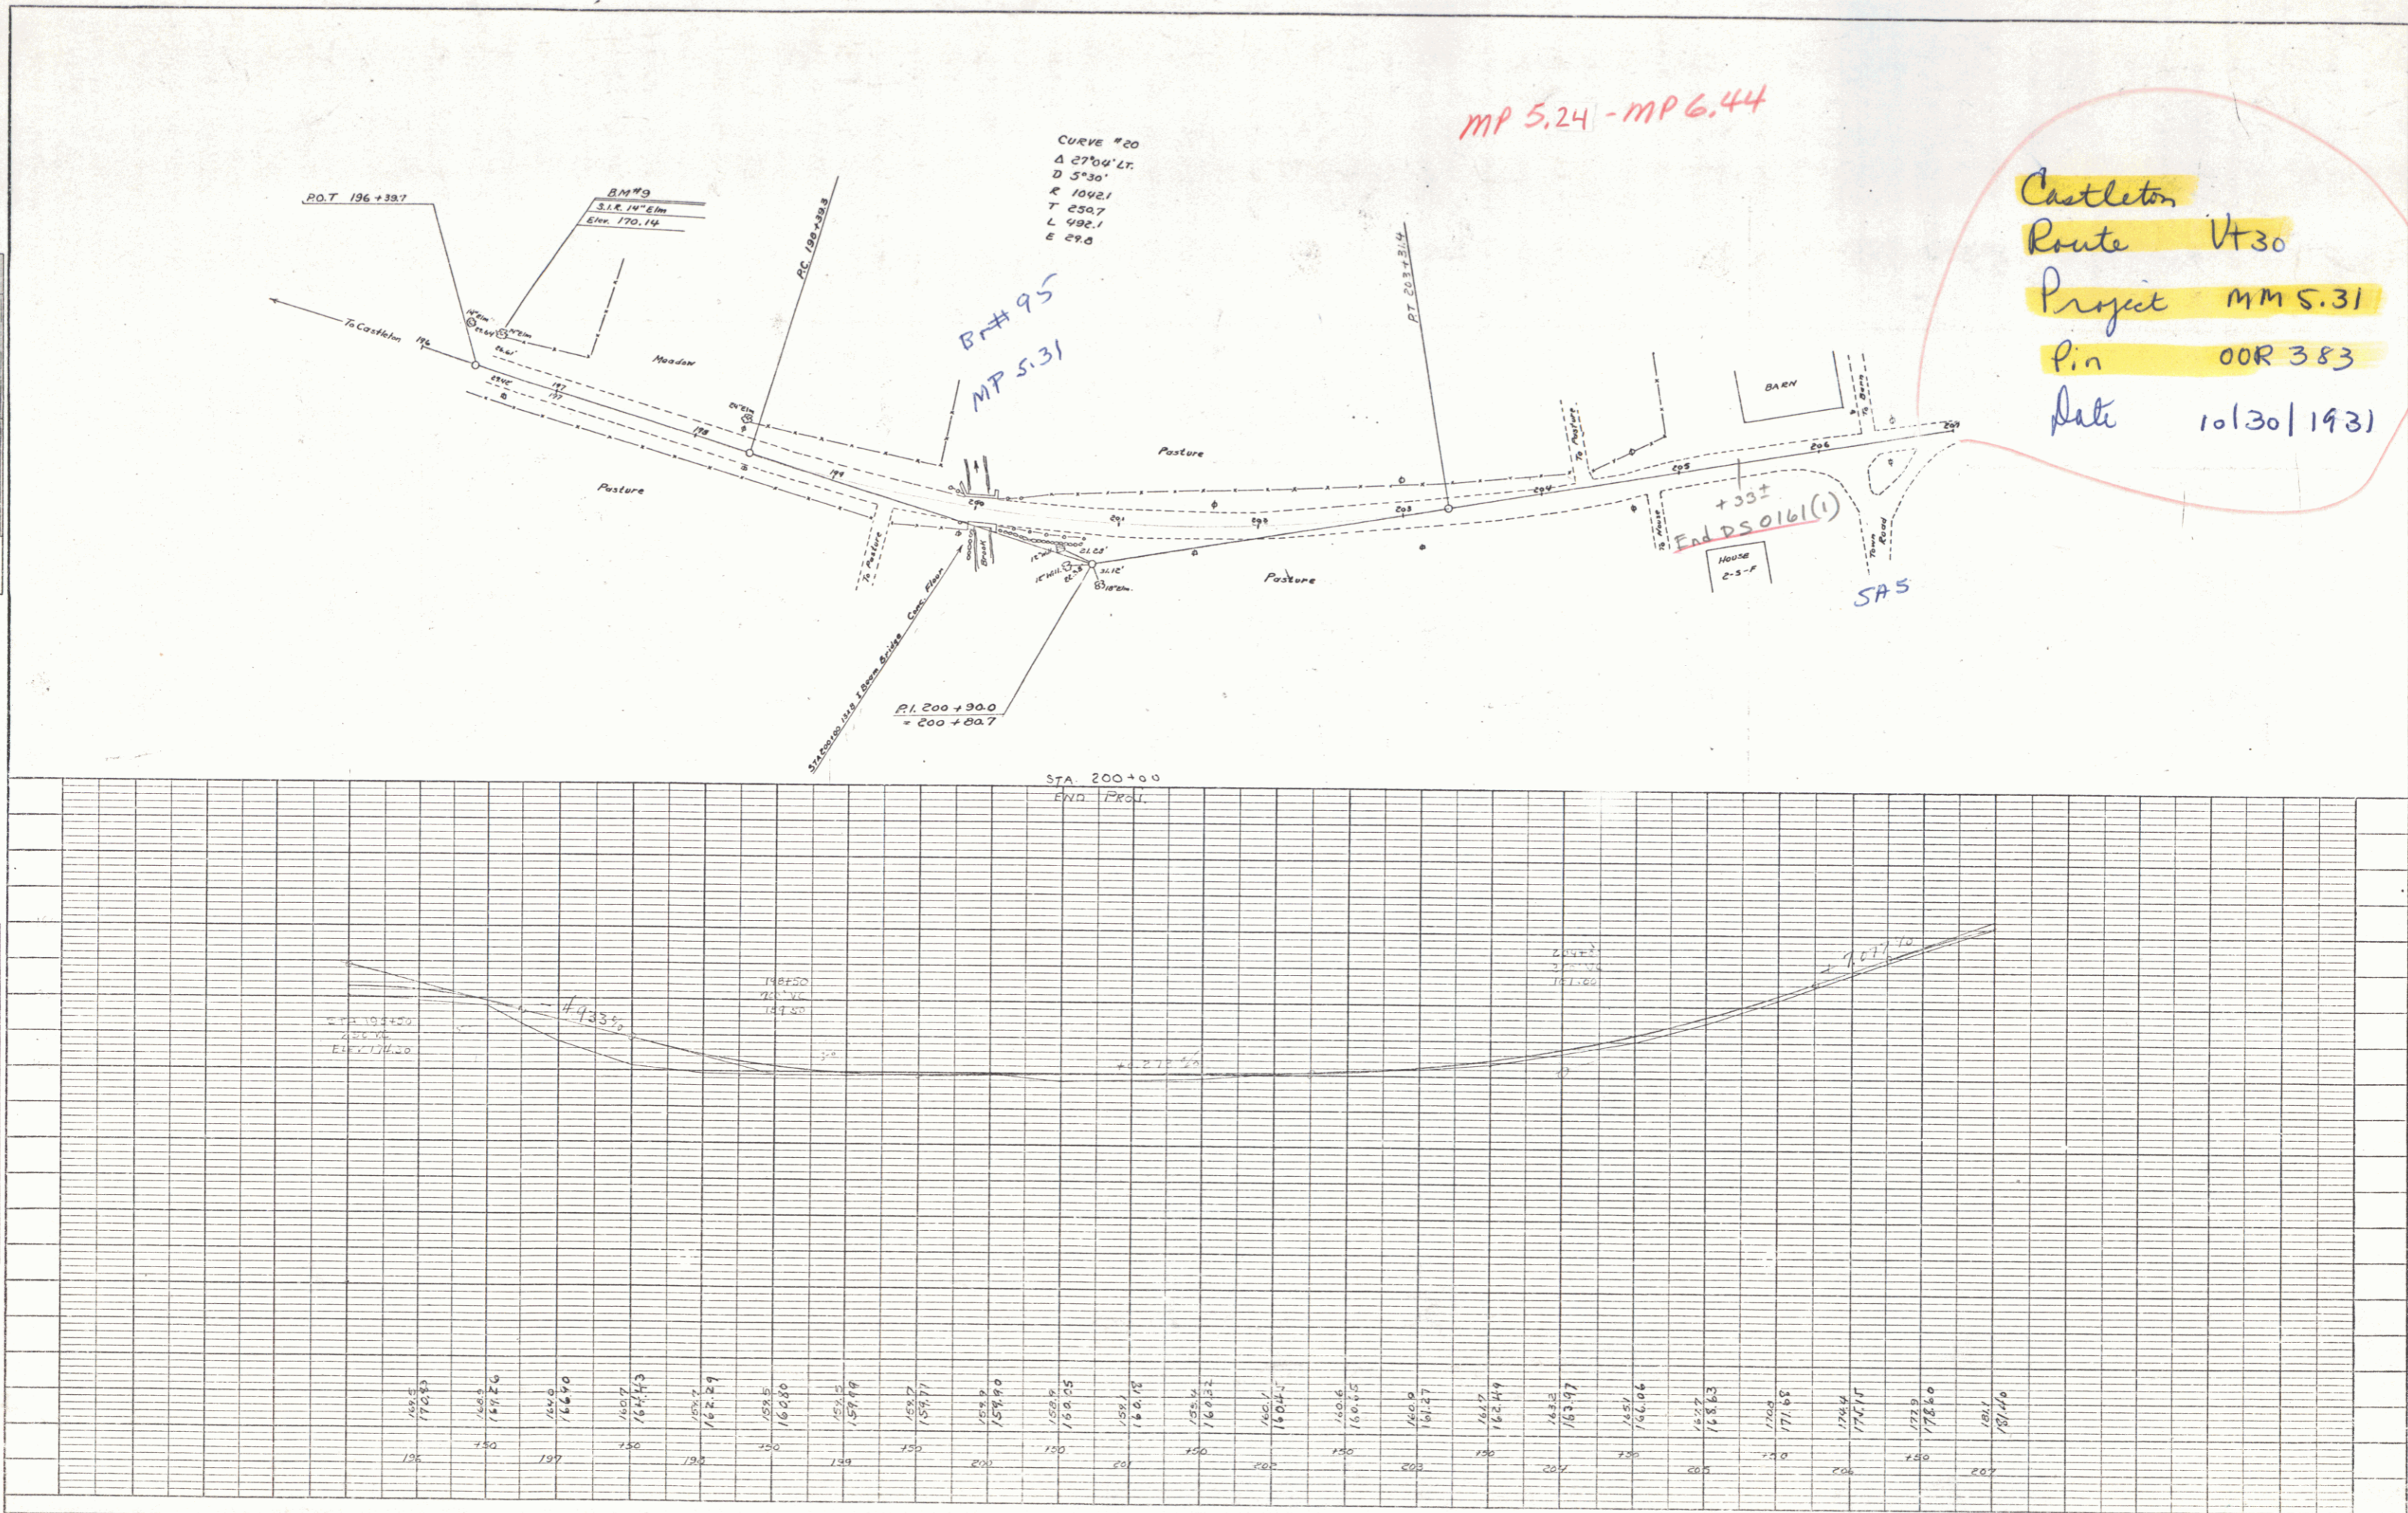

MP 5.24 - MP 6.44

Castleton
 Route Vt 30
 Project MMS.31
 Pin OOR 383
 Date 10/30/1931