FED. ROAD DIST. NO.	STATE	W.P.S.S. PROJ. NO.	FISCAL YEAR	SHEET NO.	TOTAL SHEETS
		192-A	1936	7	23

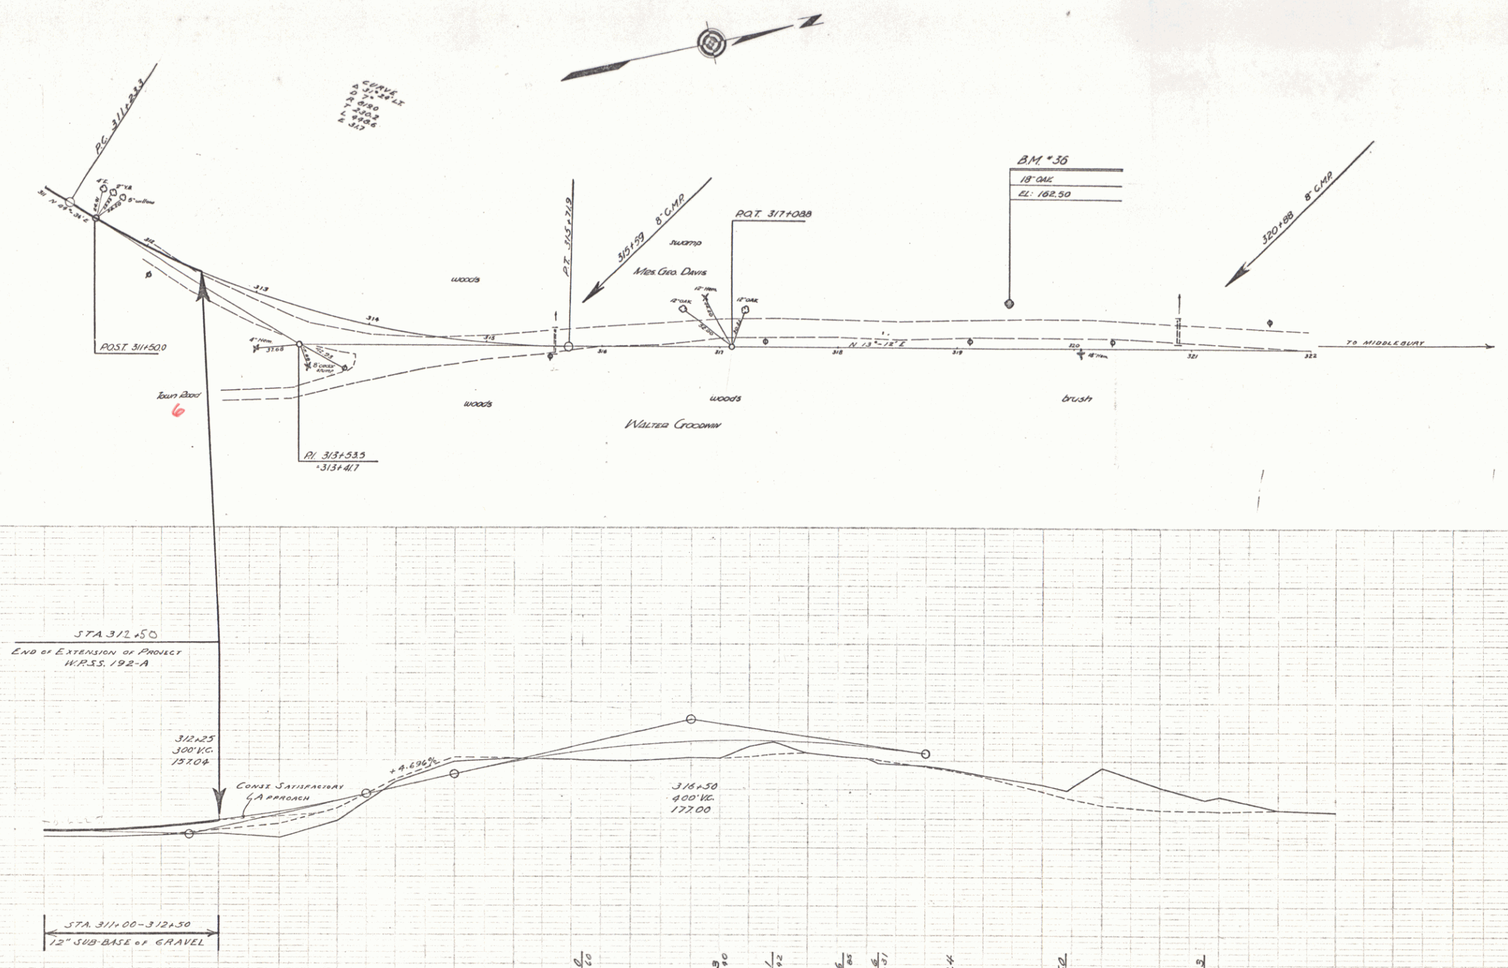

SERIES W.P.S.S. NO. 192-A

SHEET 7 OF 23

5