Town ~~Hubbardton~~
Project MM 0.77
Route VT30
Pin 00R 385
Date 01/01/1931
MP 2.55-3.31

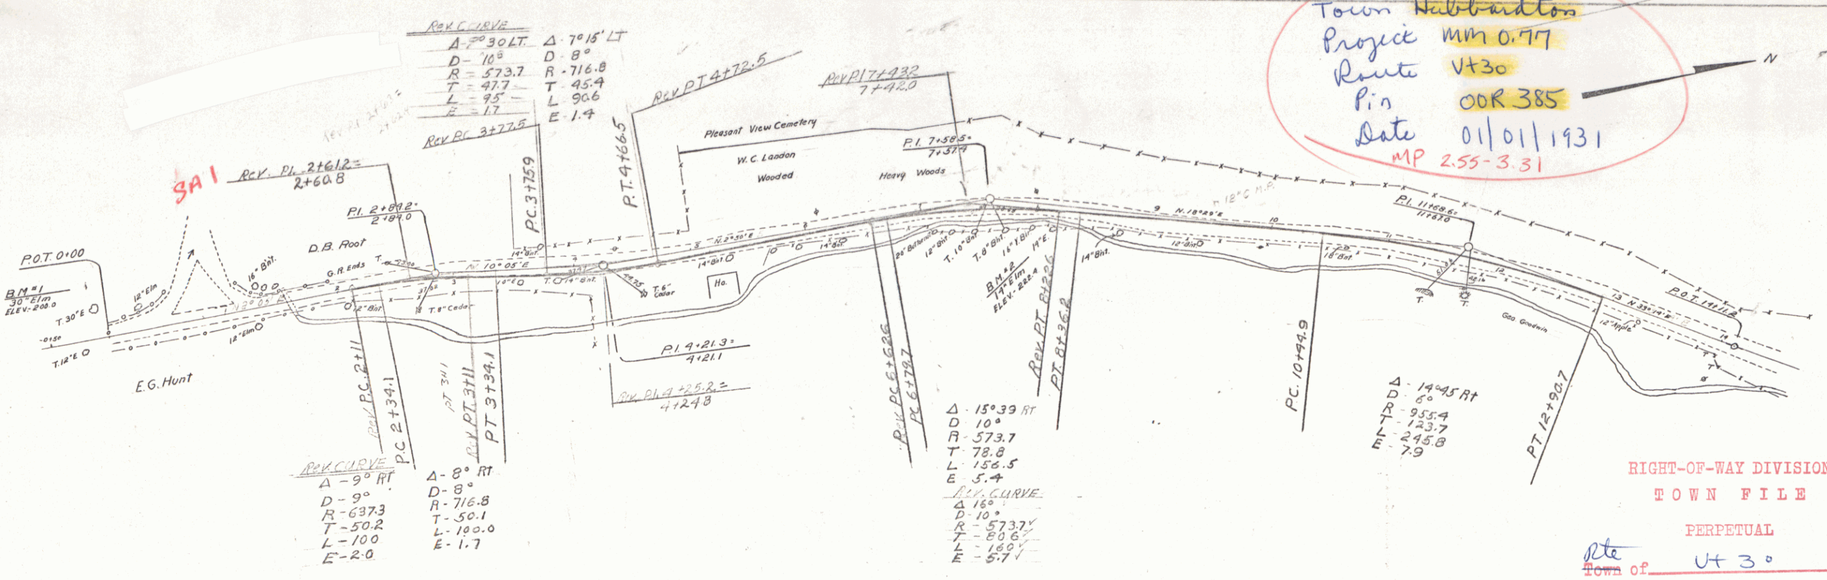

RIGHT-OF-WAY DIVISION
TOWN FILE
PERPETUAL
~~Town~~ Rte of VT 30
(To Be Returned To R.O.W. Division)

See project 192L (1940) Sheets 8-10

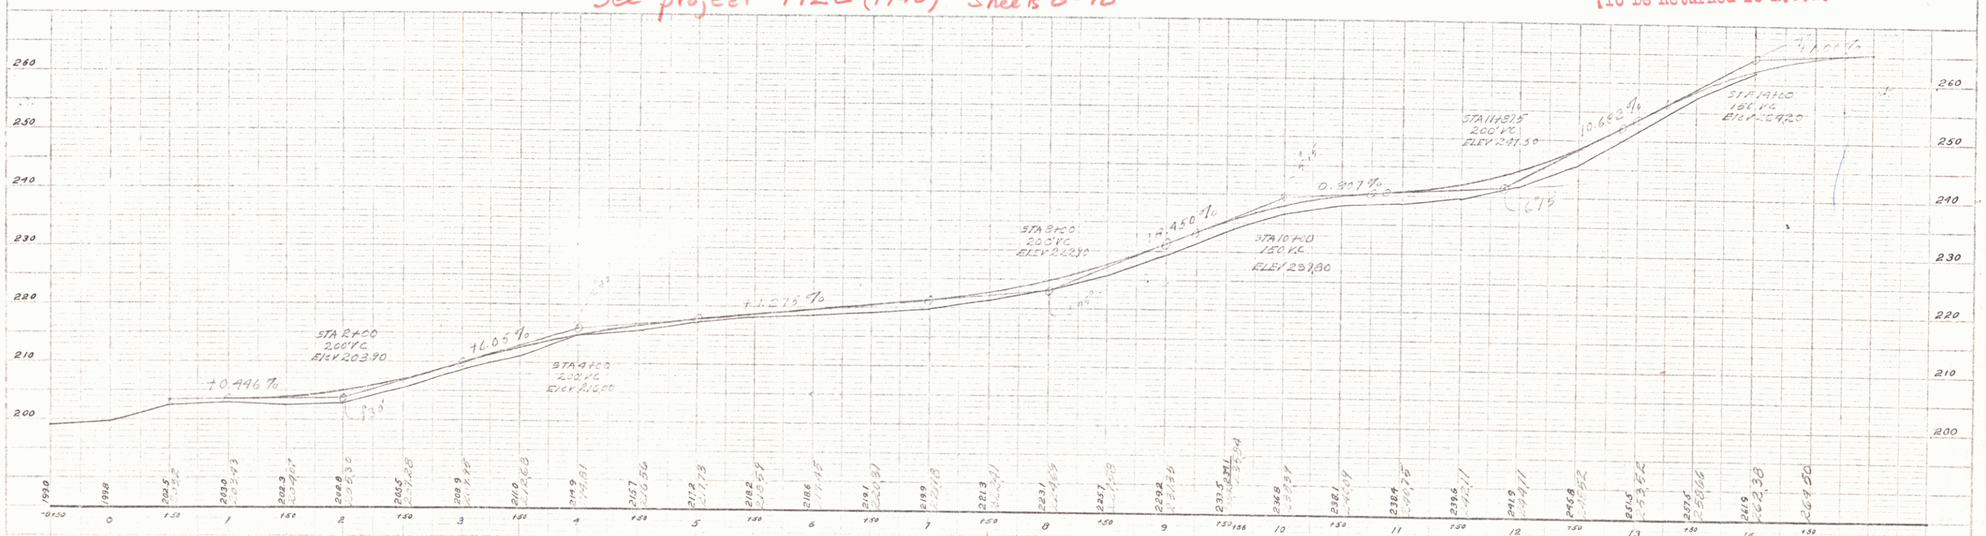

B.M. #1 SPIKE IN ROOT 30" ELM 25' LT. STA. -0+09 ELEV. - 200.00
B.M. #2 SPIKE IN ROOT 14" ELM 17' RT. STA. 0+12 ELEV. - 222.4

TOWN OF HUBBARDTON
PROPOSED ROAD IMPROVEMENT
ON HUBBARDTOWN-CASTLETON ROAD
.77 MILES NORTH OF CASTLETON-HUBBARDTOWN
TOWN LINE
SHEET 1 OF

Hubbardton