PARCEL	INSTRUMENT	DATE	GRANTOR	GRANTEE	RECORDED BOOK	PAGE	DATE	REMARKS
A	W.D.&E	1-25-41	D. B. GIBBS	HUBBARDTON ST. OF VT	13	288-9.0	2-7-41	

Δ 23°-43' Lt
D 10°
R 573.0
T 131.0
L 257.2
E 14.9
Back 1 3/16" per Ft.

FED. ROAD DIST. NO.	STATE	FED. AID PROJ. NO.	FISCAL YEAR	SHEET NO.	TOTAL SHEETS
9	VT.				

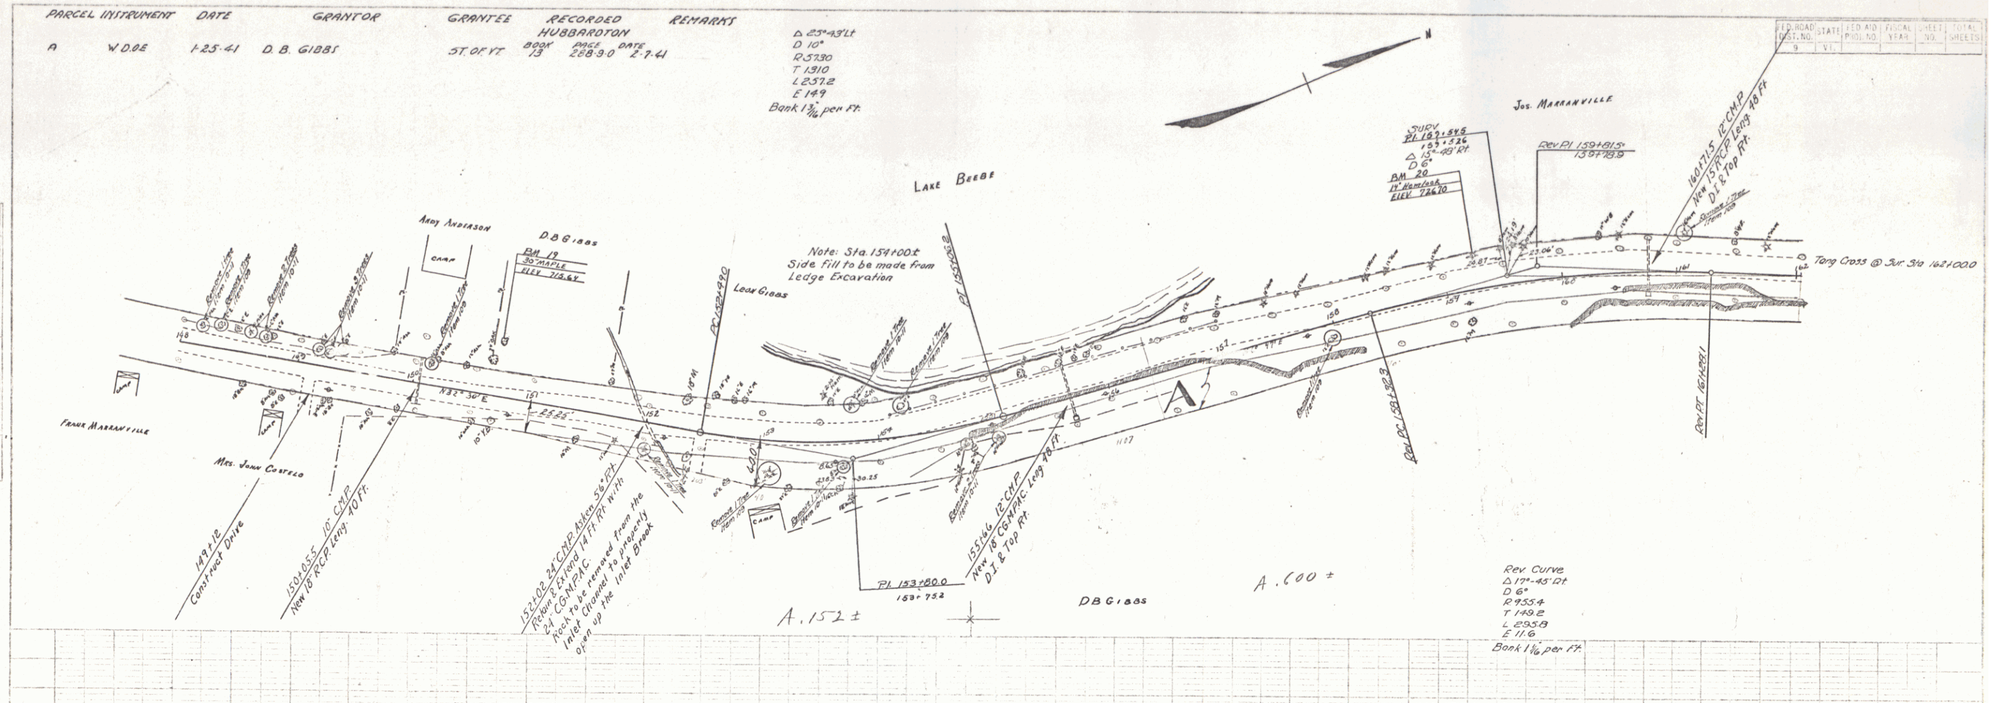

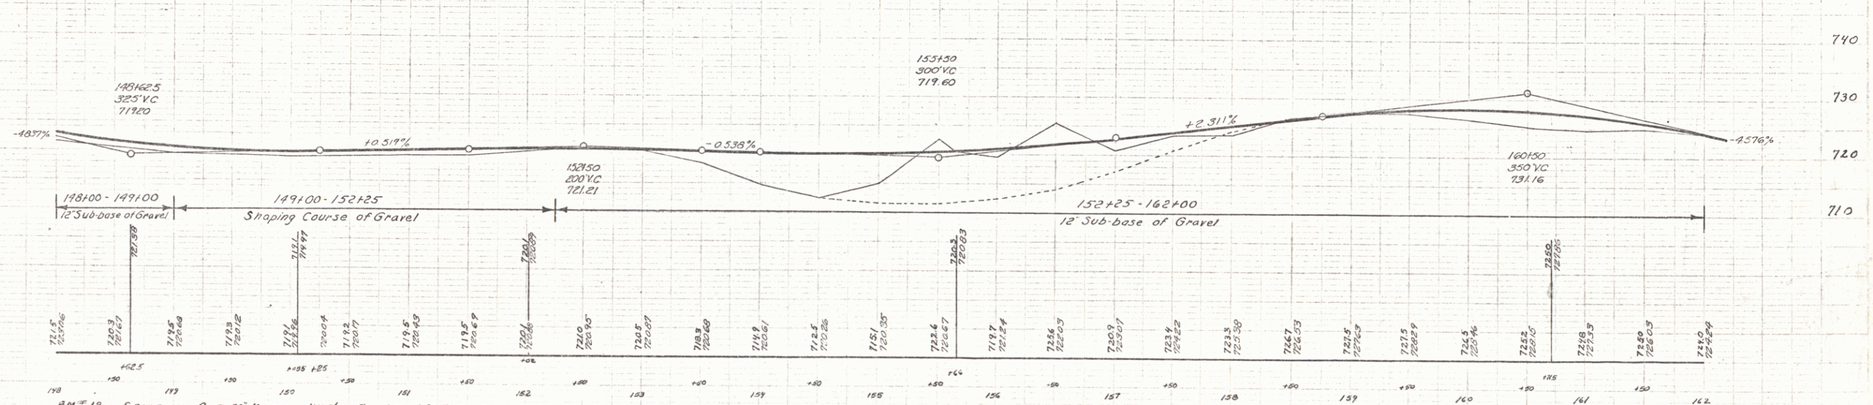

BM # 19 SPIKE IN ROOT 30" MAPLE 44.5' Lt STA 150+79 ELEV. 715.64
BM # 20 SPIKE IN ROOT 19" HEMLOCK 29.5' Lt STA 159+24 ELEV. 726.70

HUBBARDTON
SERIES STATE No. 192 L
SHEET 12 OF

11