Δ 23°-41' Lt	PARCEL	INSTRUMENT	DATE	GRANTOR	GRANTEE	RECORDED BOOK	RECORDED PAGE	RECORDED DATE	REMARKS
D 6°-30'					HUBBARDTON				
R 8819									
T 1909	C	W.D.O.E	1-25-41	D.B. GIBBS	ST OF VT	13	288-90	2-7-41	
L 3951									
E 207	A	W.D.O.E	8-22-41	D.B. GIBBS	ST OF VT	13	357	8-26-41	
Bank 1 1/16" per Ft.									

F.A.P. ROAD DIST. NO.	STATE	F.A.P. AID PROJ. NO.	FISCAL YEAR	SHEET NO.	TOTAL SHEETS
II	VT.				

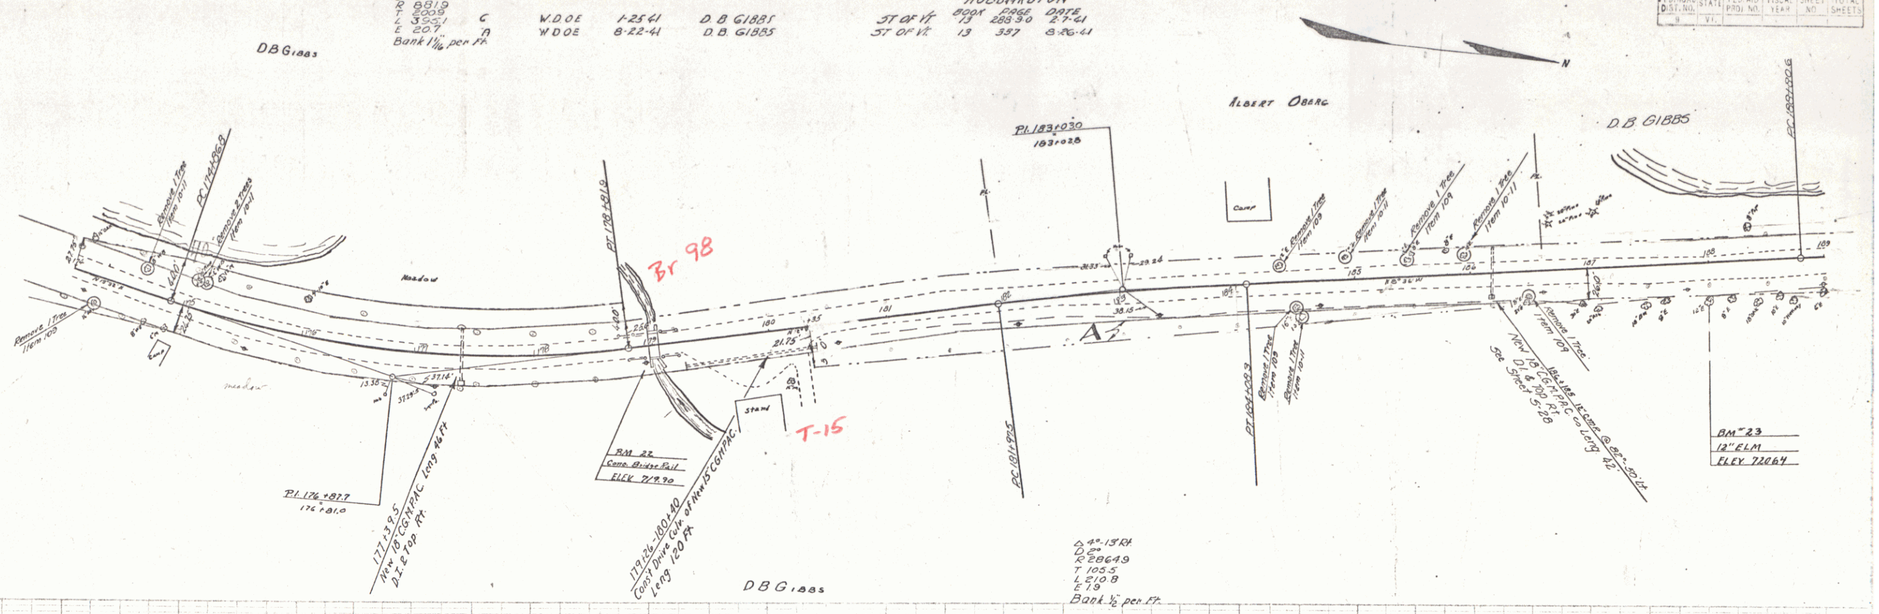

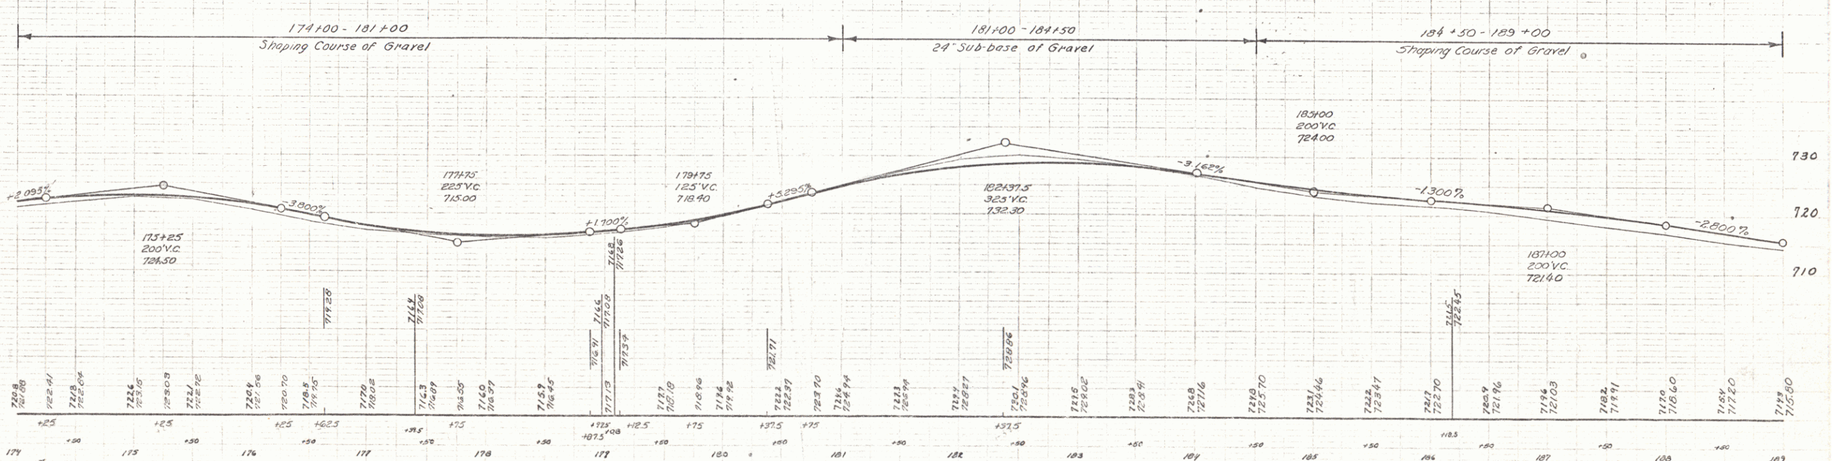

HUBBARDTON
FAP. 68/58
SHEET 12 OF 11

13