F.A.P. ROAD DIST. NO.	STATE	J	TYPICAL NO.	SHEET NO.	TOTAL
		3410	1947	4	30

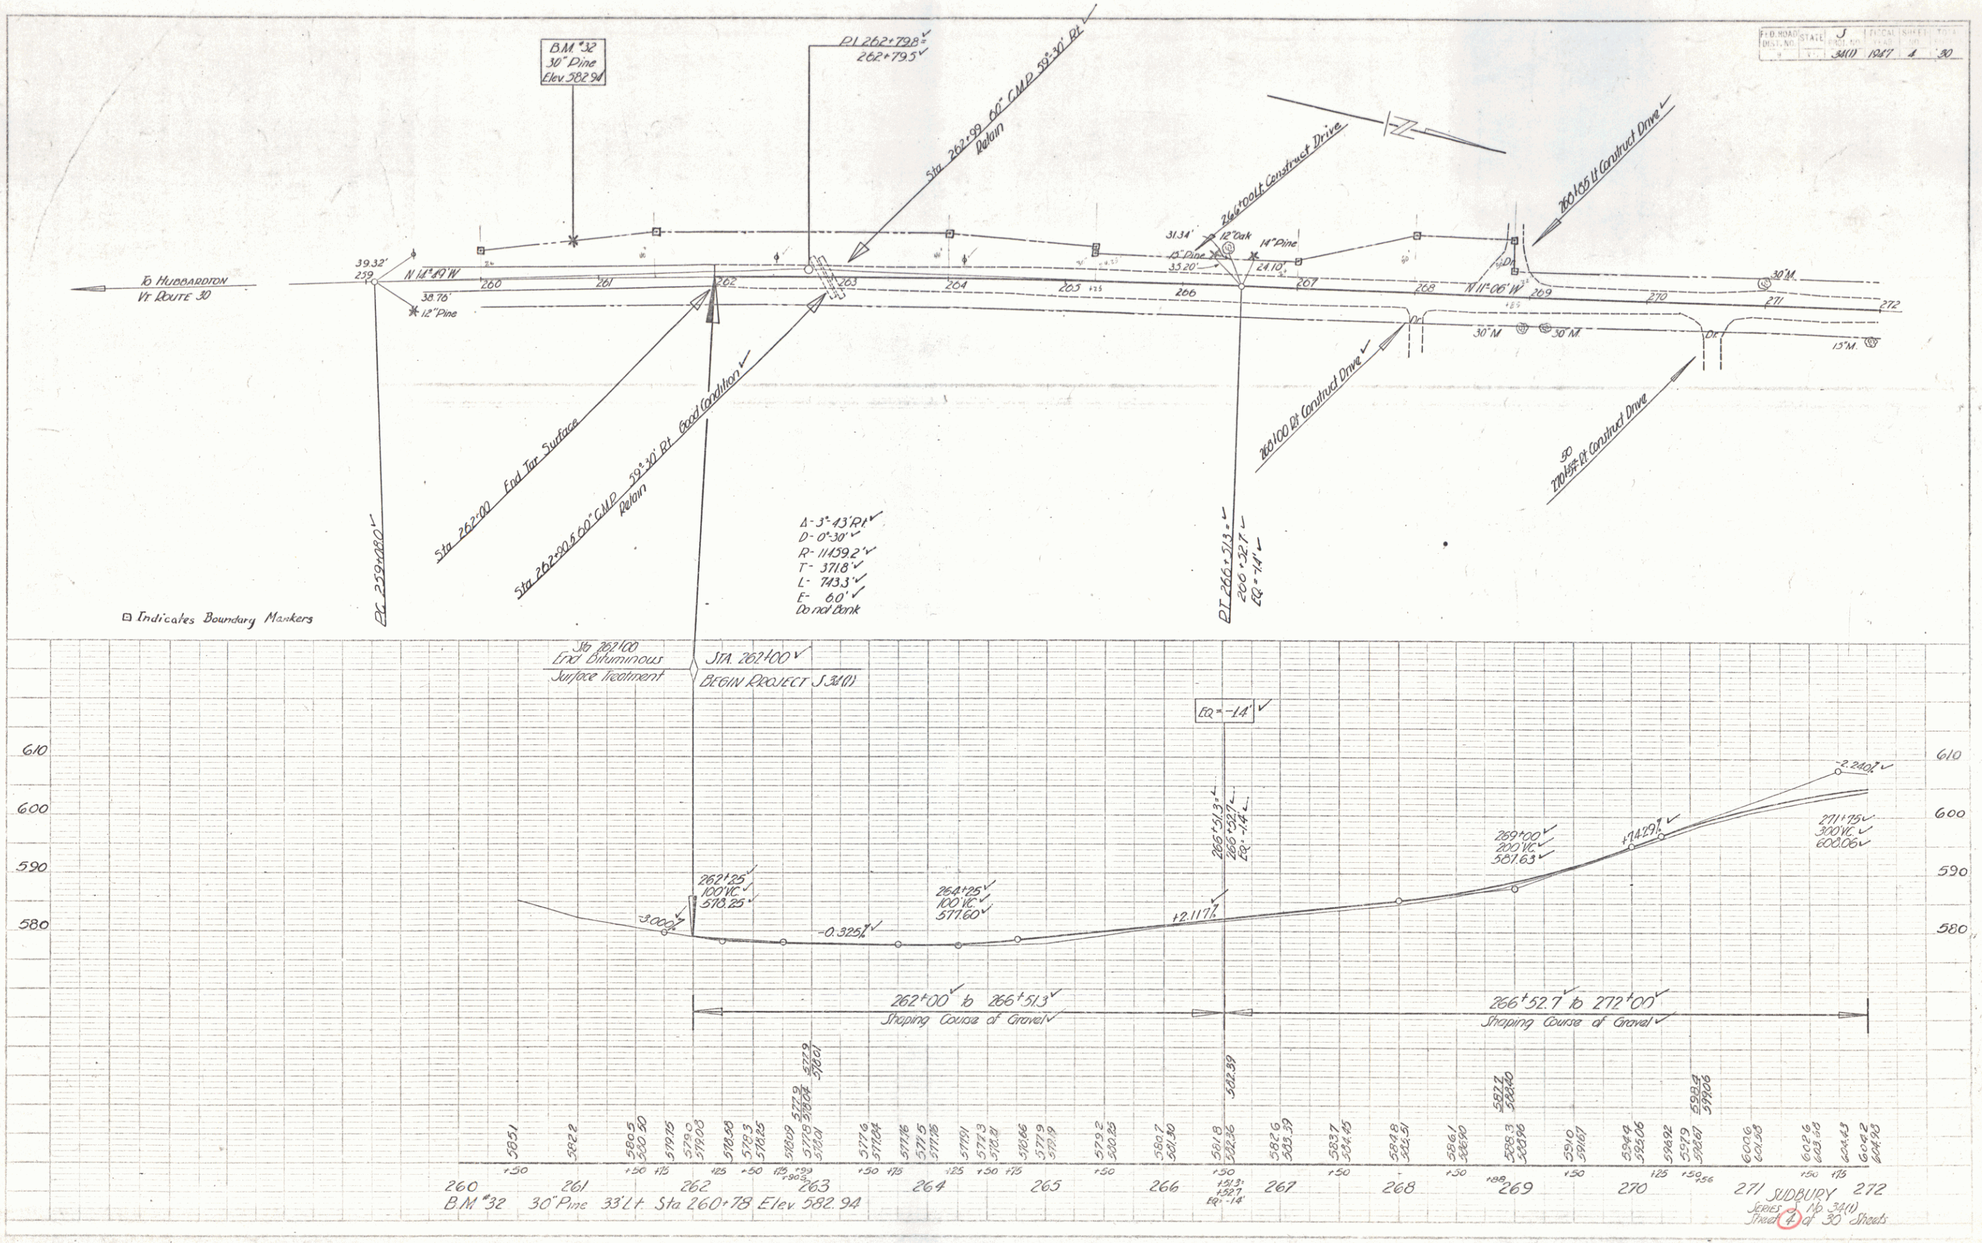


2