



PROJECT NO.	SHEET NO.	TOTAL SHEETS
3401	9	30

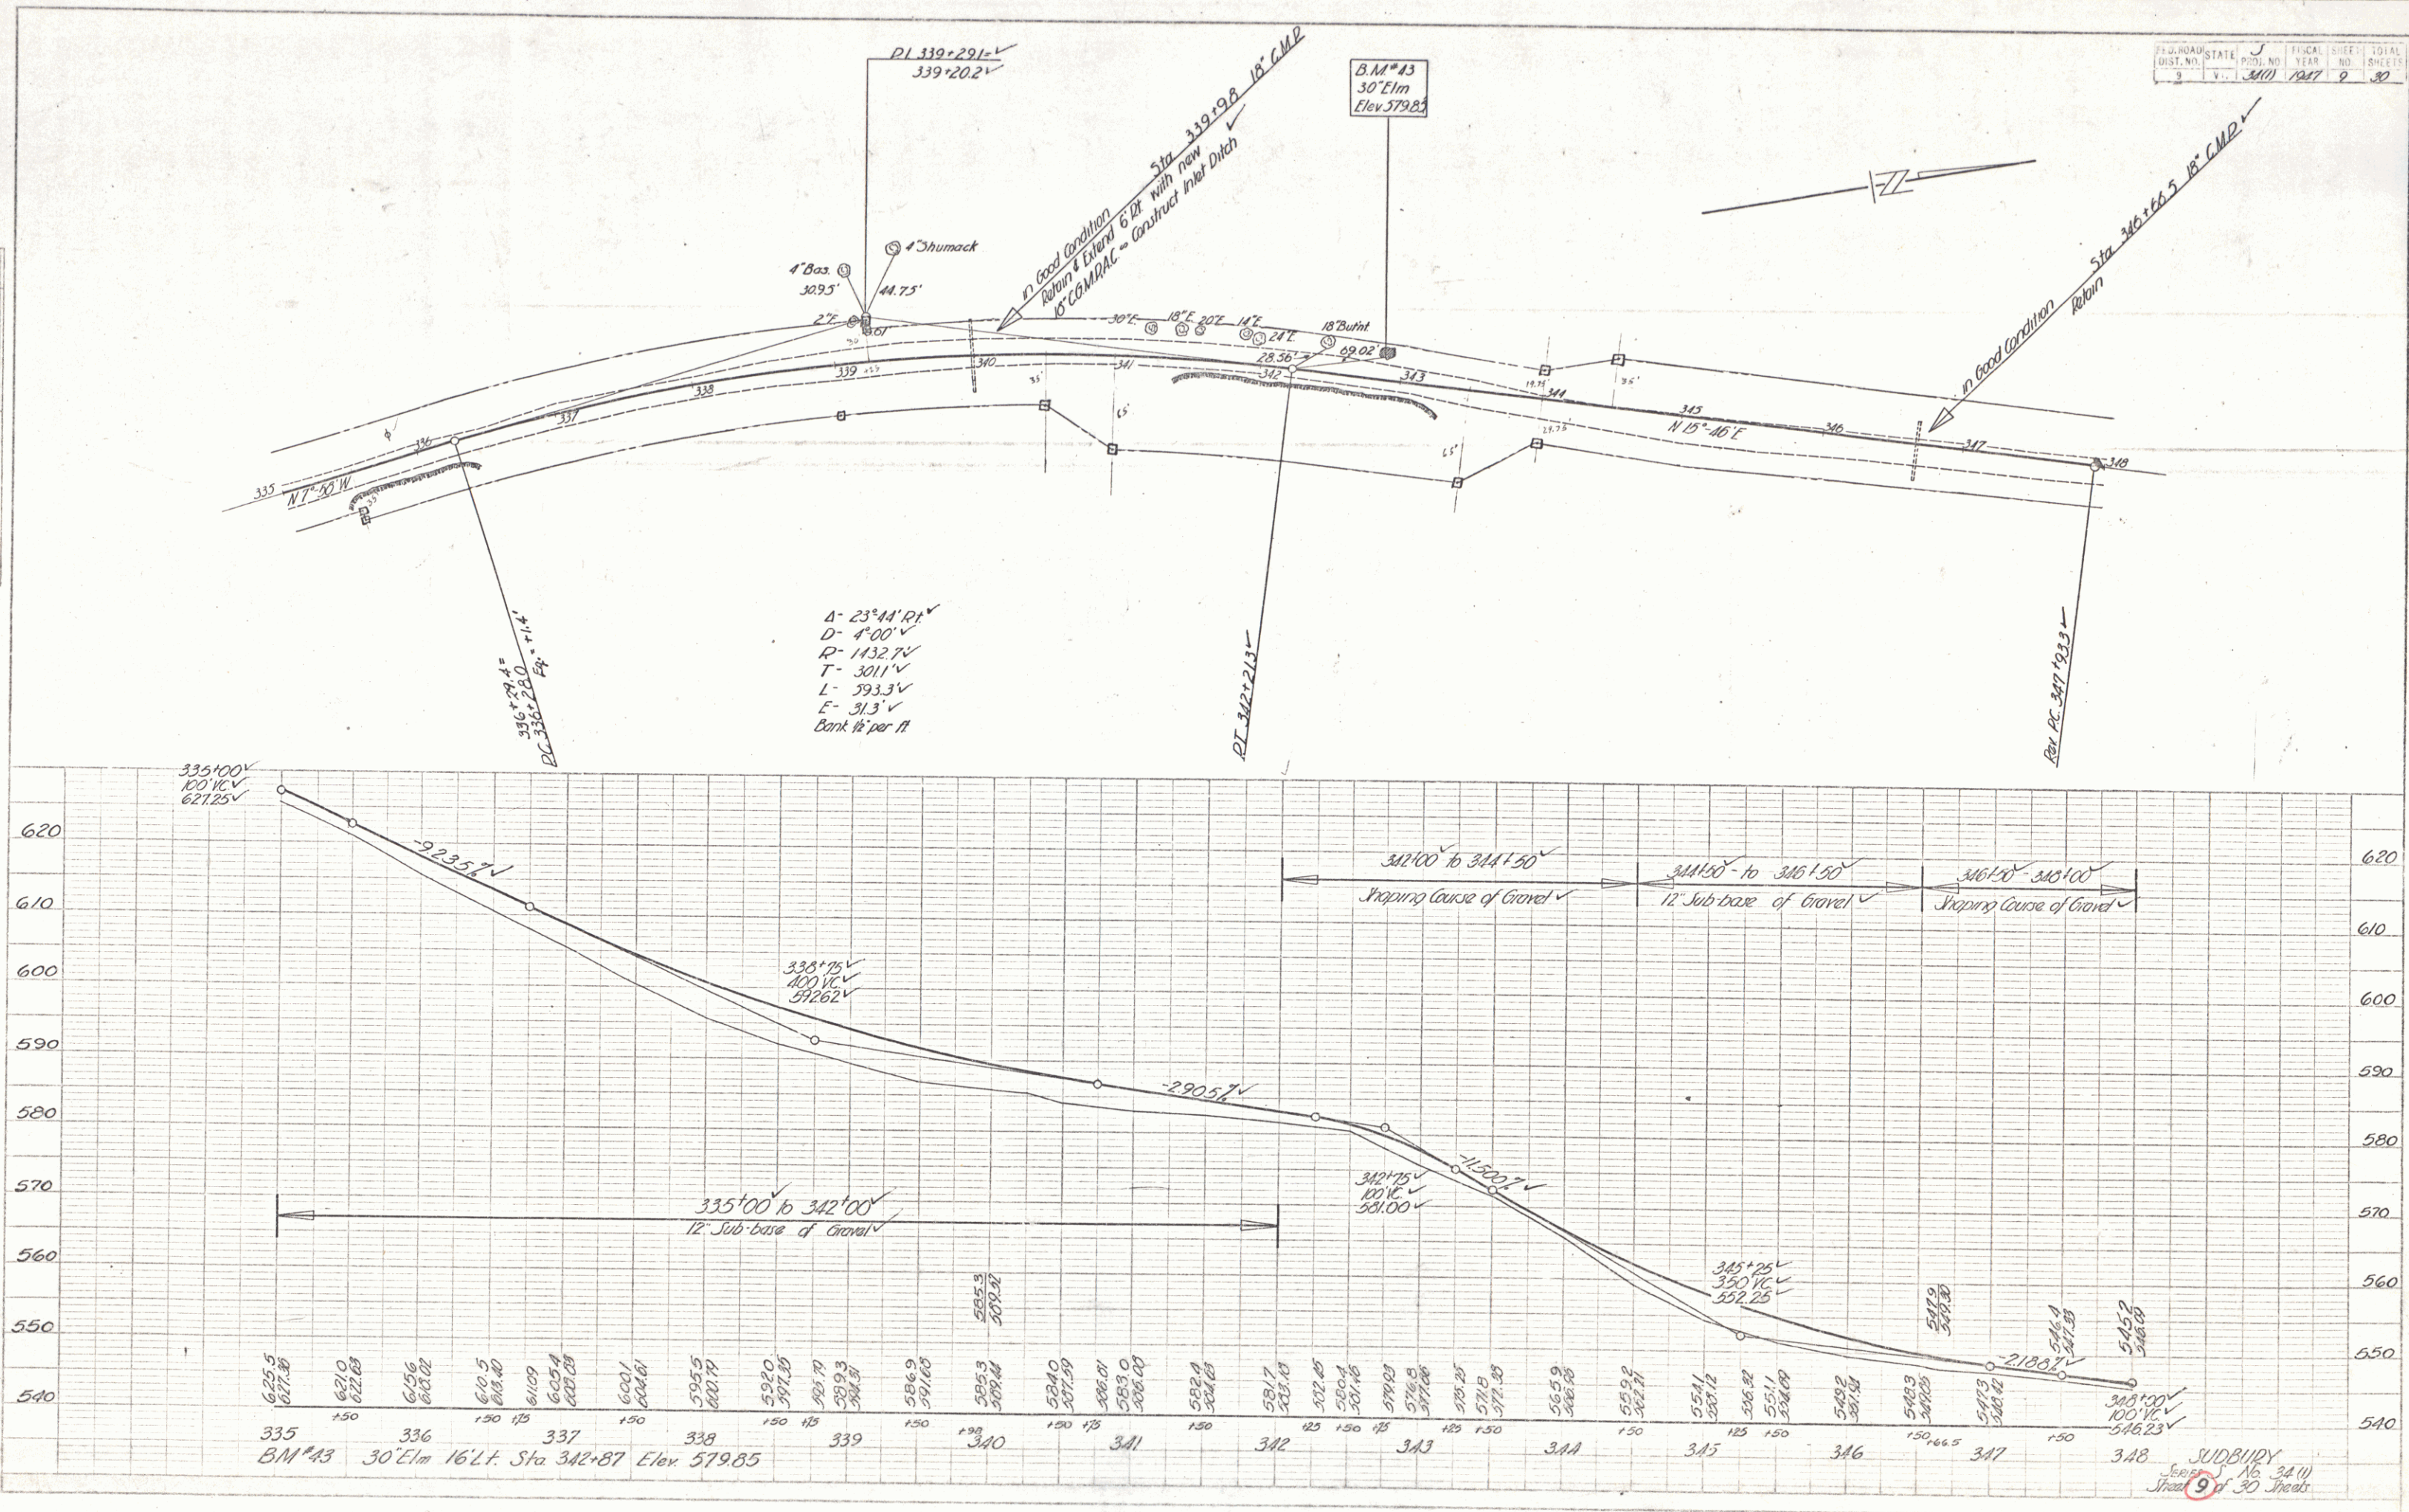



