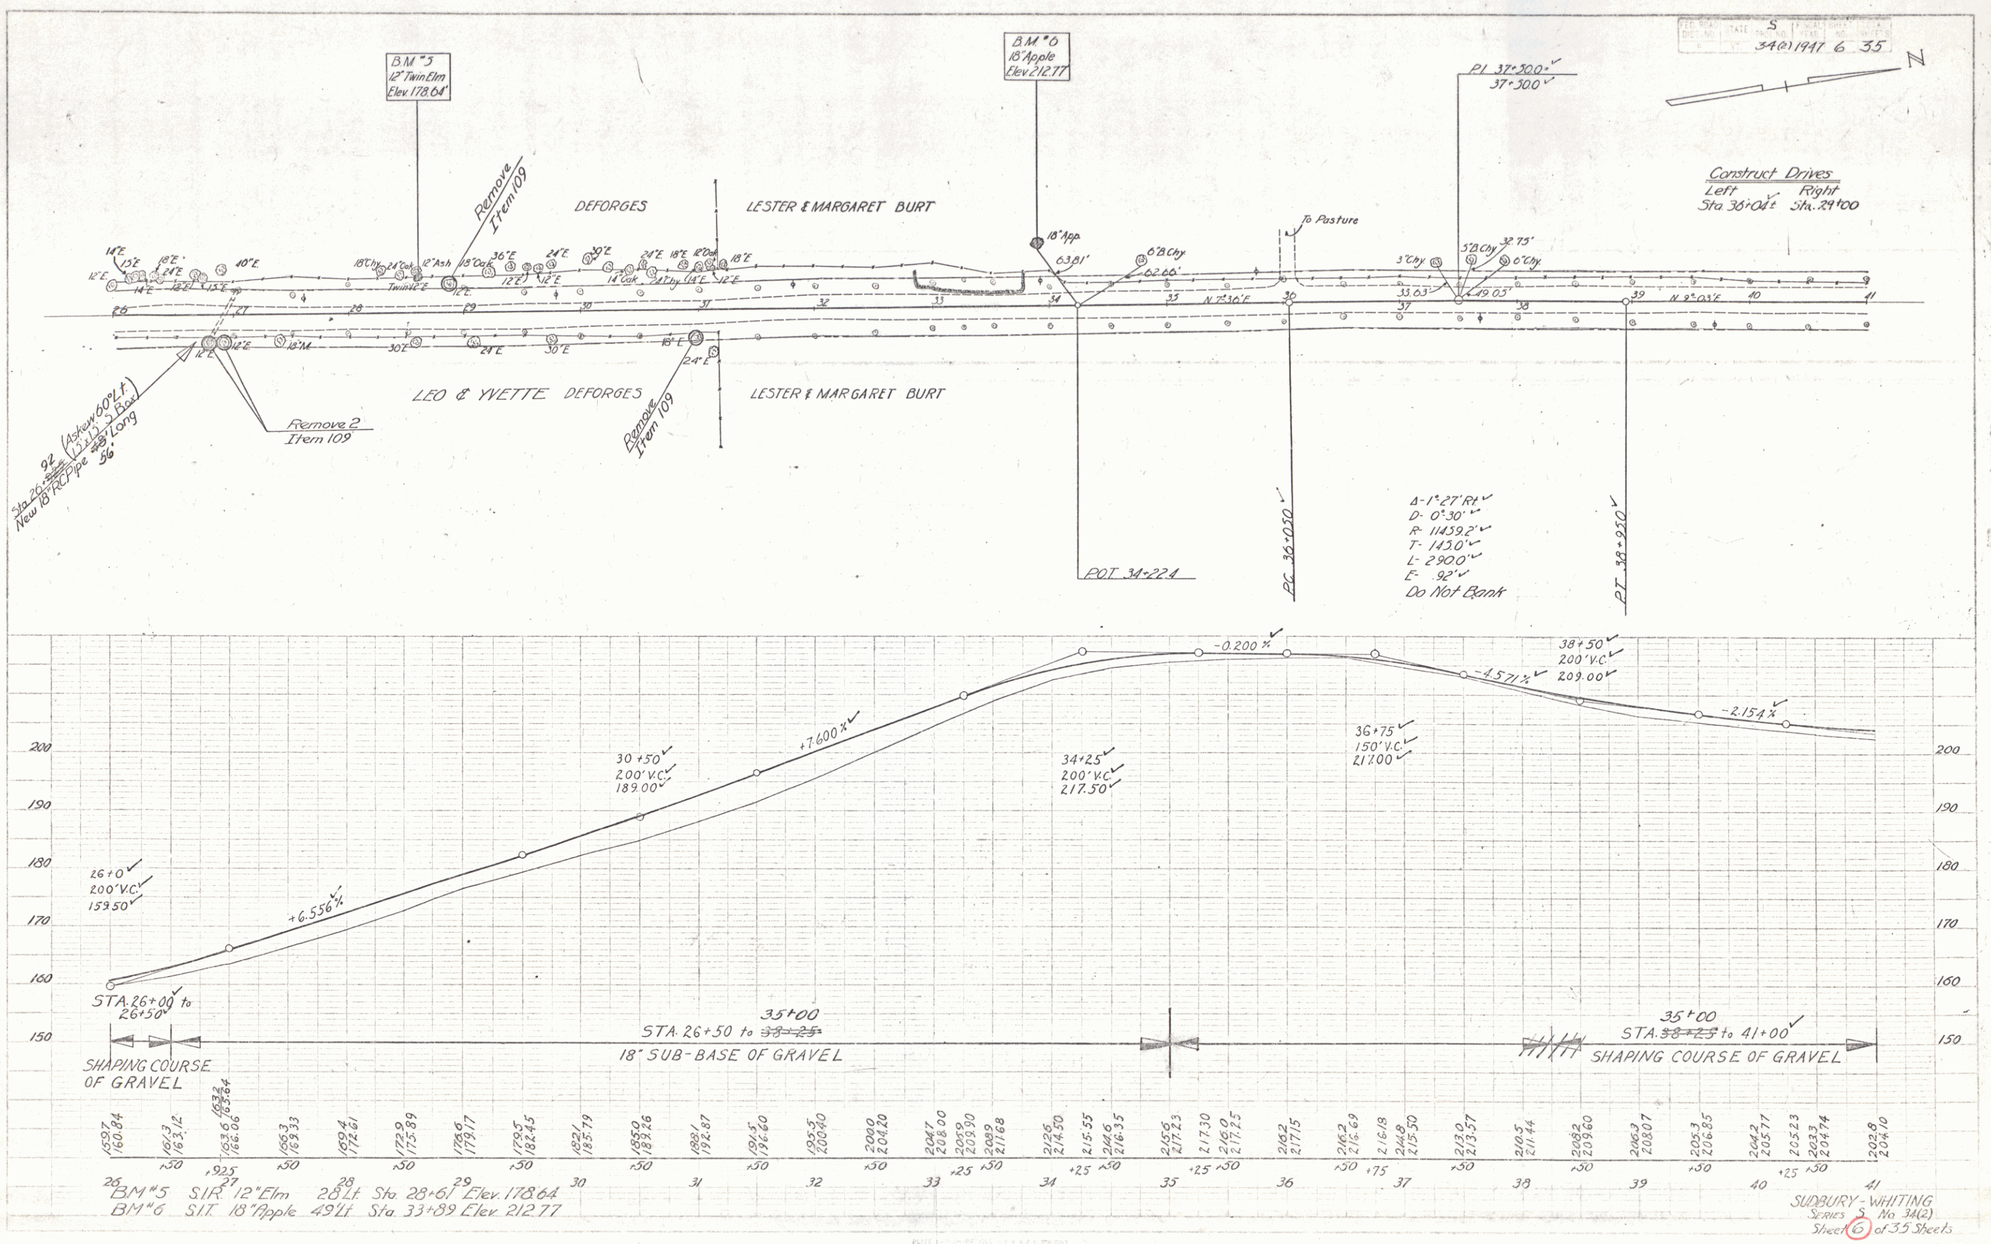
S
34(2) 1941 6 35
N
BM #5
12" Twin Elm
Elev. 178.64'
BM #6
18" Apple
Elev. 212.77'
Remove
Item 109
DEFORGES
LESTER & MARGARET BURT
LEO & YVETTE DEFORGES
LESTER & MARGARET BURT
To Pasture
PI 37+300
37+300
Construct Drives
Left Sta 36+04±
Right Sta. 29+00
Sta 26+92 (Approx 60' Lt)
New 18" RCP Pipe
Long
Remove 2
Item 109
POT 34+22.4
PC 36+03.0
PT 38+93.0
Δ- 1°27' Rt
D- 0°30'
R- 11459.2'
T- 143.0'
L- 290.0'
E- .92'
Do Not Bank
-0.200 %
38+50
200' V.C.
209.00
-4.571 %
-2.154 %
30+50
200' V.C.
189.00
+7.600 %
34+25
200' V.C.
217.50
36+75
150' V.C.
217.00
26+0
200' V.C.
159.50
+6.556 %
STA. 26+00 to 26+50
35+00
STA. 26+50 to
18" SUB-BASE OF GRAVEL
35+00
STA. to 41+00
SHAPING COURSE OF GRAVEL
SHAPING COURSE OF GRAVEL
BM #5 S.I.R. 12" Elm 28 Lt. Sta. 28+61 Elev. 178.64
BM #6 S.I.T. 18" Apple 49 Lt. Sta. 33+89 Elev. 212.77
SUDBURY - WHITING
Series S No. 34(2)
Sheet 6 of 35 Sheets
4