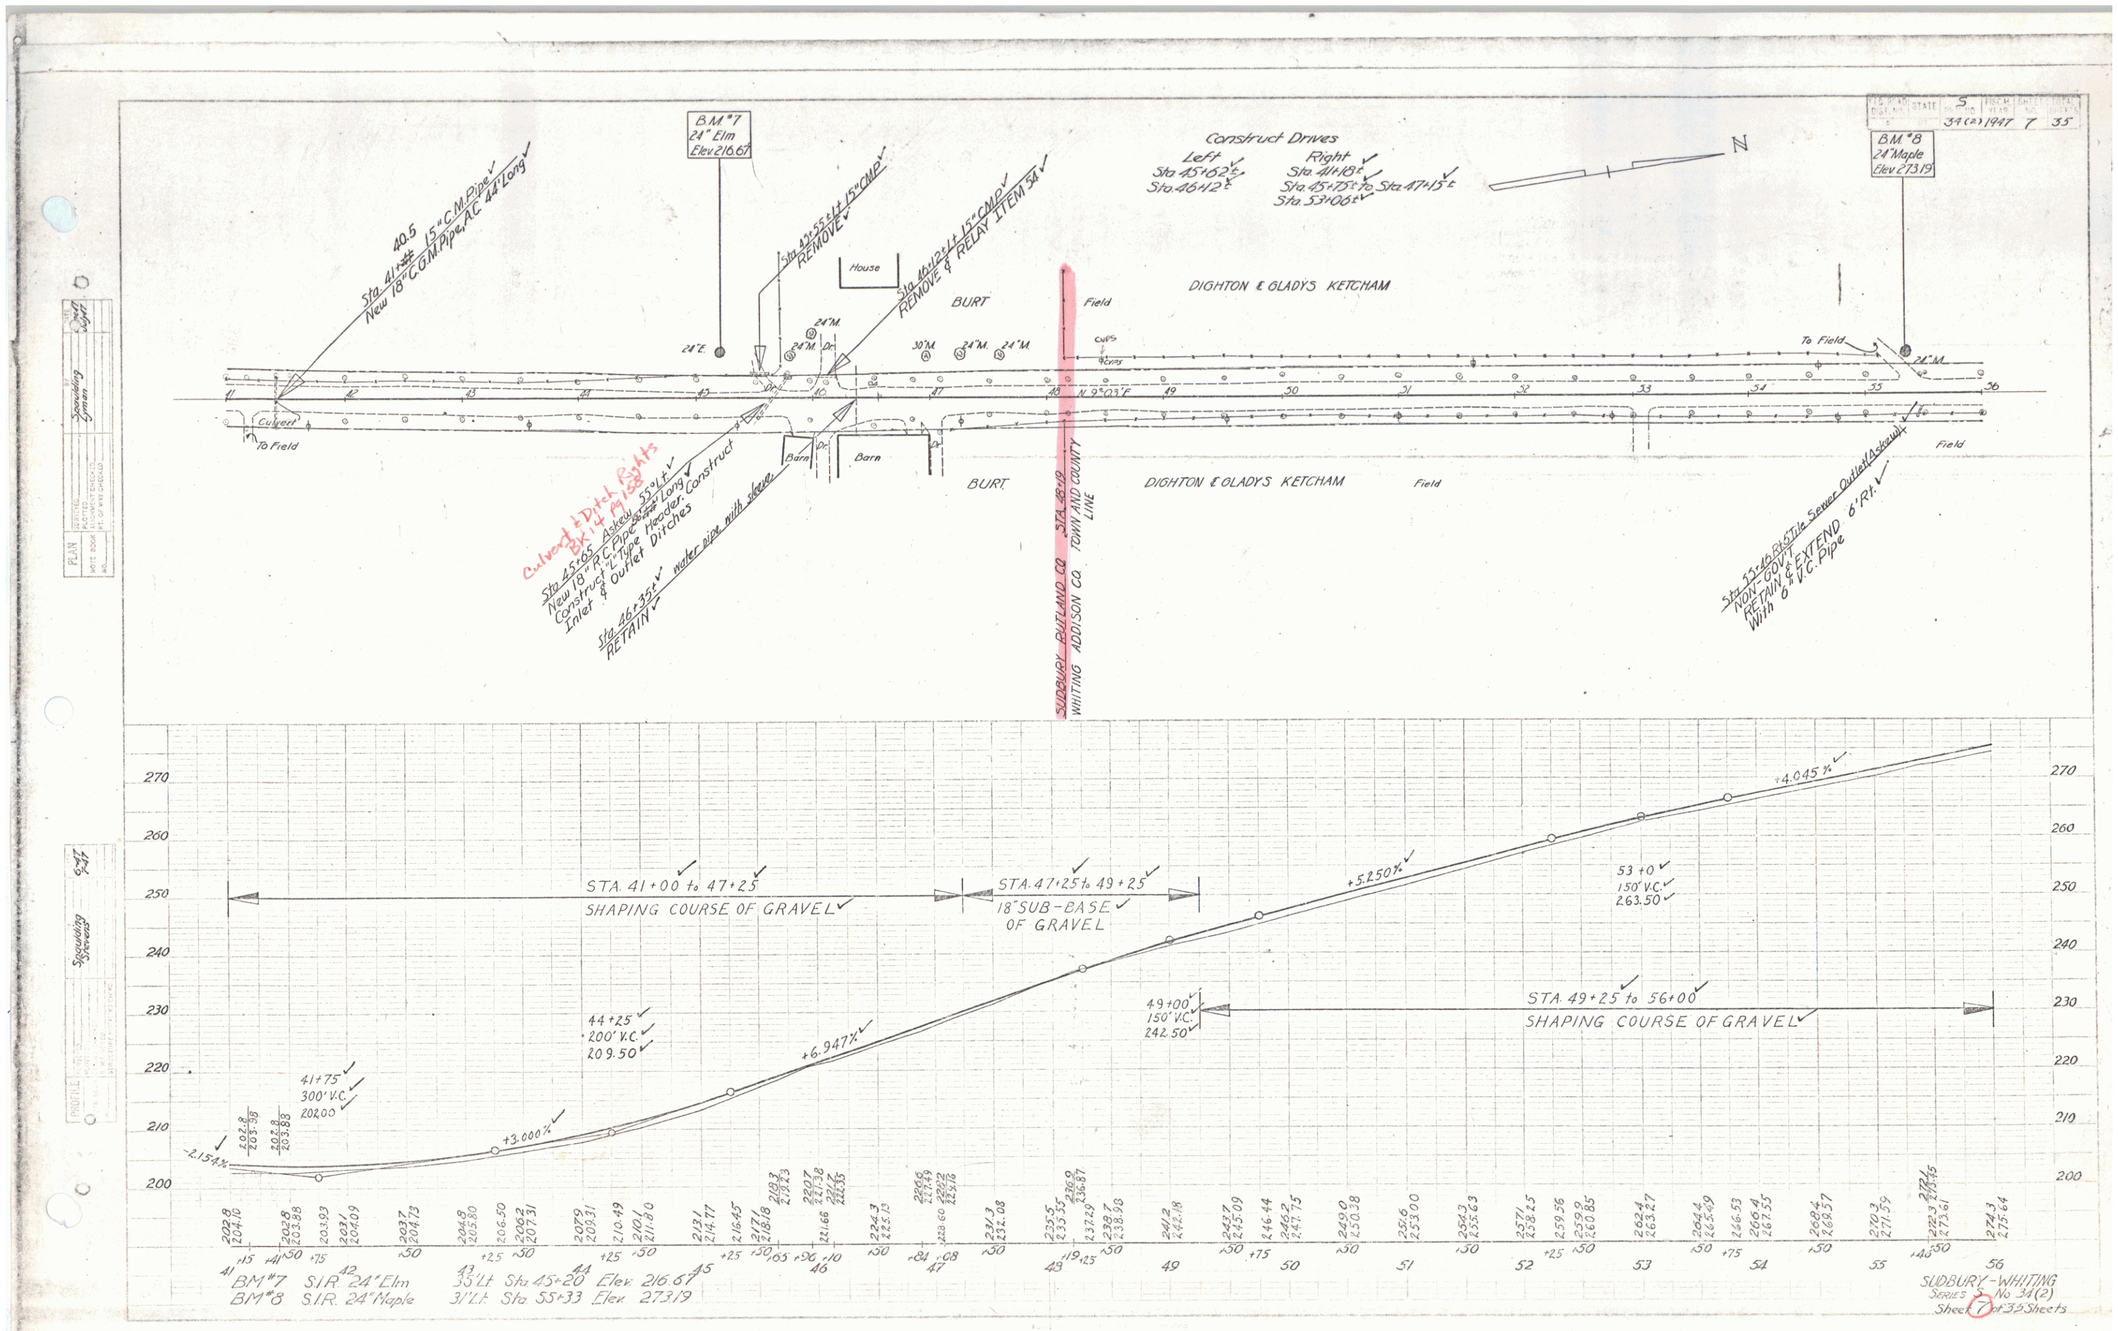
BM #7
24" Elm
Elev 216.67
BM #8
24" Maple
Elev 273.19
Construct Drives
Left
Sta 45+62
Sta 46+12
Right
Sta 41+18
Sta 45+75 to Sta 47+15
Sta 53+06
Sta 41+40.5 15" C.M. Pipe
New 18" C.G.M. Pipe, AC 44' Long
Sta 42+55±14 15" CMP
REMOVE
Sta 46+12±14 15" CMP
REMOVE & RELAY ITEM 54
House
BURT
Field
DIGHTON & GLADYS KETCHAM
Culvert
To Field
Barn
New 18" R.C. Pipe 55' Long
Construct 1-Pipe Header
Inlet & Outlet Ditches
RETAIN
NON-GOV'T
RETAIN & EXTEND 6' Rt.
With 6" V.C. Pipe
SUDBURY - BUTLAND CO
WHITING ADDISON CO
TOWN AND COUNTY LINE
N 9°03' E
STA. 48+19
STA. 41+00 to 47+25
SHAPING COURSE OF GRAVEL
STA. 47+25 to 49+25
18" SUB-BASE OF GRAVEL
STA. 49+25 to 56+00
SHAPING COURSE OF GRAVEL
-2.154%
+3.000%
+6.947%
+5.250%
+4.045%
41+75
300' V.C.
202.00
44+25
200' V.C.
209.50
49+00
150' V.C.
242.50
53+0
150' V.C.
263.50
BM #7 S.I.R. 24" Elm 35' Lt. Sta. 45+20 Elev. 216.67
BM #8 S.I.R. 24" Maple 3' Lt. Sta. 55+33 Elev. 273.19
SUDBURY - WHITING
SERIES 5 No 34(2)
Sheet 7 of 35 Sheets

5