FED. ROAD DIST. NO.	STATE	PROJ. NO.	FISCAL YEAR	SHEET NO.	TOTAL SHEETS
5	VT.	S 34(2)	1947	11	35

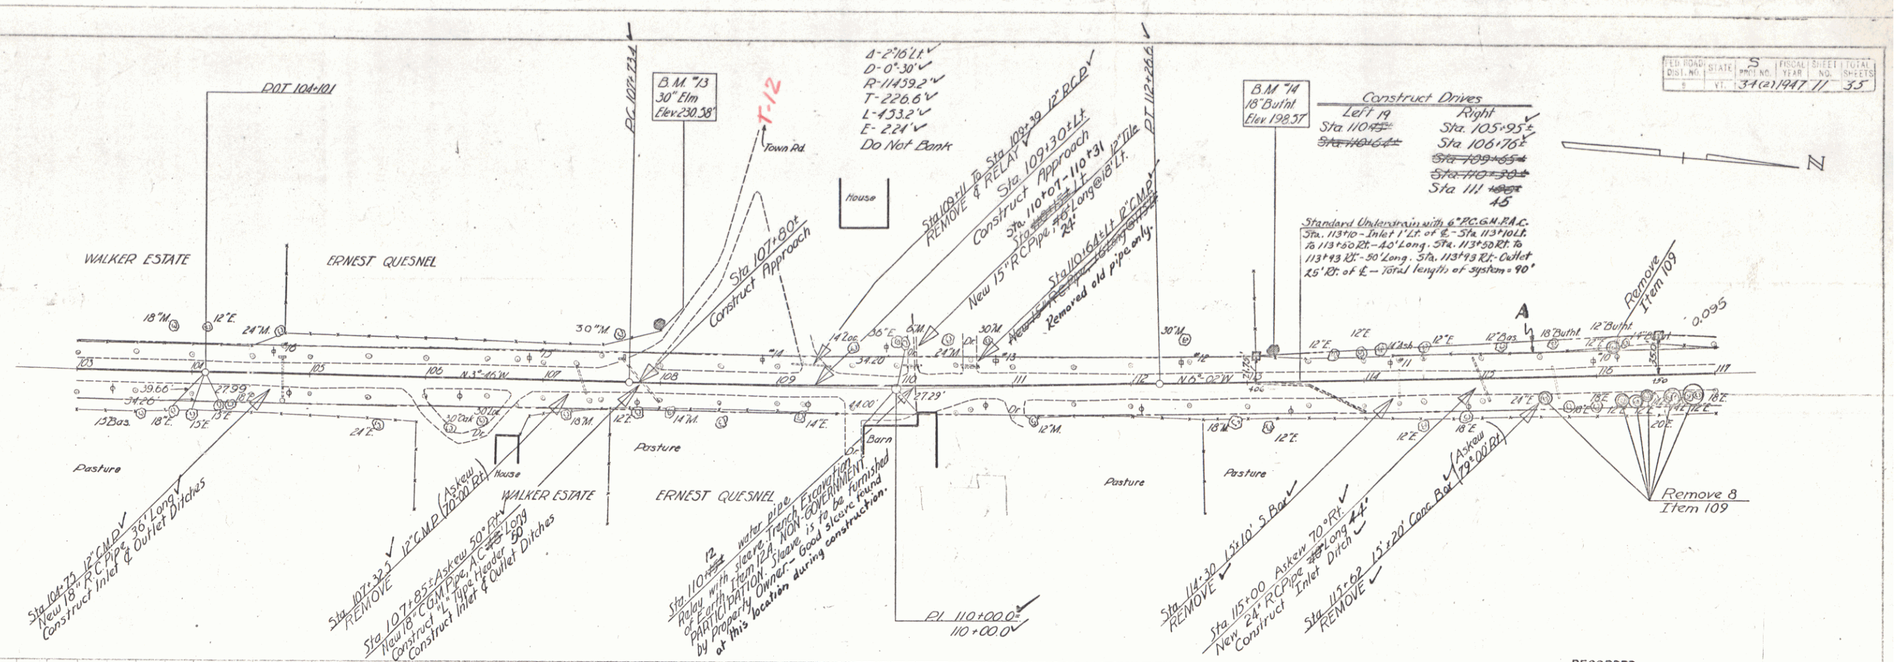

PARCEL	INSTRUMENT	DATE	GRANTOR	GRANTEE	RECORDED WHITING BOOK	PAGE	DATE	REMARKS
A	W.D.O.E.	10-14-47	ERNEST & SIMONE QUESNEL	ST. OF VT.	11	105-106	10-24-47	

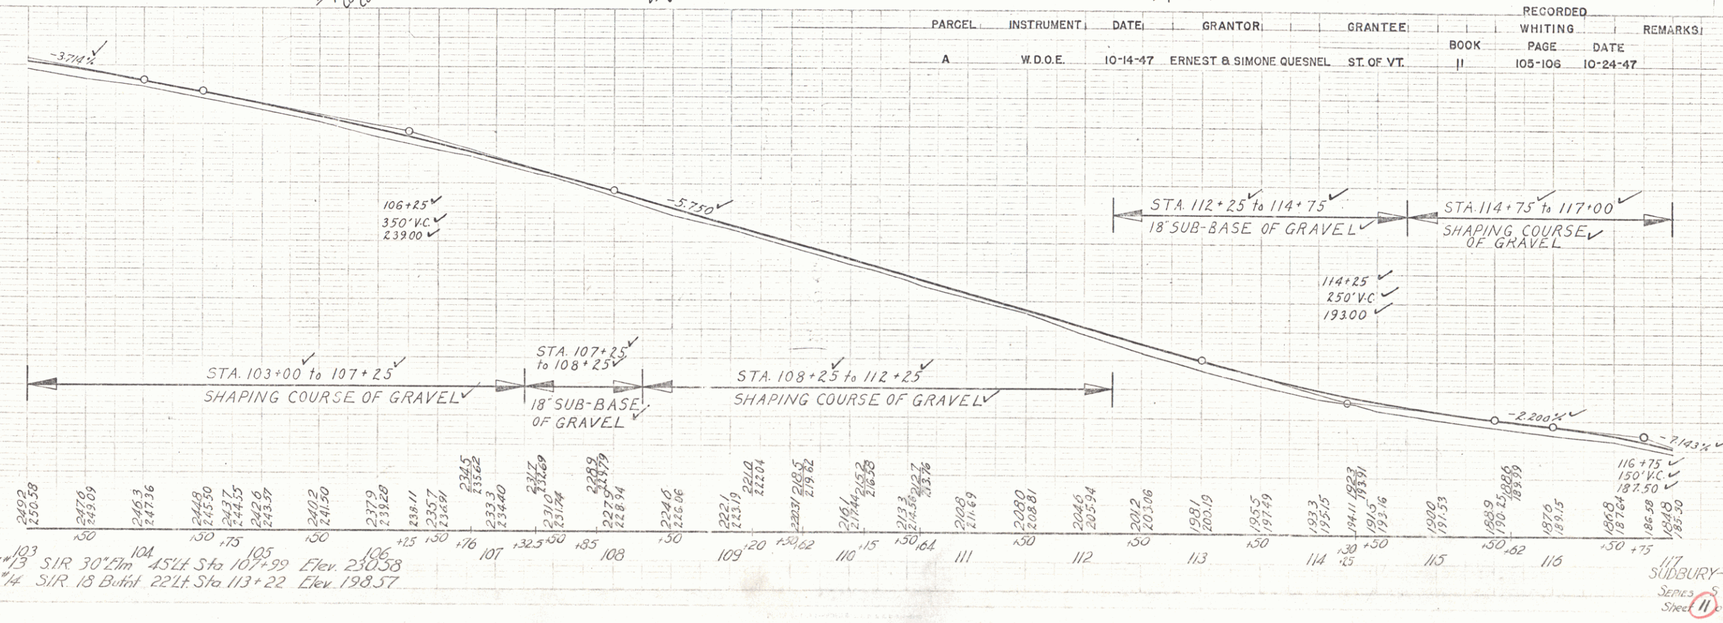

BM #13 S.I.R. 30" Elm 45' Lt. Sta. 107+99 Elev. 230.58
BM #14 S.I.R. 18 Butnt. 22' Lt. Sta. 113+22 Elev. 198.57

SUDBURY-WHITING
Series S No. 34(2)
Sheet 11 of 35 Sheets

9