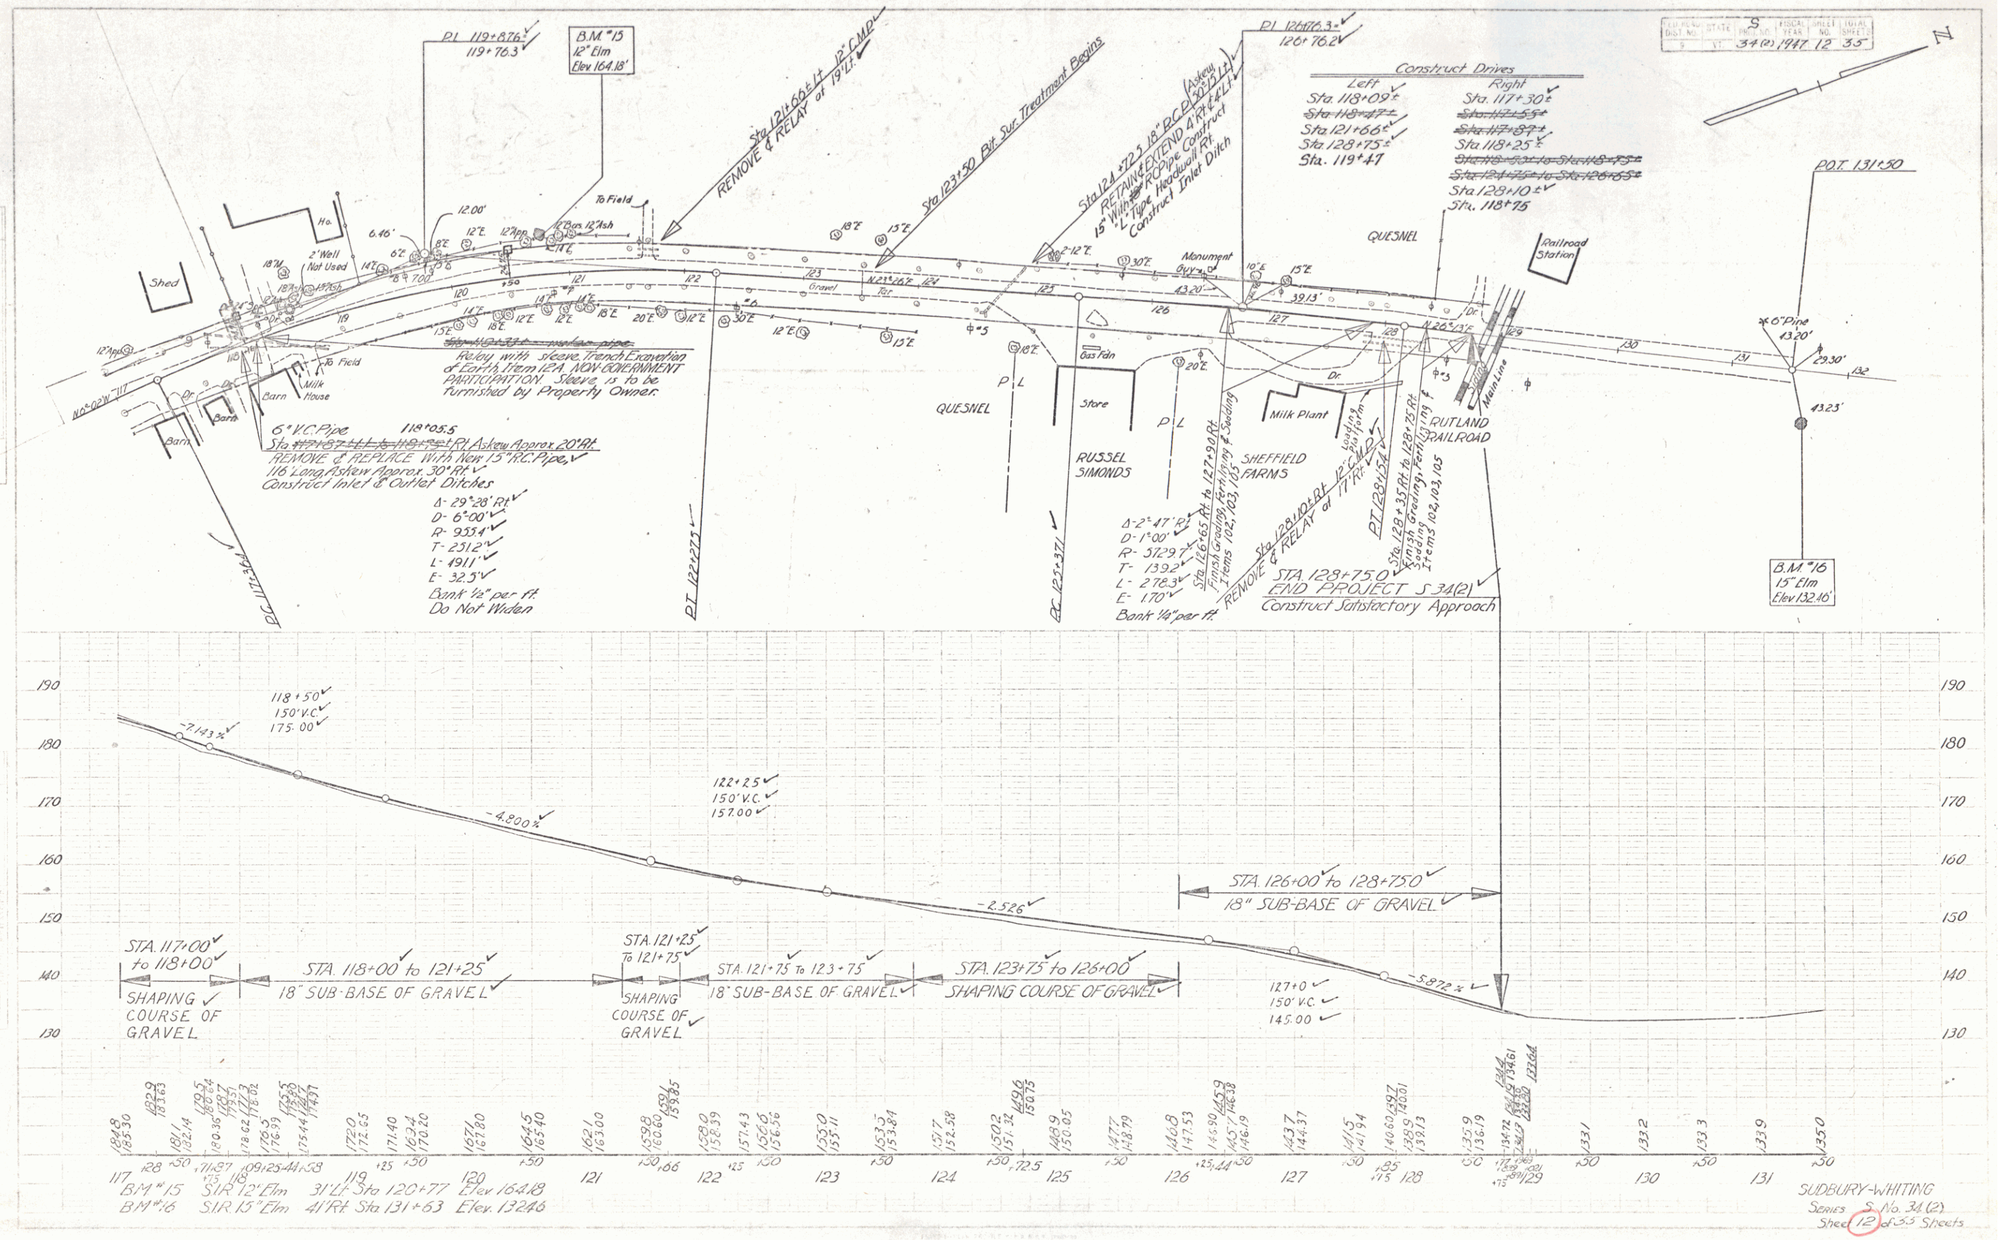
PI 119+87.6
119+76.3
B.M. #15
12" Elm
Elev 164.18'
Sta. 121+60 ± Lt. 12" C.M.P.
REMOVE & RELAY of 1927.
Sta. 123+50 Rt. Sur. Treatment Begins
Sta. 124+22.5 18" R.C.P. (Askew 50°) Lt.
RETAINING EXTEND 4.0' ± Lt.
15" With R.C.P. Pipe Construct
"L" Type Headwall Rt.
Construct Inlet Ditch
PI 128+76.3
126+76.2
Construct Drives
Left
Sta. 118+09
Sta. 121+66
Sta. 128+75
Sta. 119+47
Right
Sta. 117+30
Sta. 118+25
Sta. 129+10
Sta. 118+75
P.O.T. 131+50
To Field
Shed
Ho.
2" Well Not Used
6.46'
12.00'
12" App.
12" Ash
Gravel
Tar
Monument
43.20'
39.13'
QUESNEL
Railroad Station
Dr.
Milk House
Barn
Gas Tank
Store
Milk Plant
Main Line
RUTLAND RAILROAD
RUSSEL SIMONDS
SHEFFIELD FARMS
6" V.C. Pipe
Sta. 119+05.5
Rt. Askew Approx. 20° Rt.
REMOVE & REPLACE With New 15" R.C. Pipe
116' Long, Askew Approx. 30° Rt.
Construct Inlet & Outlet Ditches
Δ- 29°28' Rt.
D- 6°00'
R- 953.4'
T- 251.2'
L- 491.1'
E- 32.5'
Bank ½" per ft.
Do Not Widen
Relay with Sleeve Trench Excavation of Earth Item 124. NON-GOVERNMENT PARTICIPATION. Sleeve is to be furnished by Property Owner.
PC 117+34.4
PT 122+27.5
PC 125+37.1
Sta. 126+65 Rt. to 127+90 Rt.
Finish Grading, Fertilizing & Seeding
Items 102, 103, 105
Sta. 128+10 Rt. 12" C.M.P.
REMOVE & RELAY of 1927.
PT 128+75.4
Sta. 128+35 Rt. to 128+75 Rt.
Finish Grading, Fertilizing & Seeding
Items 102, 103, 105
STA. 128+75.0
END PROJECT S 34(2)
Construct Satisfactory Approach
6" Pipe
13.20'
29.30'
43.23'
B.M. #16
15" Elm
Elev 132.46'
6" V.C. Pipe
Δ- 2°47'
D- 1°00'
R- 572.9'
T- 139.2'
L- 278.3'
E- 1.70'
Bank ¼" per ft.
118+50
150' V.C.
175.00
-7.143%
122+25
150' V.C.
157.00
-4.800%
-2.526
STA. 126+00 to 128+75
18" SUB-BASE OF GRAVEL
STA. 117+00 to 118+00
SHAPING COURSE OF GRAVEL
STA. 118+00 to 121+25
18" SUB-BASE OF GRAVEL
STA. 121+25 To 121+75
SHAPING COURSE OF GRAVEL
STA. 121+75 To 123+75
18" SUB-BASE OF GRAVEL
STA. 123+75 to 126+00
SHAPING COURSE OF GRAVEL
127+0
150' V.C.
145.00
-5.872%
190
180
170
160
150
140
130
117
118
119
120
121
122
123
124
125
126
127
128
129
130
131
BM #15 SIR 12" Elm 31' Lt. Sta. 120+77 Elev. 164.18
BM #16 SIR 15" Elm 41' Rt. Sta. 131+63 Elev. 132.46
SUDBURY-WHITING
Series S. No. 34 (2)
Sheet 12 of 33 Sheets

10