STATE OF VERMONT
DEPARTMENT OF HIGHWAYS

PROPOSED IMPROVEMENT

FEDERAL AID PROJECT

TOWNS OF BERLIN-BARRE
COUNTY OF WASHINGTON
ACCESS ROAD-INTERSTATE 89 TO SOUTH BARRE

BEGINNING AT A POINT 0.093 MILES WESTERLY OF THE JUNCTION OF VERMONT ROUTE 14 AND EXTENDING WESTERLY 3.695 MILES.

LENGTH OF ROADWAY	19,143.00 FEET = 3.625 MILES
LENGTH OF BRIDGE	157.00 FEET = 0.030 MILES
LENGTH OF PROJECT	19,300.00 FEET = 3.655 MILES

ADT	1965	1560-1820
ADT	1987	3720-3800
DHV	1987	560-570
D		55%
T		12%
V		50MPH

ROW PLANS

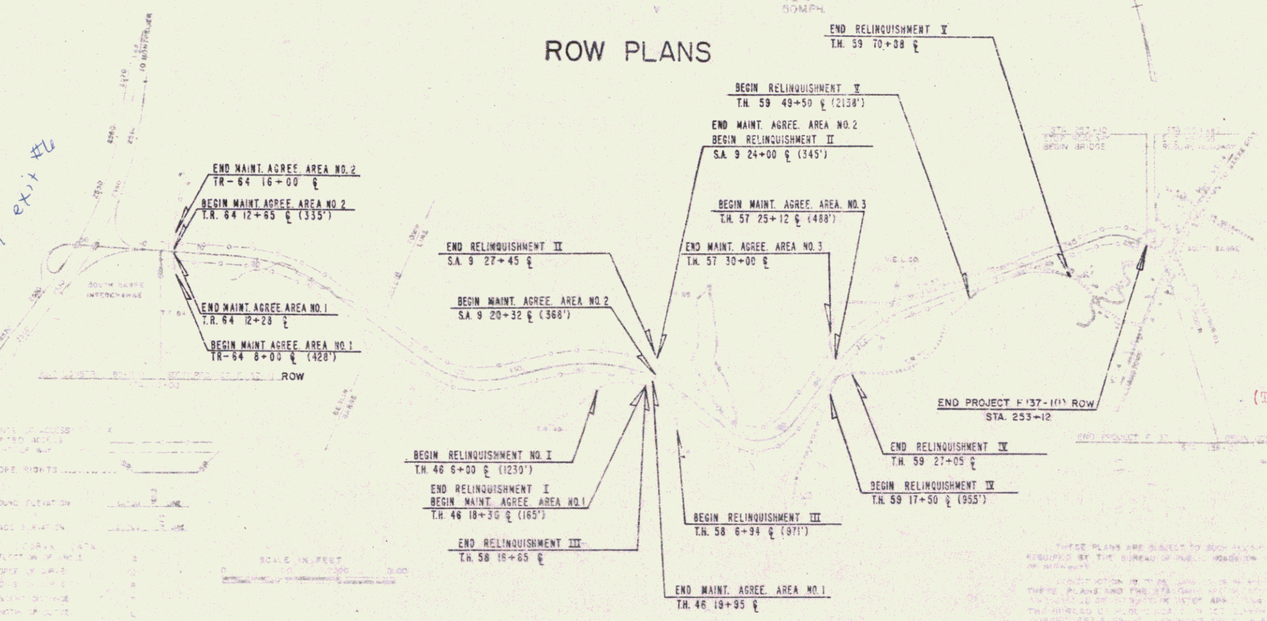

APPROVED: H P Radigan
RJW DIRECTOR
DATE Sept 8-1966

RIGHT-OF-WAY DIVISION
TOWN FILE
PERPETUAL
Town of Vt 63 I89
(To Be Returned To R.O.W. Division)

F 137-1(1)
SHEET 18 56

3