



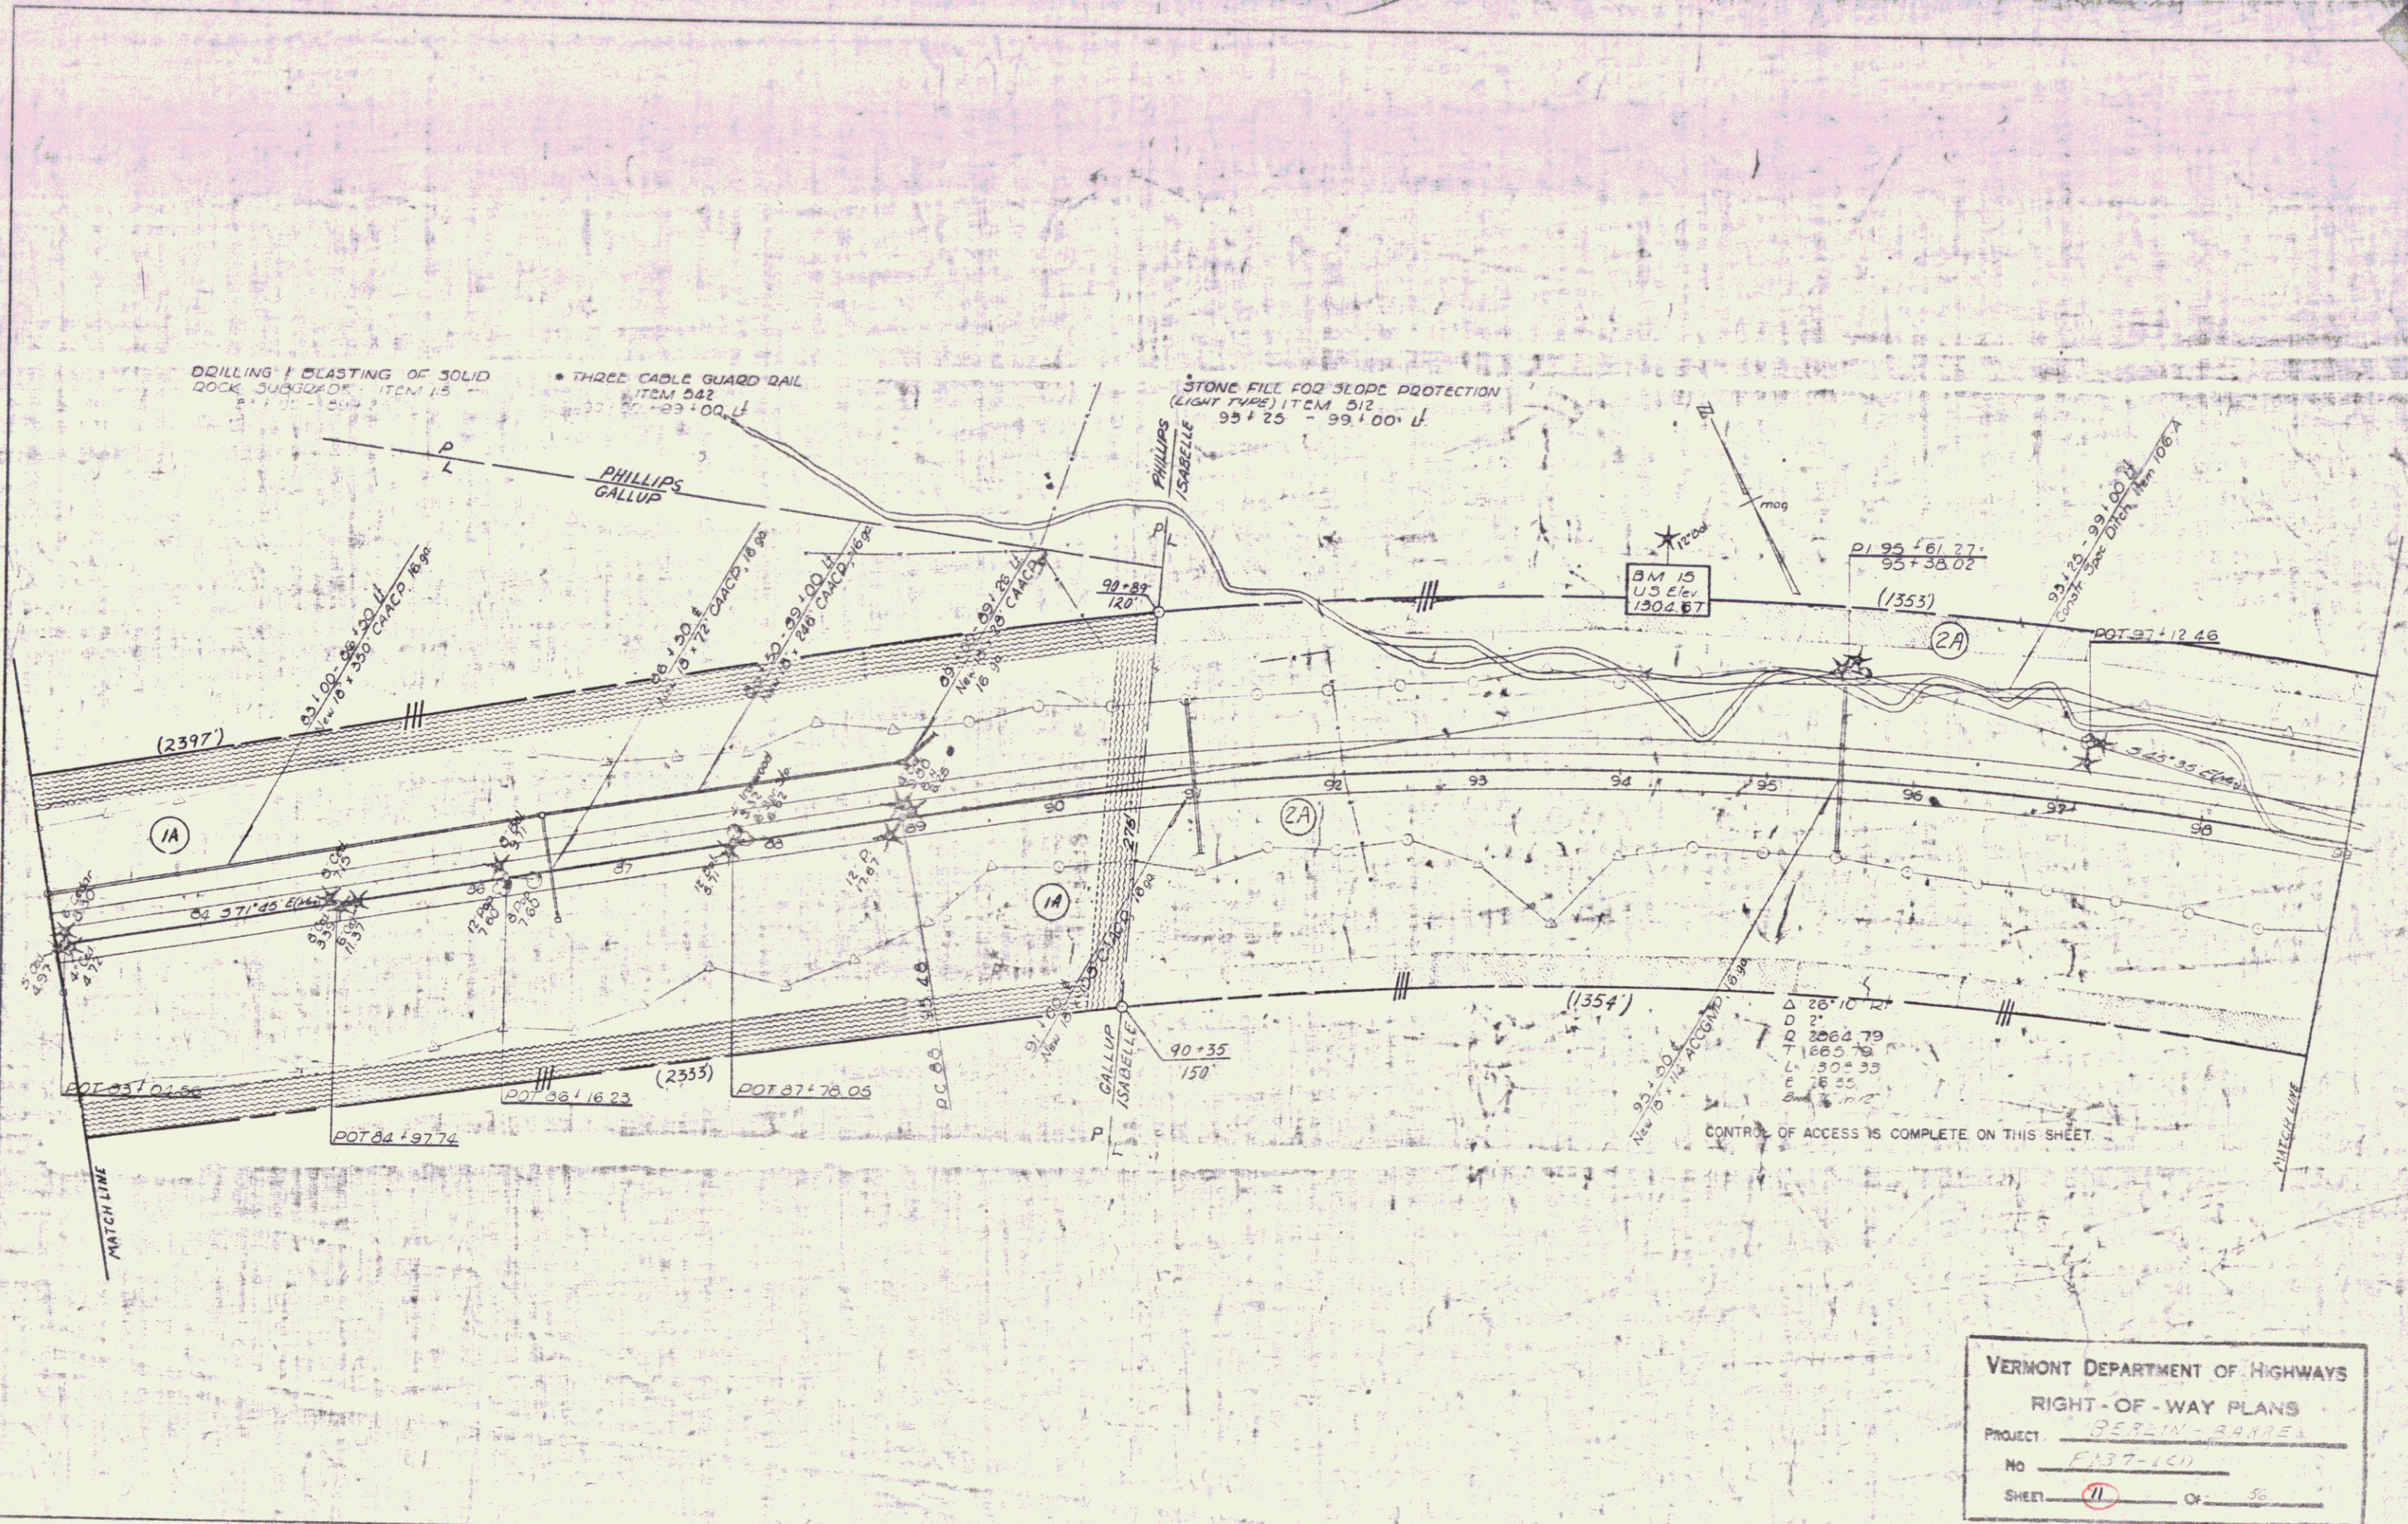

VERMONT DEPARTMENT OF HIGHWAYS
 RIGHT-OF-WAY PLANS
 PROJECT BERLIN-BARRE
 No F137-1C11
 SHEET 11 Of 55