


ROCK SUBGRADE, ITEM 115  
164+00 - 167+50  
176+00 - 177+00

\*THREE CABLE GUARD RAIL  
ITEM 542  
167+50 - 171+98.4  
171+00 - 172+60.4

PROPERTY LINE FENCE, ITEM 553-II, MOD  

ITEM 555  
189+50 - 171+95.4

\* DENOTES STAGE 2 ITEMS

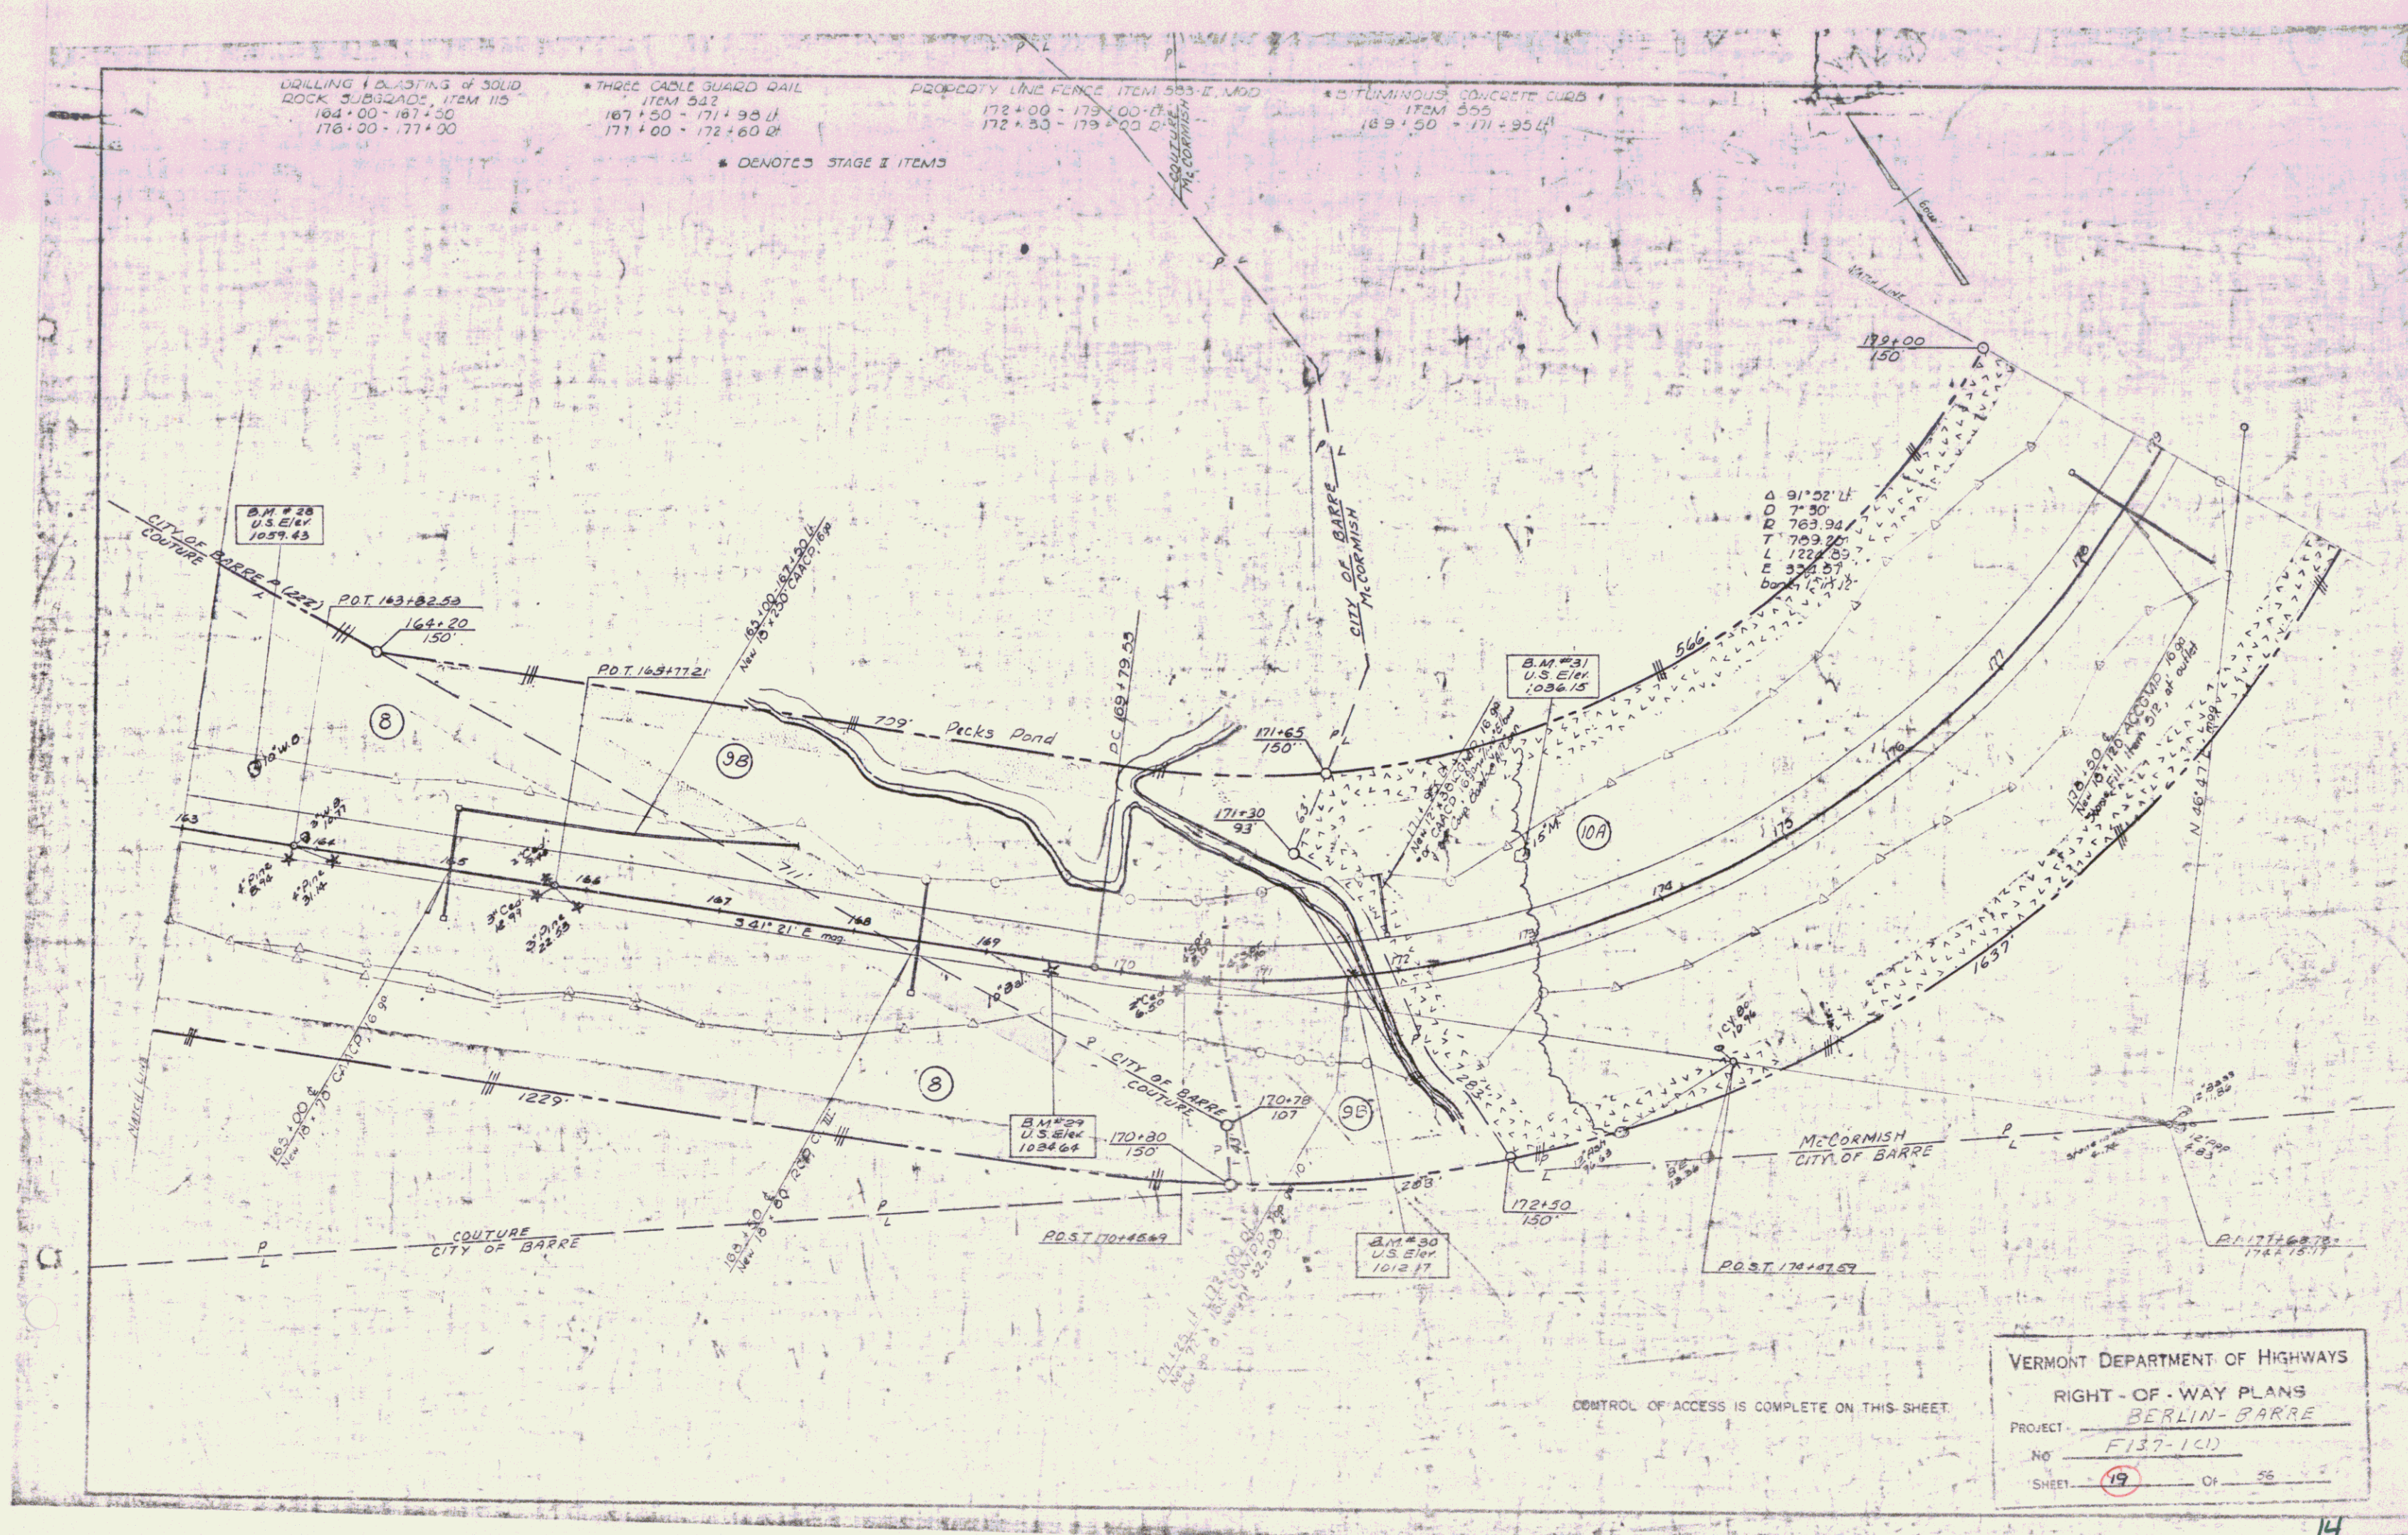

VERMONT DEPARTMENT OF HIGHWAYS  
RIGHT-OF-WAY PLANS  
PROJECT: BERLIN-BARRE  
NO: F137-1(C)  
SHEET: 19 OF 56

CONTROL OF ACCESS IS COMPLETE ON THIS SHEET

14