

* 100B
 201+07.11 - 250+00.21
 251+07.14 - 250+00.21

PROPERTY LINE FENCE
 * 1215E1 POSTS, M.D. ITEM 543B
 243+00 - 250+00 CH
 244+00 - 253+00 EH


* 304E EASING
 243+00 - 252+00 (Island)
 251+07 - 250+00 (Island)

STONE FILL FOR 5'-0" DE
 PROTECTION (LIGHT TYPE)
 ITEM 512
 243+00 - 243+75 EH

* 1402E CABLE GUARD RAIL
 * 1715E1 POSTS, ITEM 512
 243+00 - 244+32 EH
 250+02 - 253+00 EH
 251+30 - 255+10 EH
 254+67 - 255+39 EH
 254+67 - 250+00 EH

* STANDARD STEEL BEAM GUARD
 * 1215E1 POSTS, ITEM 540A
 243+00 - 244+37 EH

* BITUMINOUS CONCRETE CURB,
 ITEM 355
 243+00 - 244+00 EH
 252+00 - 253+00 EH
 252+50 - 253+00 EH

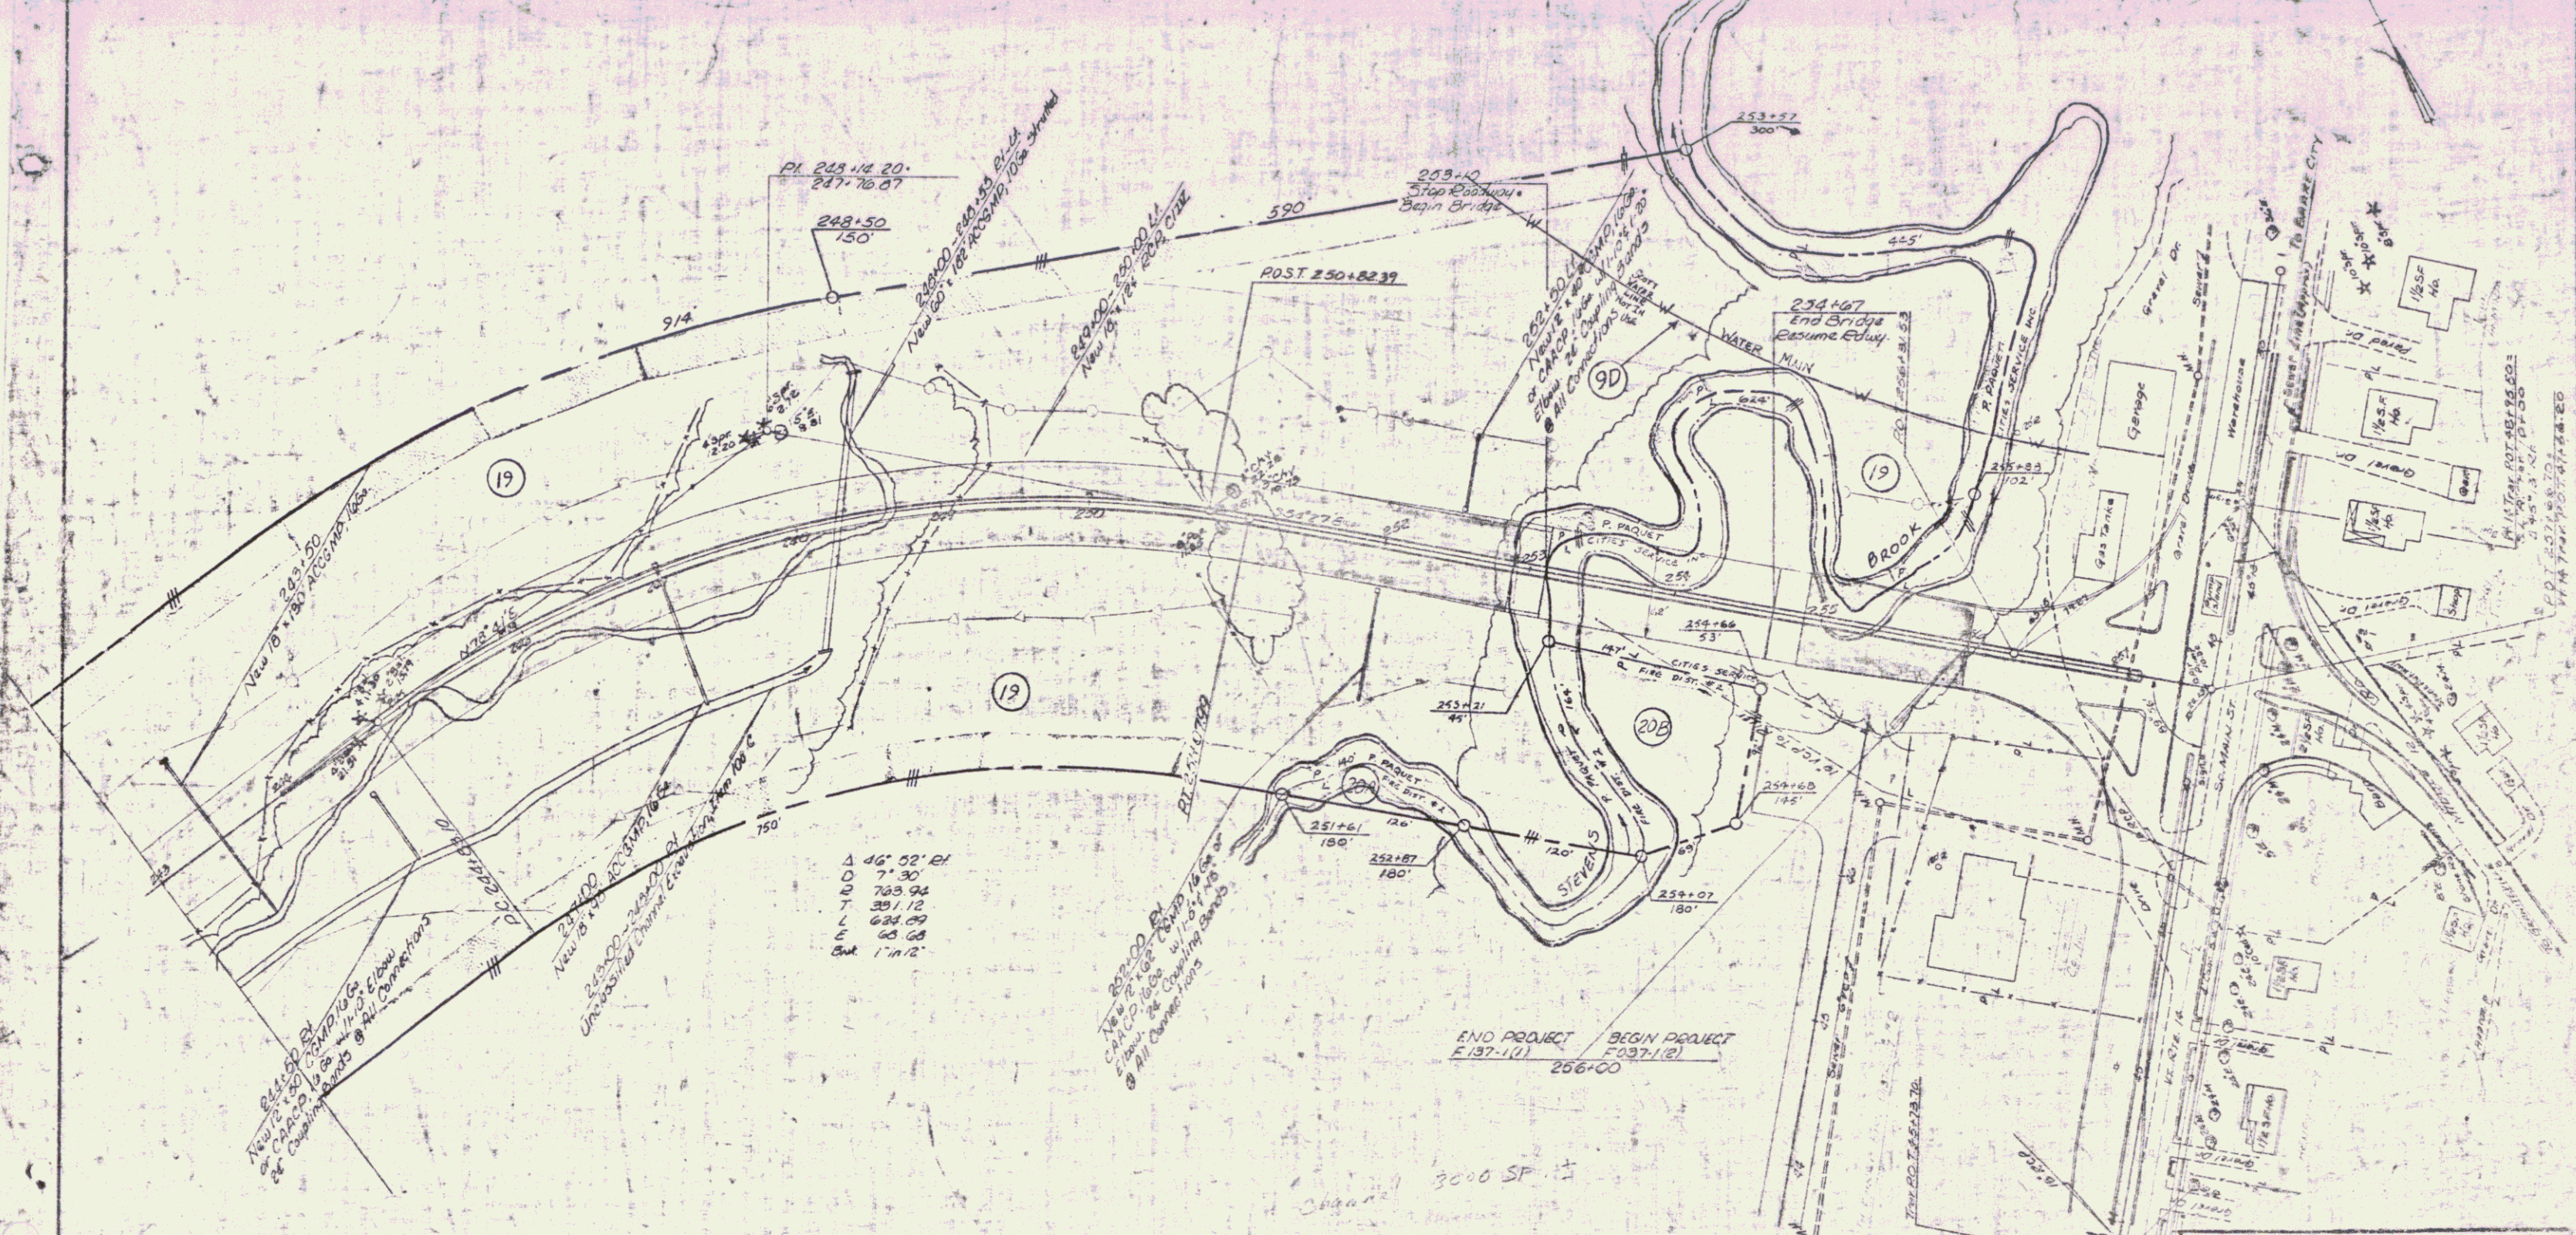

Δ 46° 52' EH
 7' 30"
 But 1" in 12"

CONTROL OF ACCESS IS COMPLETE ON THIS SHEET

* DENOTES STAGE II ITEMS

VERMONT DEPARTMENT OF HIGHWAYS
 RIGHT-OF-WAY PLANS
 PROJECT BERLIN-BARRE
 NO. F137-1(1)
 SHEET 24 OF 55