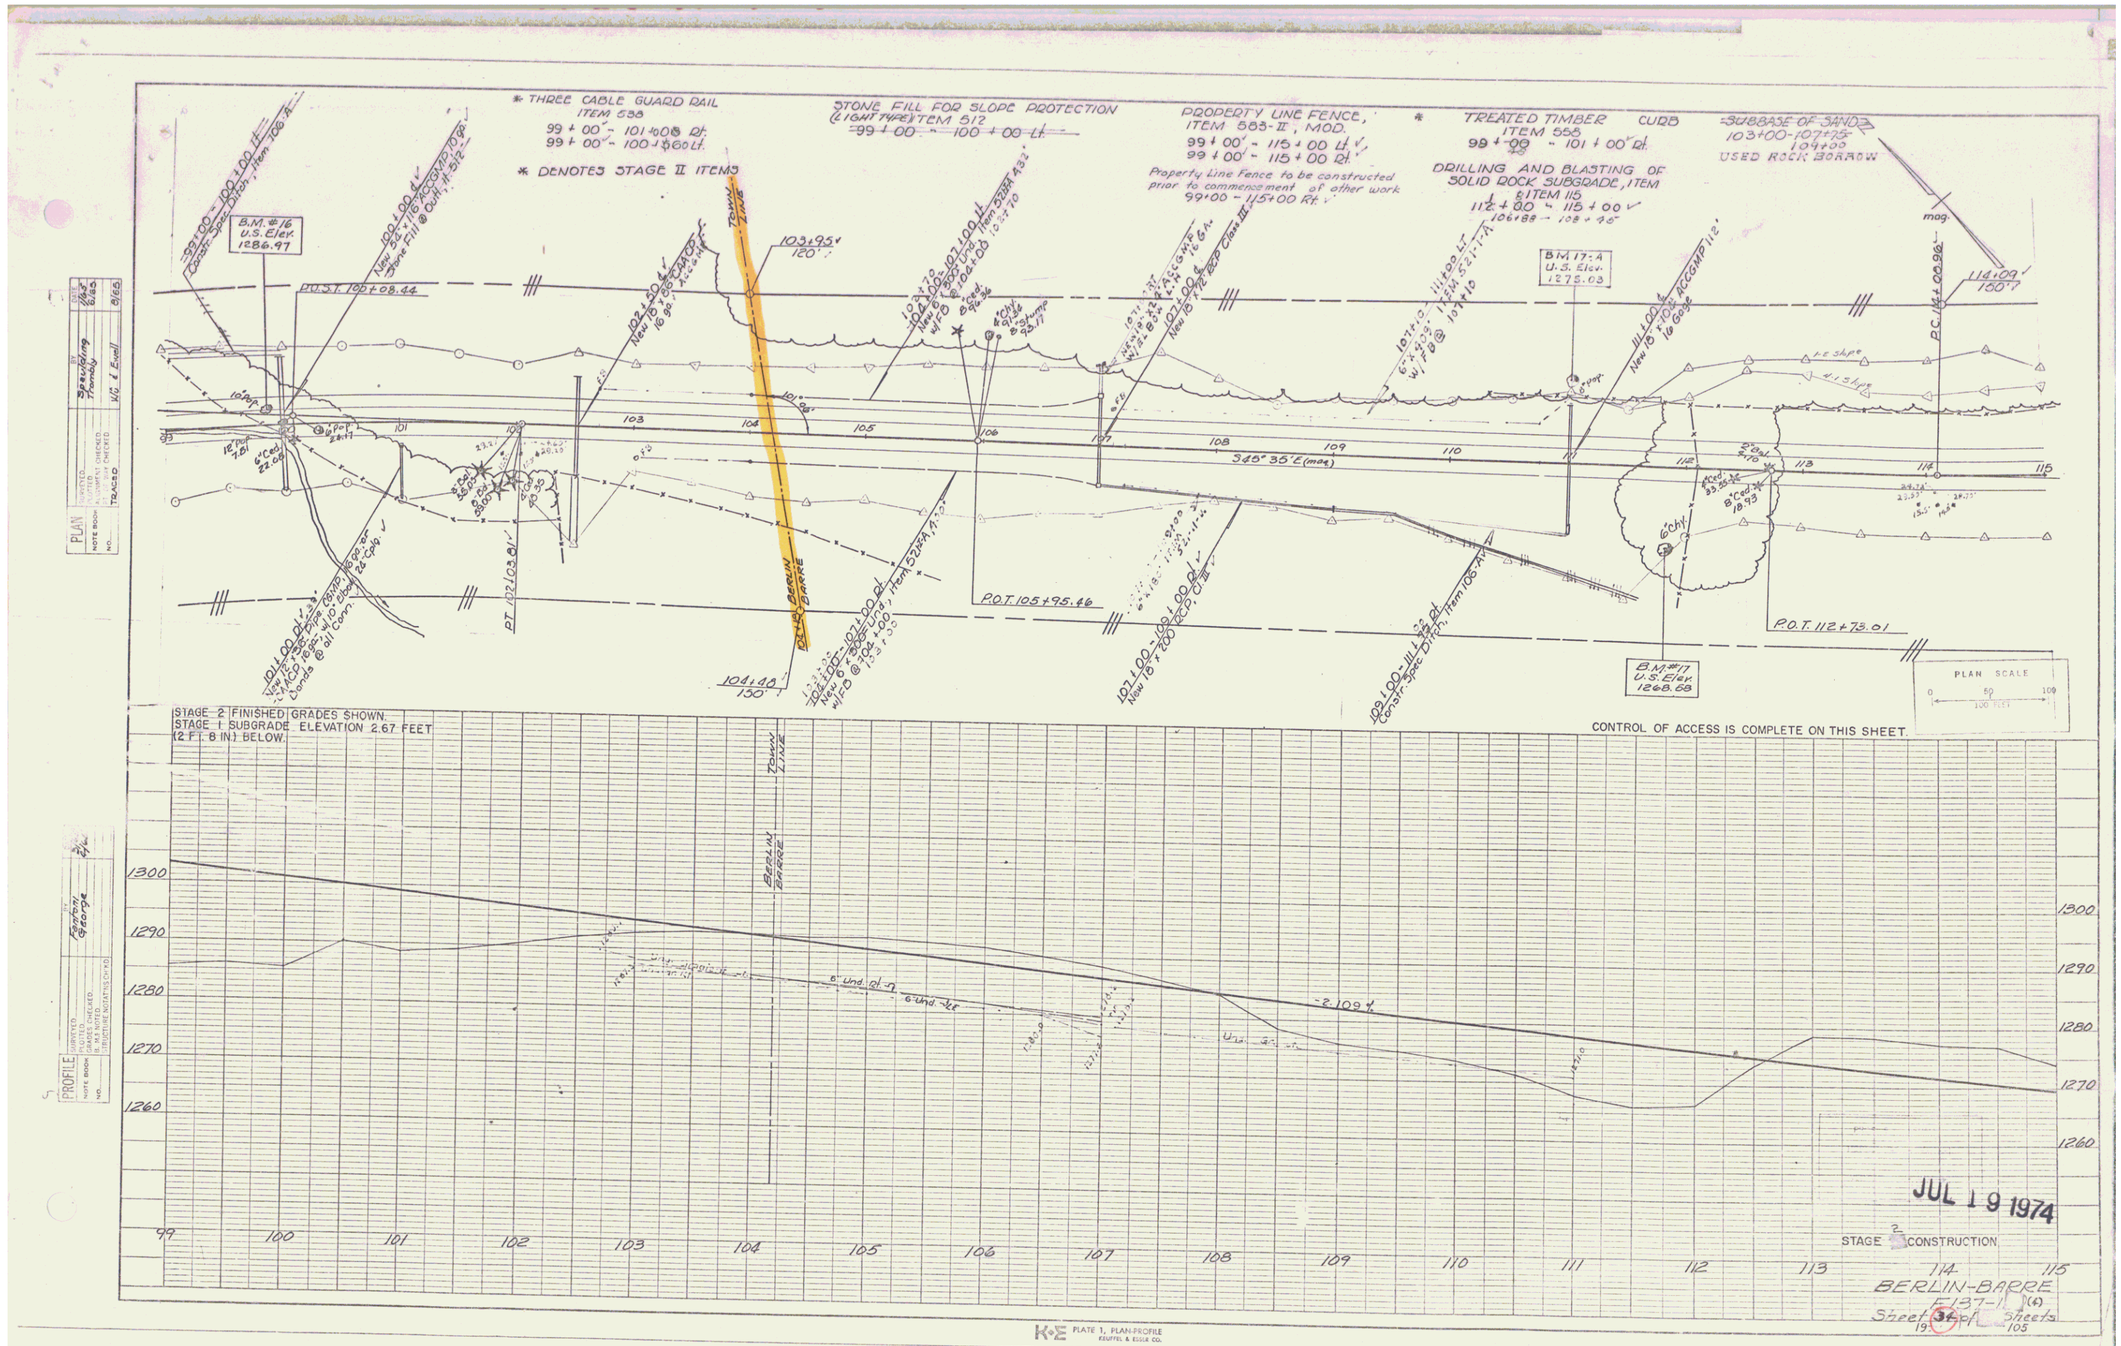

PLAN
NOTE BOOK
NO.
SURVEYED
PLOTTED
ALIGNMENT CHECKED
GRADES CHECKED
STRUCTURE NOTATIONS CHKD.
TRACED
8/66
K.G. & Ewell

PROFILE
NOTE BOOK
NO.
SURVEYED
PLOTTED
GRADES CHECKED
STRUCTURE NOTATIONS CHKD.
Robert George

K+E PLATE 1, PLAN-PROFILE
KEUFFEL & ESSER CO.
46 7012 IMPERIAL™ TRACING CLOTH

23