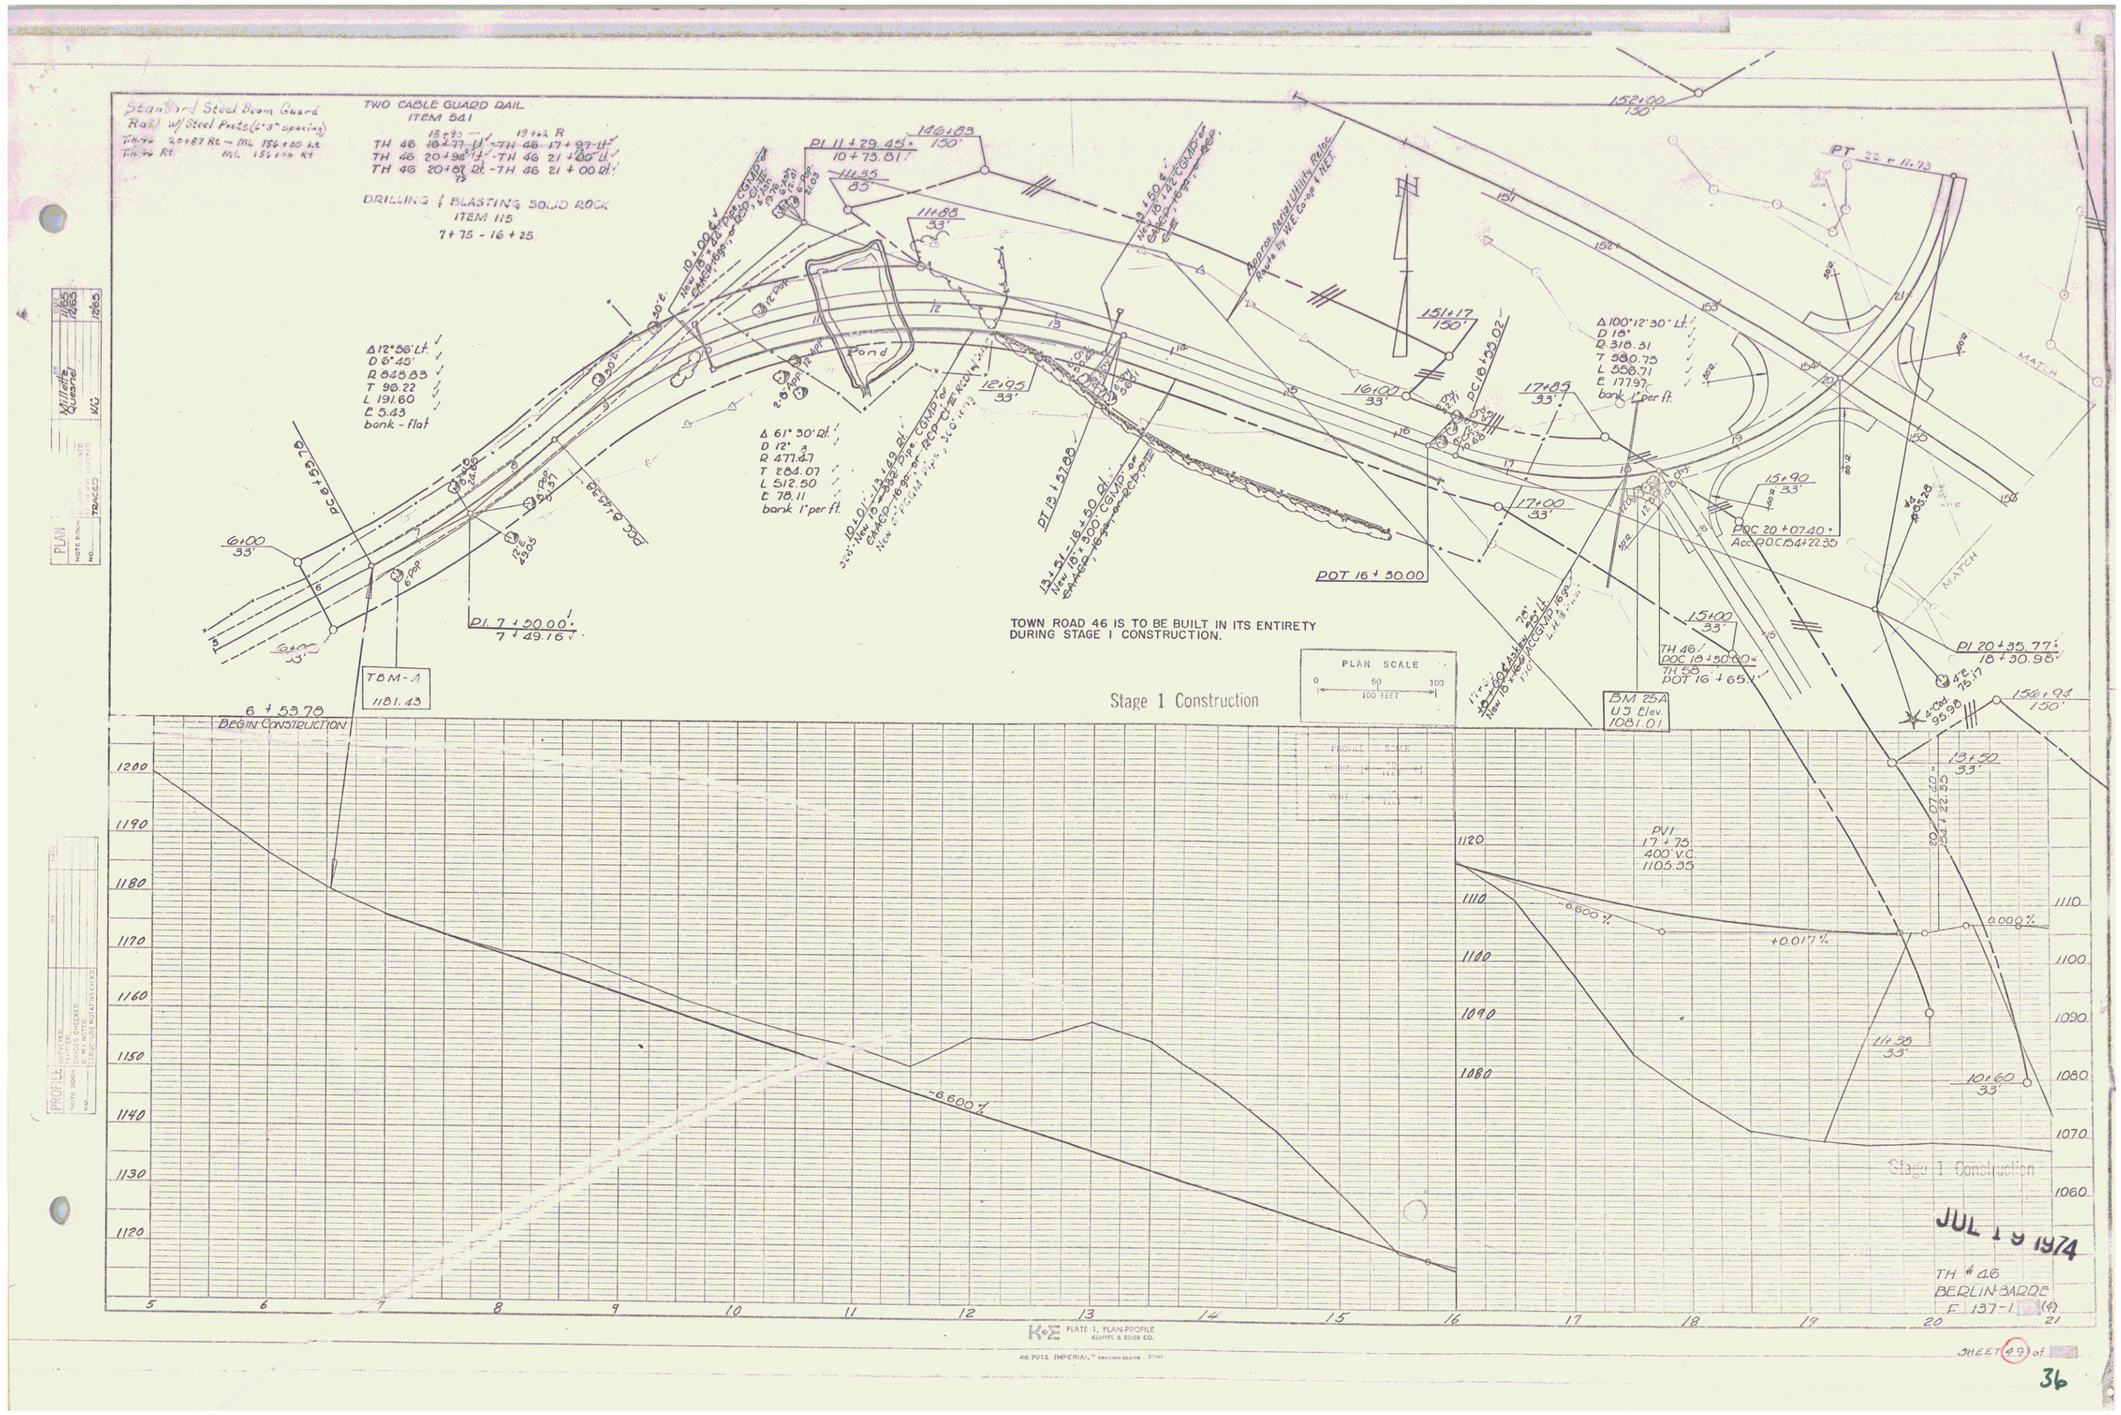
Standard Steel Beam Guard Rail w/Steel Posts (6'-3" spacing)
TWO CABLE GUARD RAIL
ITEM 641
DRILLING & BLASTING SOLID ROCK
ITEM 115
7+75 - 16+25
Δ 12°56' Lt.
D 6°45'
R 848.83
T 96.22
L 191.60
E 5.43
bank - flat
Δ 61°30' Rt.
D 12°
R 477.47
T 284.07
L 512.50
E 70.11
bank 1' per ft.
Pond
PI 11+29.45
10+73.81
PI 7+50.00
7+49.16
TBM-A
1181.43
6+53.78
BEGIN CONSTRUCTION
TOWN ROAD 46 IS TO BE BUILT IN ITS ENTIRETY
DURING STAGE I CONSTRUCTION.
Stage 1 Construction
PLAN SCALE
0 50 100
100 FEET
POT 16+50.00
PT 13+51.85
Approx. Depth Utility Relocs. Avail. by W.E. 6-29-74
Δ 100°12'30" Lt.
D 18°
R 318.31
T 380.73
L 558.71
E 177.97
bank 1' per ft.
PI 20+35.77
18+30.98
BM 25A
US Elev.
1081.01
PVI
17+75
400' V.C.
1105.35
-6.600%
+0.017%
0.008%
Stage 1 Construction
JUL 1 9 1974
TH #46
BERLIN-BARDE
F 137-1 (4)
SHEET 49 of
36