


PLAN	DATE
NO. 1	
BY	
CHECKED	
APPROVED	
DATE	
PROJECT	
DESCRIPTION	

PROFILE	DATE
NO. 1	
BY	
CHECKED	
APPROVED	
DATE	
PROJECT	
DESCRIPTION	

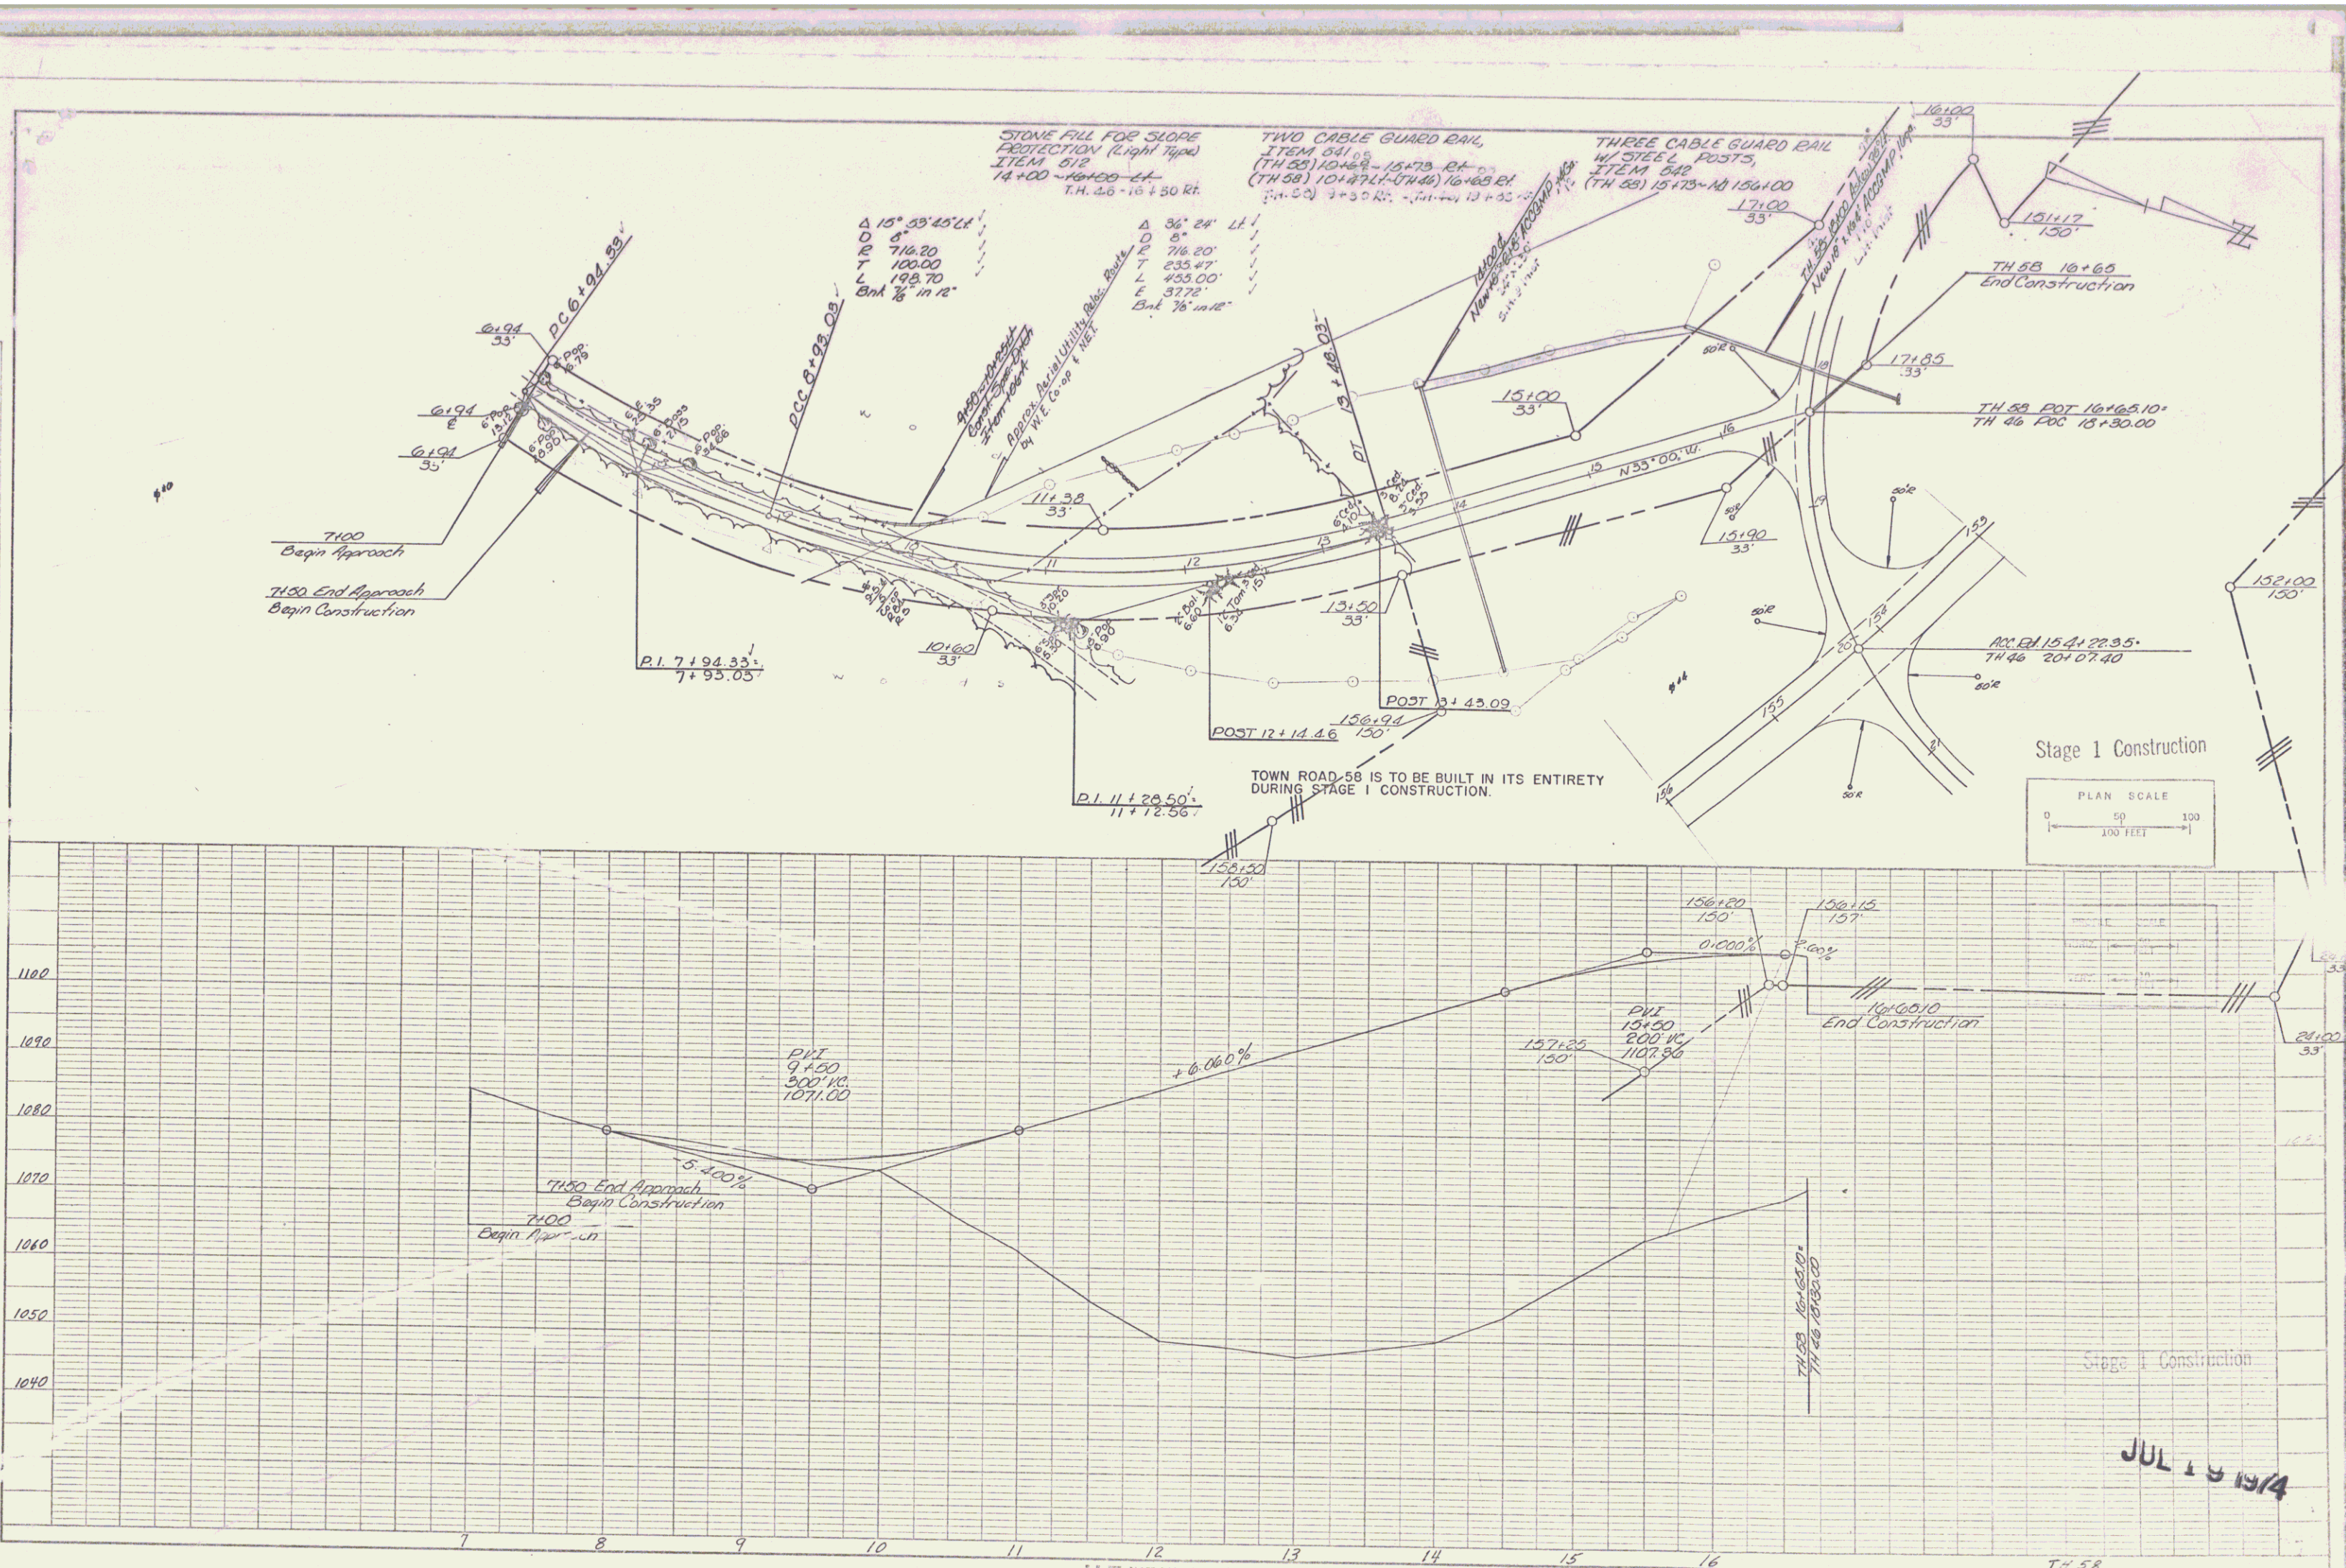

Stage 1 Construction

PLAN SCALE
0 50 100
100 FEET

JUL 18 1974