
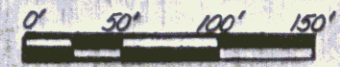


ACQUIRED FROM O. RICHARD CLARK AND ANITA D. CLARK BY W.D.O.E. DATED 7-29-80 AND RECORDED ON 8-11-80 IN BK 47 ON PG. 13 OF THE BERLIN LAND RECORDS

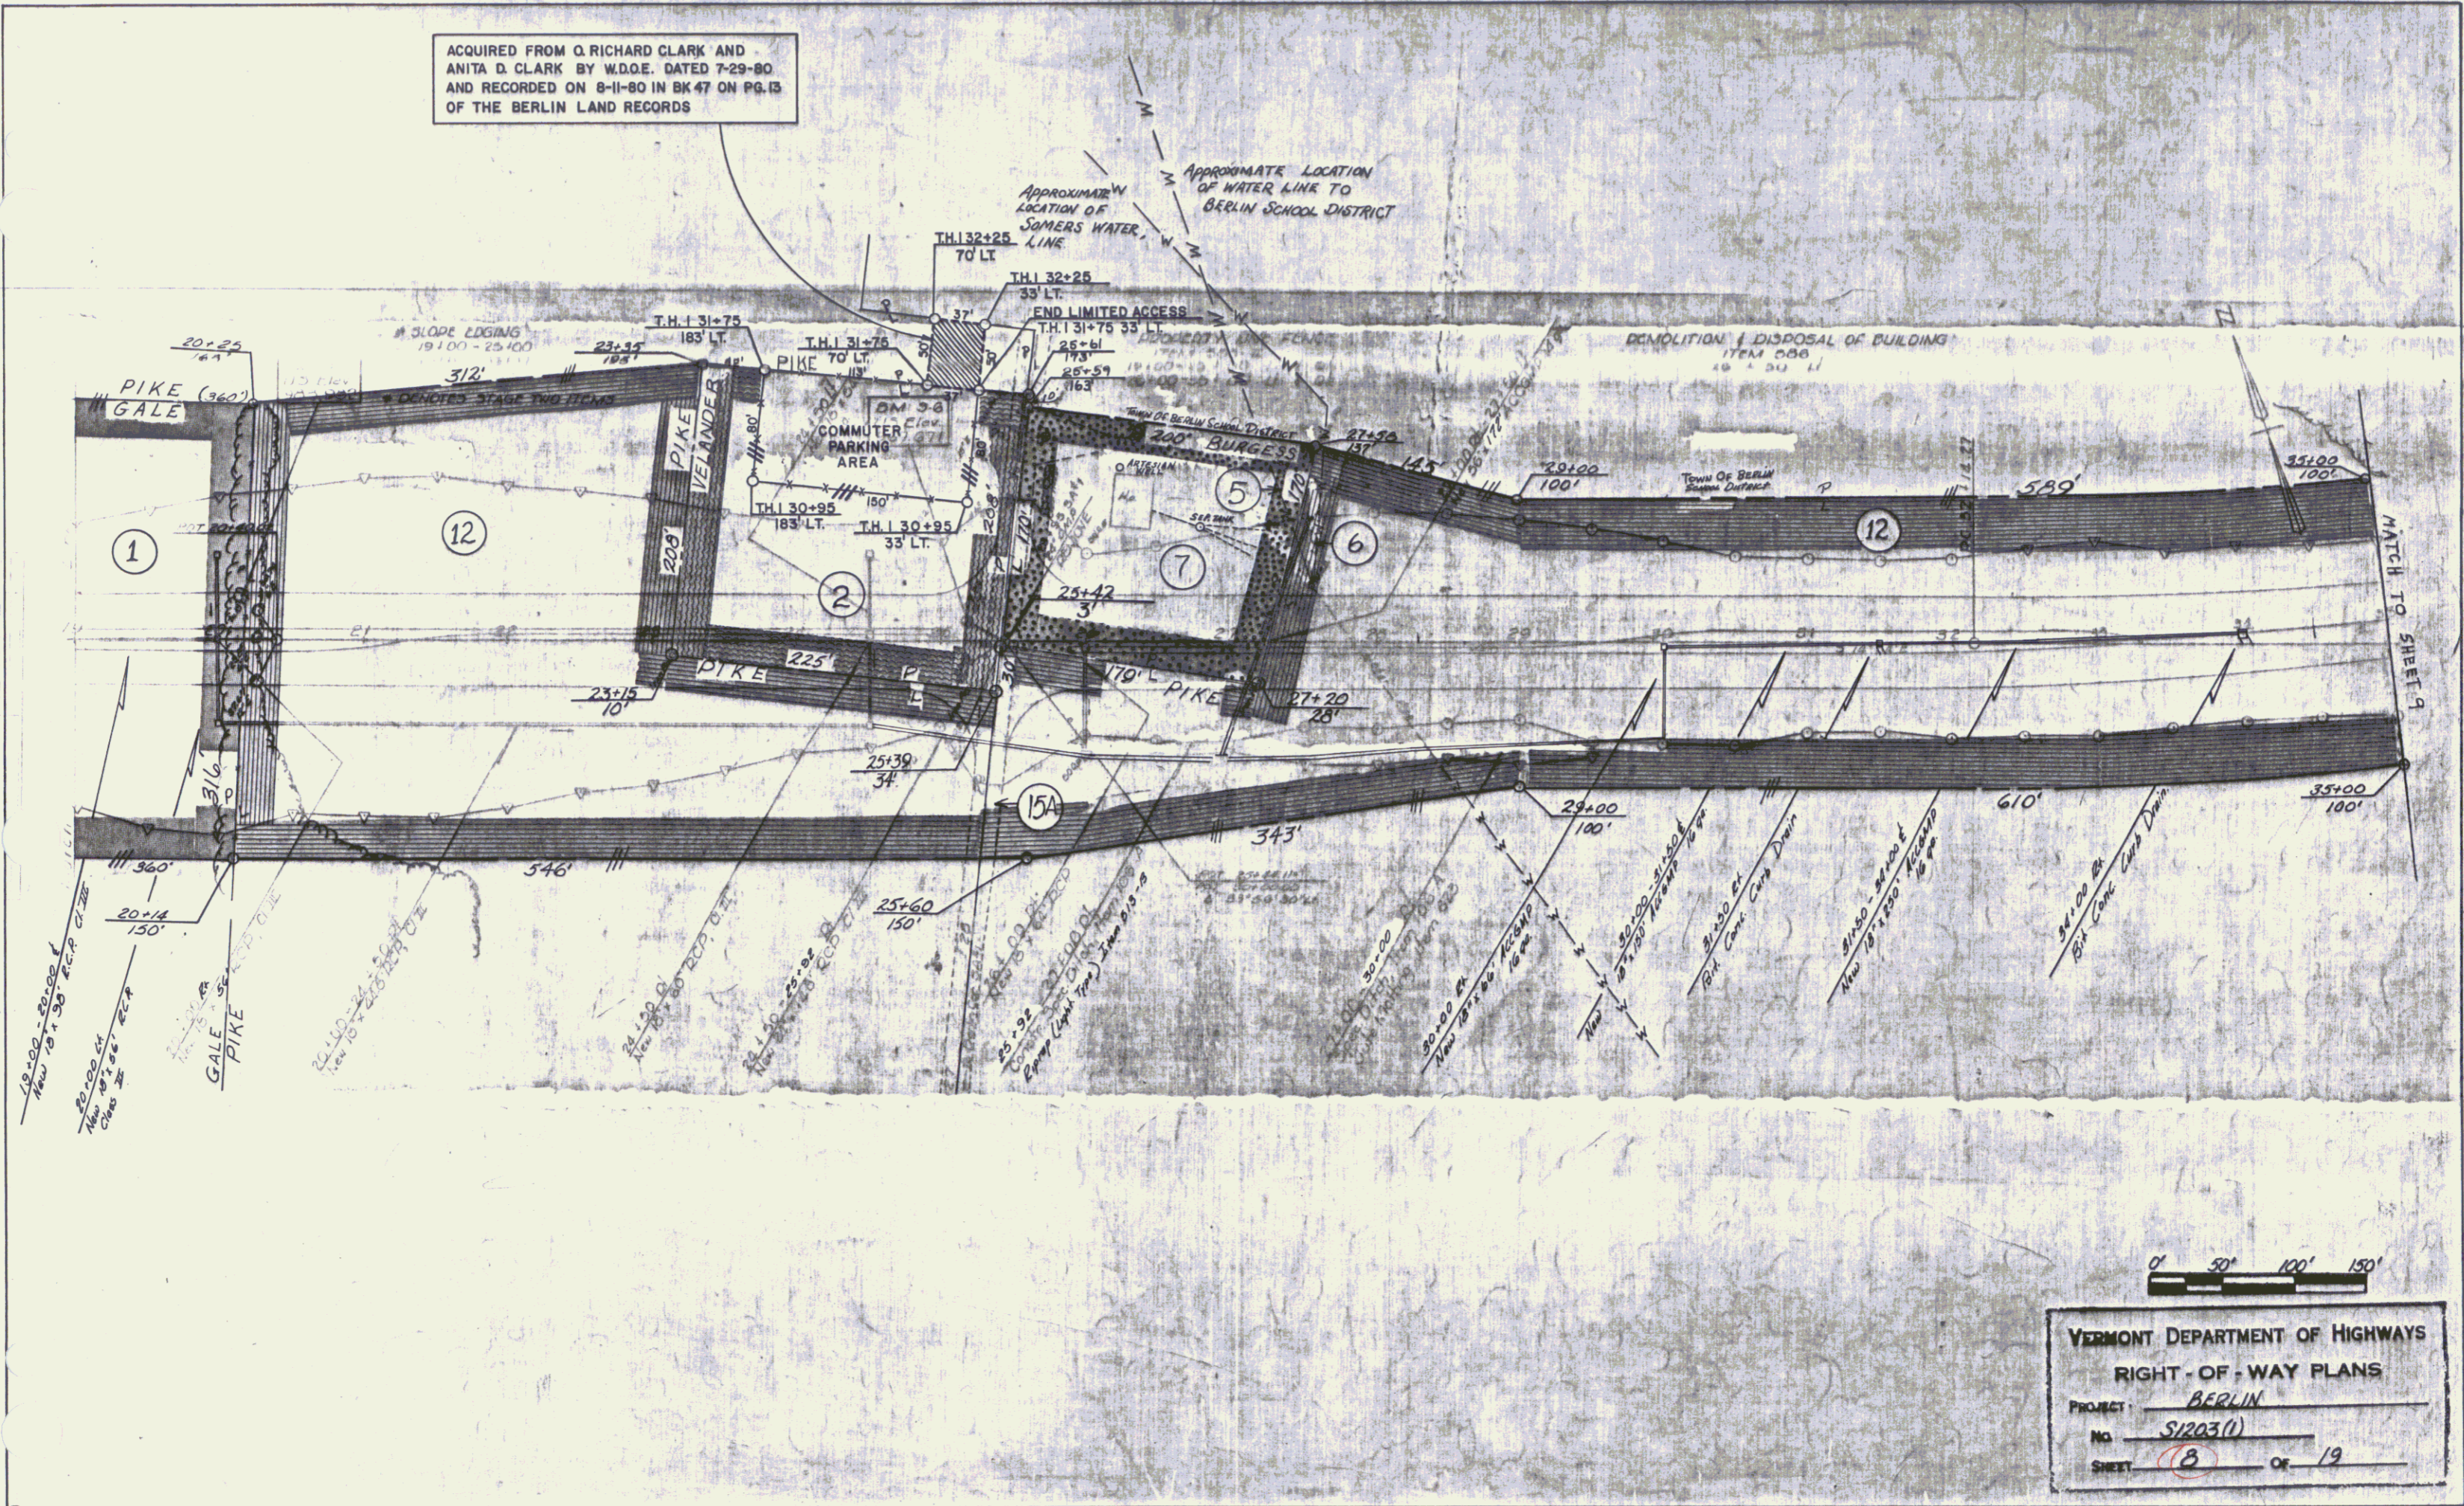

VERMONT DEPARTMENT OF HIGHWAYS
 RIGHT-OF-WAY PLANS
 PROJECT: BERLIN
 NO. S1203(1)
 SHEET 8 OF 19