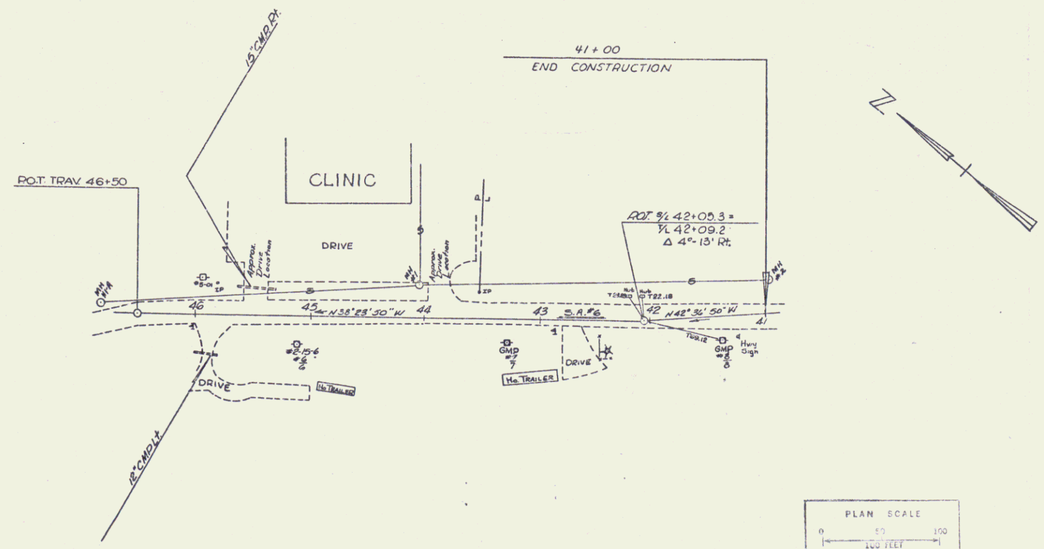

PLAN SCALE
0 50 100
100 FEET

PROFILE SCALE
HORIZ.
VERT.

46 45 44 43 42 41

BERLIN
F126-1(8)
S.A. #6
sheet 30 of 341

20