

**CONSTRUCTION NOTES**  
 Drives Are To Be Constructed To A Minimum Width of 12 Feet With A Minimum Radius of 20 Feet On The Flare Or As Indicated On The Plans or As Directed By The Engineer.

TREATED TIMBER CURB LT. 0  
 39120-4100 RT.  
 CONSTRUCT SPECIAL DITCH (to be Paid Under Item 203.15)  
 LT. 61 RT. 1  
 46+80 39100 41+73

CONSTRUCT DRIVE LT. 61 RT. 1  
 46+80 39100 41+73

CONSTRUCT APPROACH LT. RT.  
 45+50 39100  
 44+69 42+00  
 Drive approaches to a pt. opposite S.W. Corner of Congregational Church

STONE FILL, TYPE II LT. RT.  
 38160-40+89

DEMOLITION & DISPOSAL OF BUILDING LT. RT.  
 46150 (Rt.)

STONE FILL, TYPE I LT. RT.  
 47100 - 47+75

UNCLASSIFIED CHANNEL EXCAVATION LT. RT.  
 38160-40+89

GUARD RAIL, THREE CABLE w/ 11 Wood Posts LT. RT.  
 37+20-43+40 (12'-0" Spacing)


REVISED CURVE DATA  
 $\Delta 22^\circ 41' 34" \text{ Lt}$   
 $D 11^\circ 03' 27" \text{ V}$   
 $R 518.14$   
 $T 104.00$   
 $L 205.28$   
 $E 10.33$   
 Bank 0.063' per Foot V

REVISED CURVE DATA  
 $\Delta 15^\circ 22' 32" \text{ Lt}$   
 $D 10^\circ \text{ V}$   
 $R 572.96$   
 $T 77.34$   
 $L 153.75$   
 $E 5.20$   
 Bank 0.063' per Foot V


REVISED CURVE DATA  
 $\Delta 21^\circ 15' \text{ Rt}$   
 $D 5^\circ \text{ V}$

REVISED CURVE DATA  
 $\Delta 22^\circ 06' 00" \text{ Rt}$   
 $D 5^\circ 30' \text{ V}$   
 $R 1041.74$   
 $T 203.43$   
 $L 401.81$   
 $E 19.68$   
 Bank 0.052' / Ft V

POT 33+01.82  
 Elev. POT 32+95.54  
 EQ +6.26

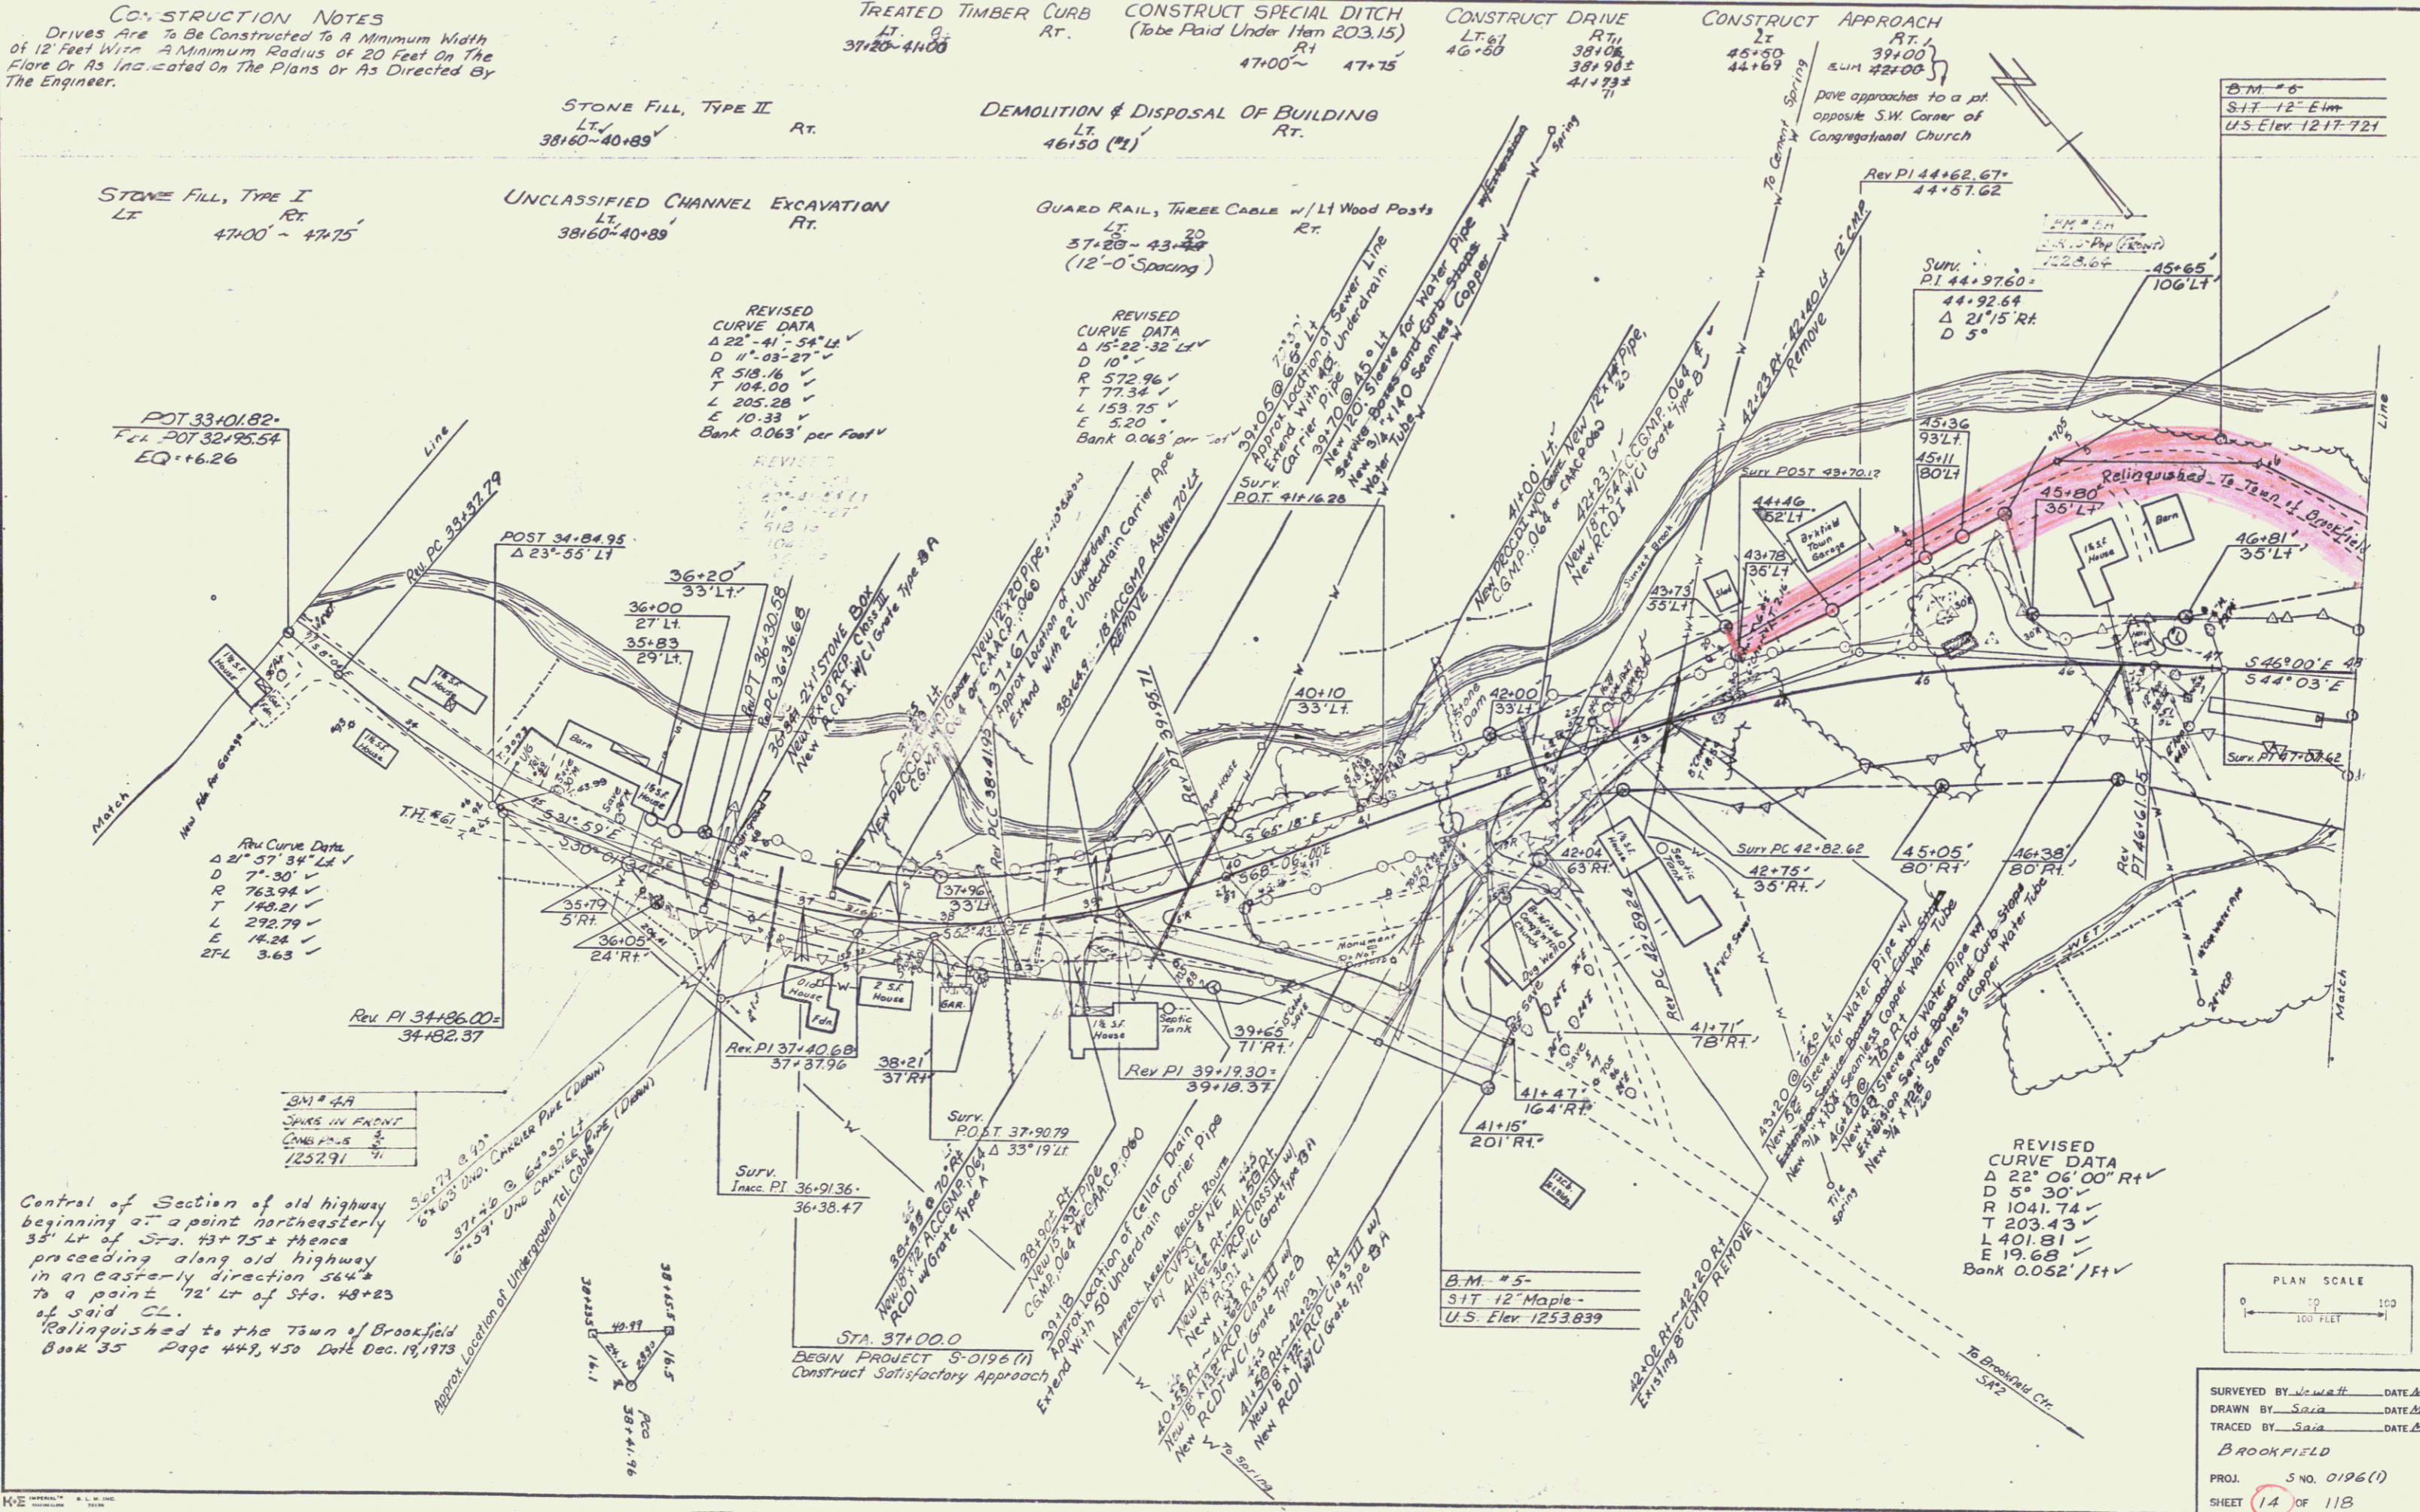

Central of Section of old highway beginning at a point northeasterly 35' Lt of Sta. 43+75 & thence proceeding along old highway in an easterly direction 564' to a point 72' Lt of Sta. 48+23 of said CL.  
 Relinquished to the Town of Brookfield Book 35 Page 449, 450 Date Dec. 19, 1973

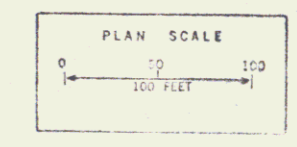

 BROOKFIELD  
 PROJ. S NO. 0196(1)  
 SHEET 14 OF 118