DRILLING AND BLASTING OF SOLID ROCK SUBGRADE 95+25 – 96+75

CONSTRUCT DRIVE
Lt. 94+00 ✓ 104+75 ✓
Rt. 95+50 ✓ 104+75 ✓

GUARD RAIL, THREE CABLE w/LT WOOD POSTS
Lt.
Rt. 98+82 ~ 103+50 (32 / 73)

TREATED TIMBER CURB
Lt.
Rt. 99+82 ~ 103+50 (98+88 / 54)

WOOD GUIDE POSTS (8'-0" SPACING)
Lt. 107+20 ~ 109+00 ✓ (106+94)

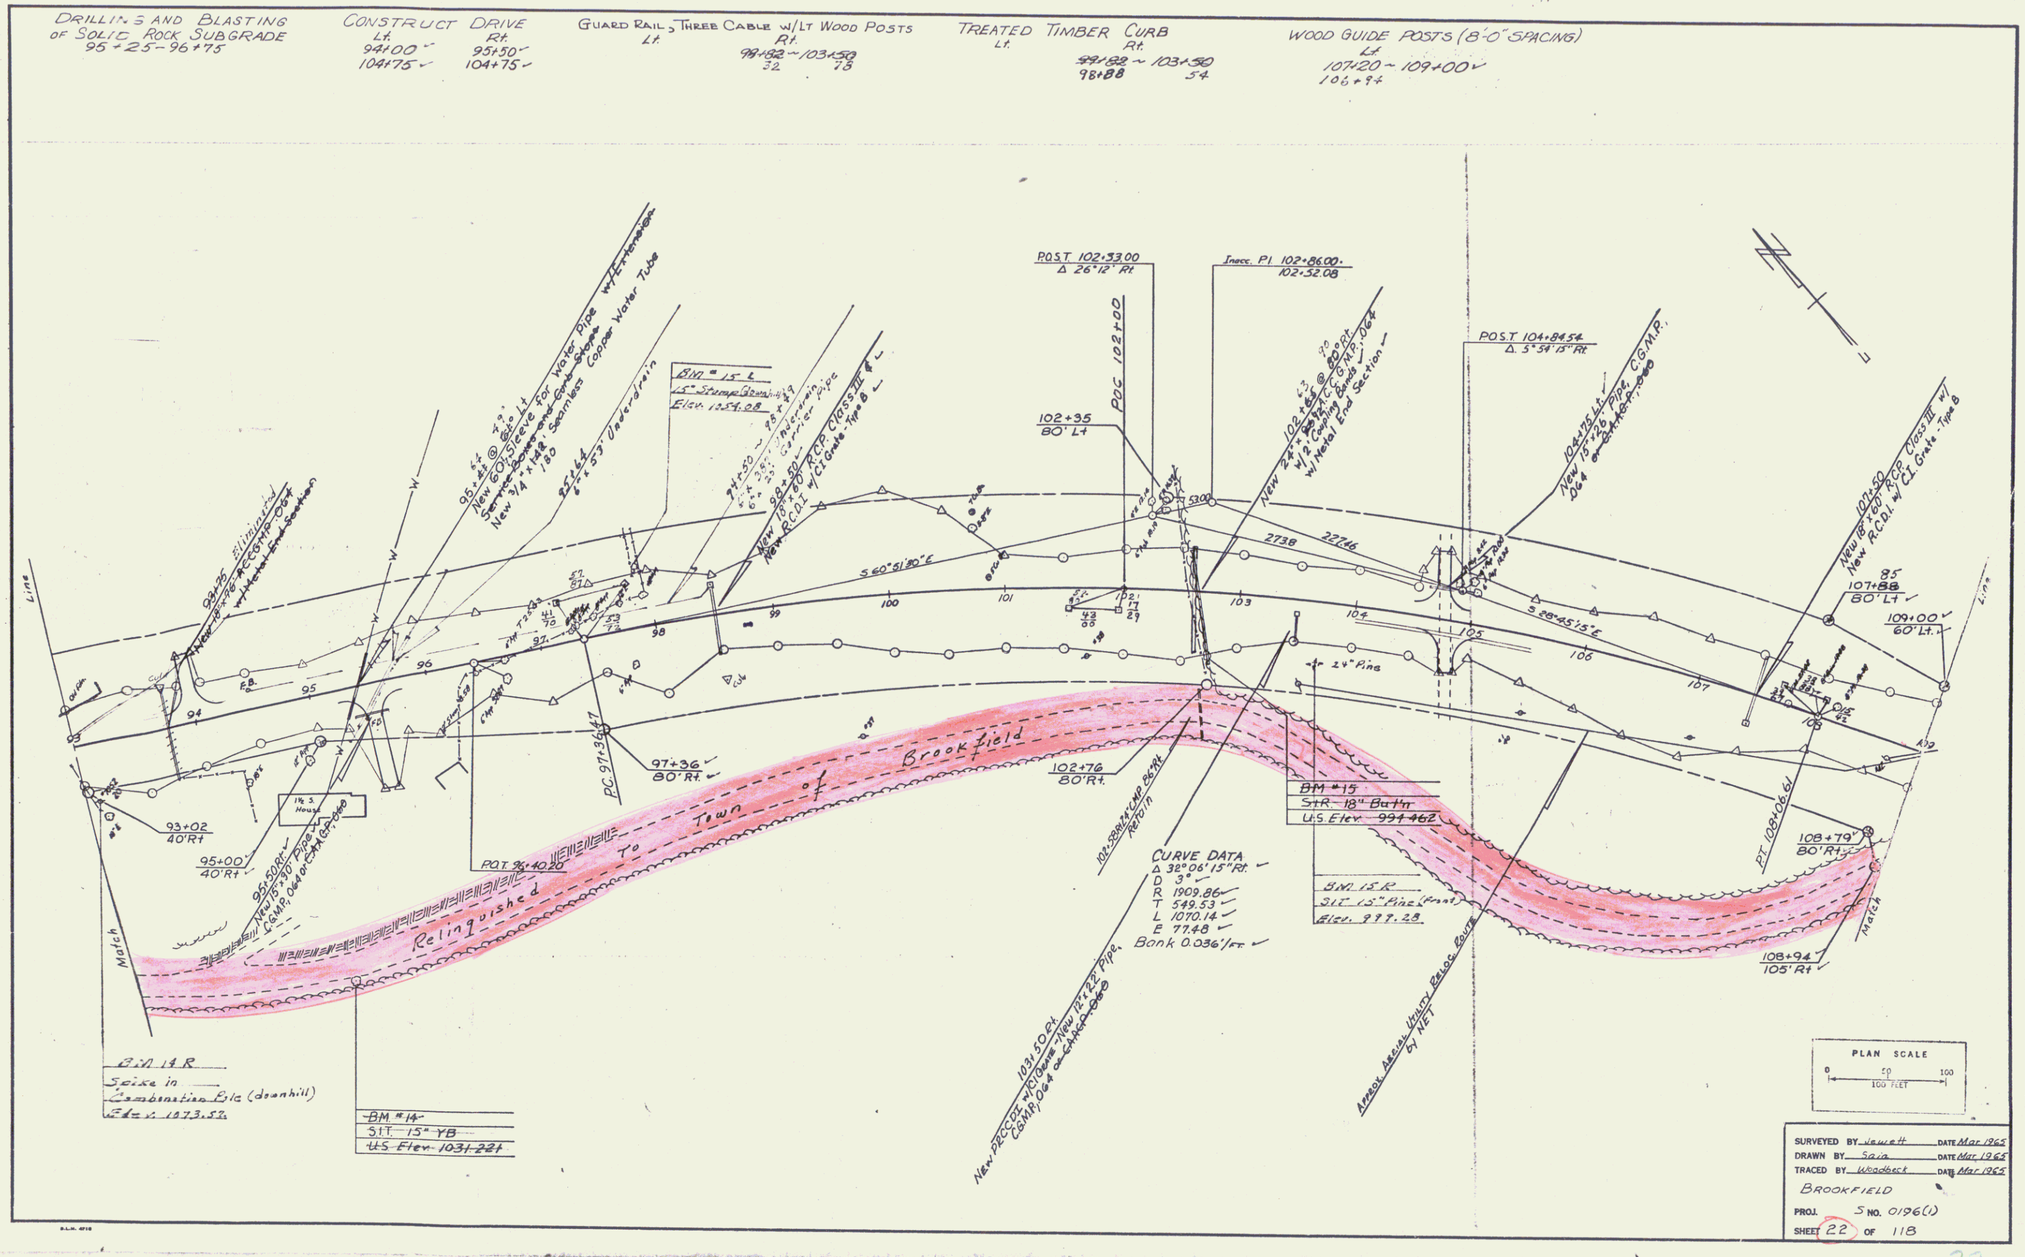

SURVEYED BY Jewett DATE Mar 1965
DRAWN BY Sala DATE Mar 1965
TRACED BY Woodeck DATE Mar 1965
BROOKFIELD
PROJ. S NO. 0196(1)
SHEET 22 OF 118

22