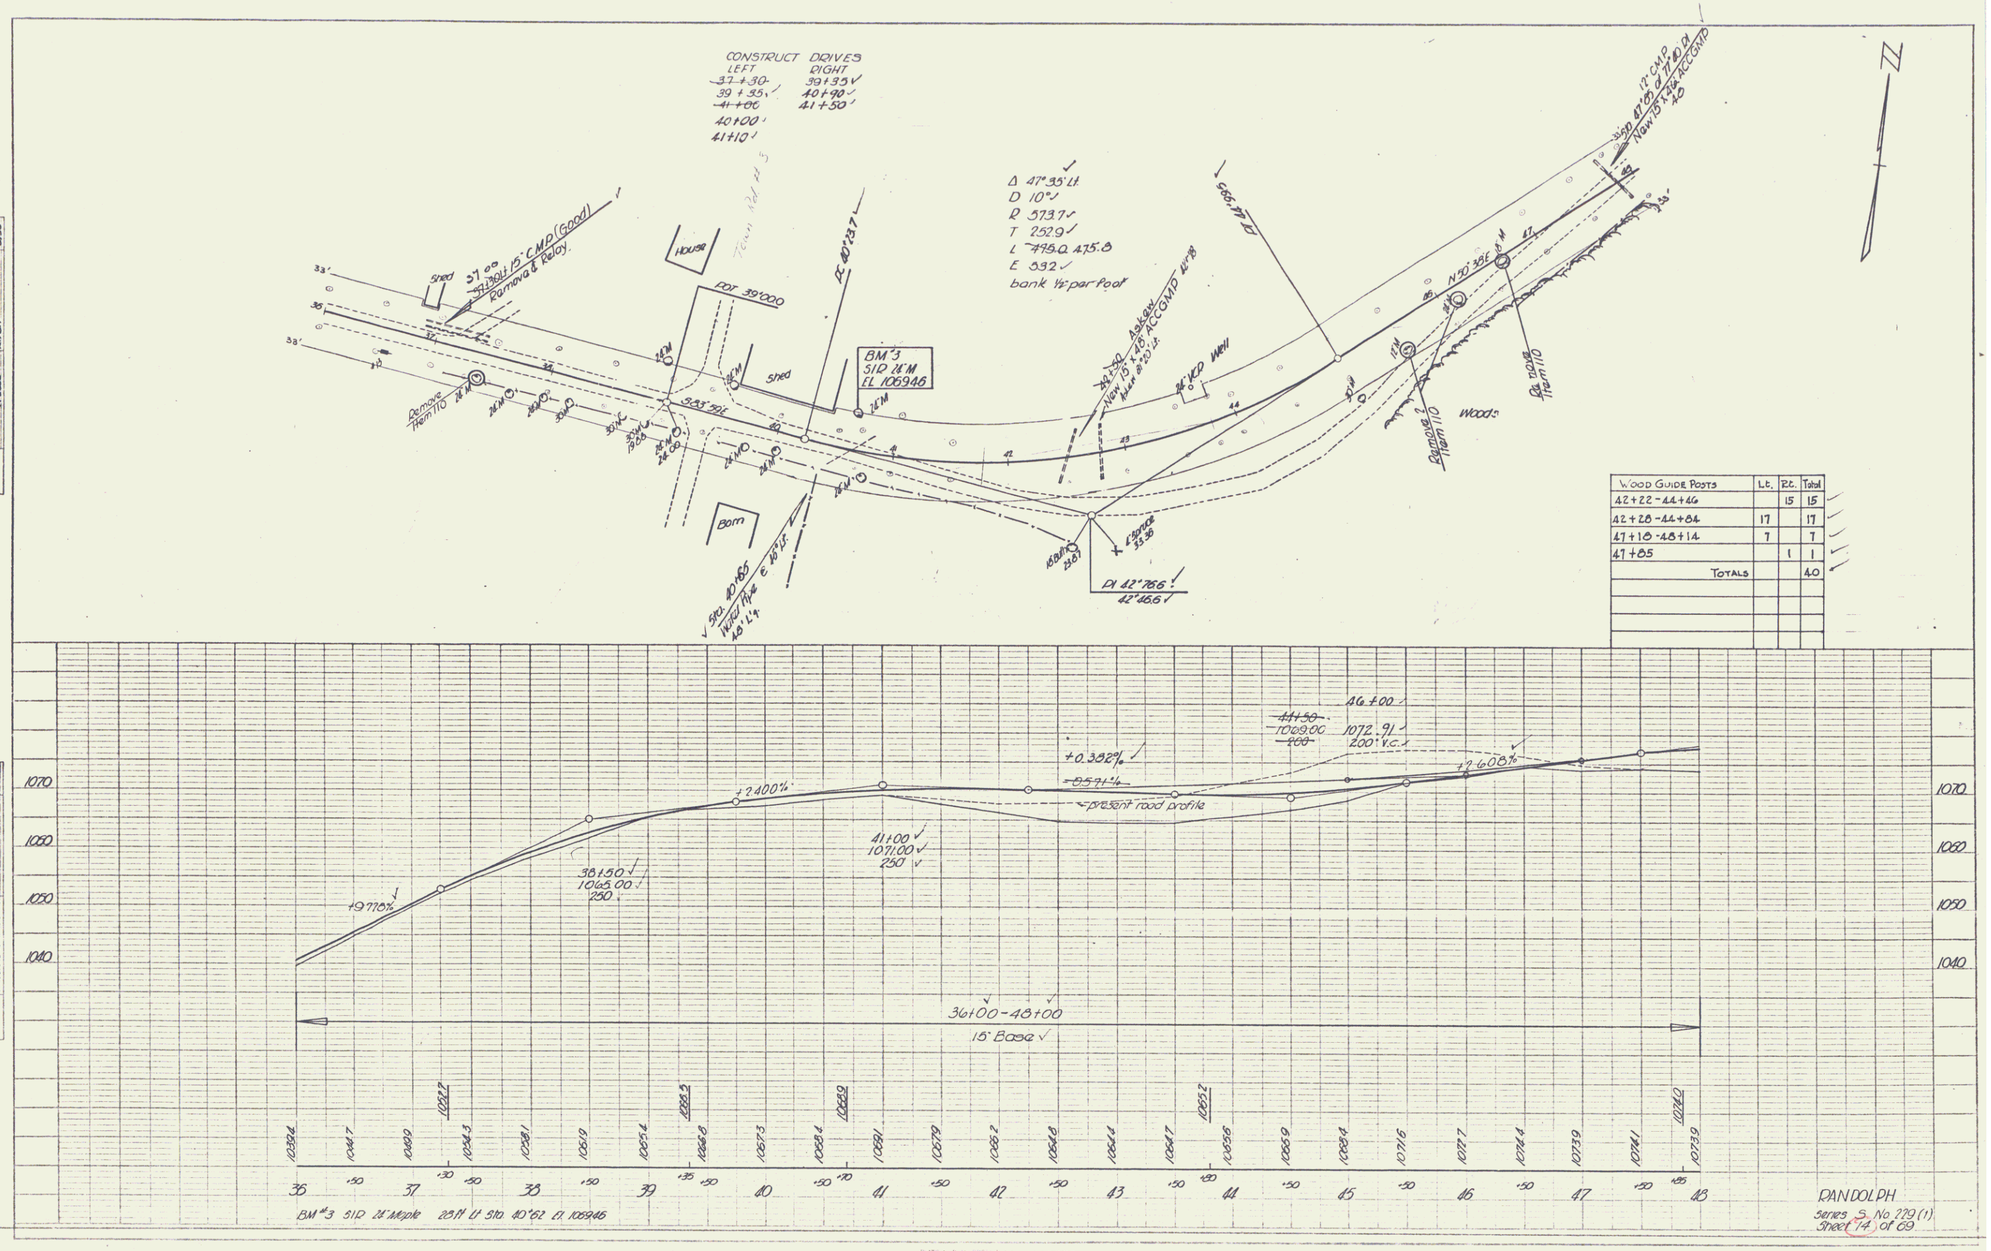

Wood Guide Posts	Lt.	Rt.	Total
42+22 - 44+46		15	15
42+28 - 44+84	17		17
47+18 - 48+14	7		7
47+85		1	1
Totals			40

RANDOLPH
Series S No 279 (1)
Sheet 14 of 69

4